

WESTOVER QUADRANGLE
PENNSYLVANIA - CLEARFIELD CO.
7.5 MINUTE SERIES (TOPOGRAPHIC)

5265 1 NE
(CURWENSVILLE)

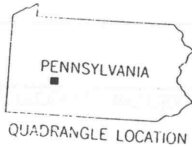
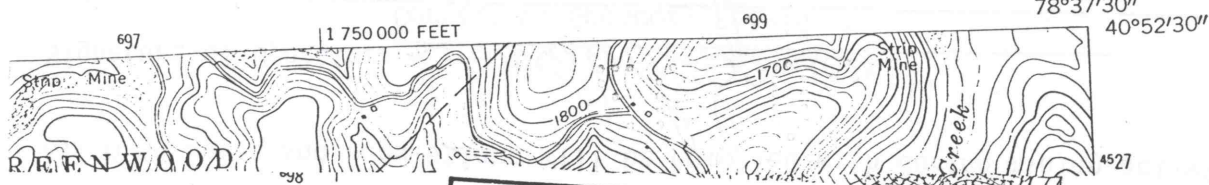


EXHIBIT 6.1 PERMIT AREA
HEPBURNIA COAL COMPANY
RIDDLE MINE
NEW WASHINGTON, NEWBURG BOROS & CHEST TWP., CLEARFIELD CO.


scale: 1"=2000'

Prepared by:
VAPCO ENGINEERING
Rtes. 119 and 210,
Punxsutawney, PA 15767

Signed: *Van G. Plocus*

COMMONWEALTH OF PENNSYLVANIA
REGISTERED PROFESSIONAL ENGINEER
VAN G. PLOCUS
NO 25146E

4527
40°45'
11'30"
(COALPORT)
5265 11 NE

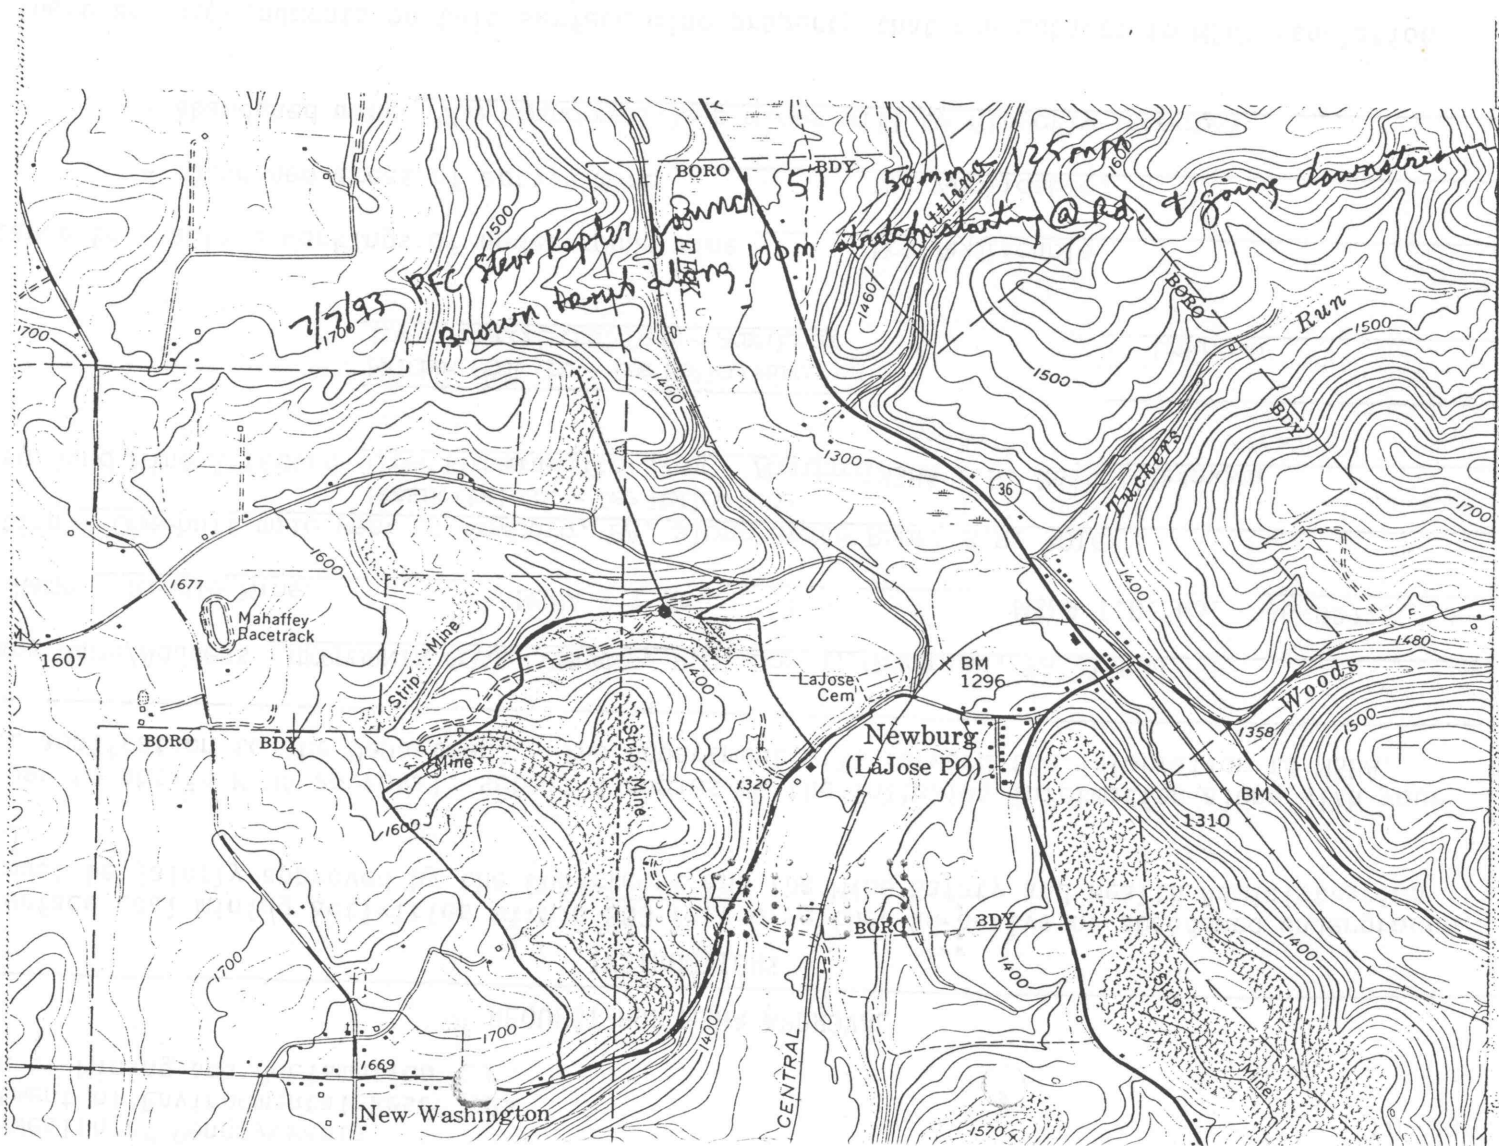

1252