
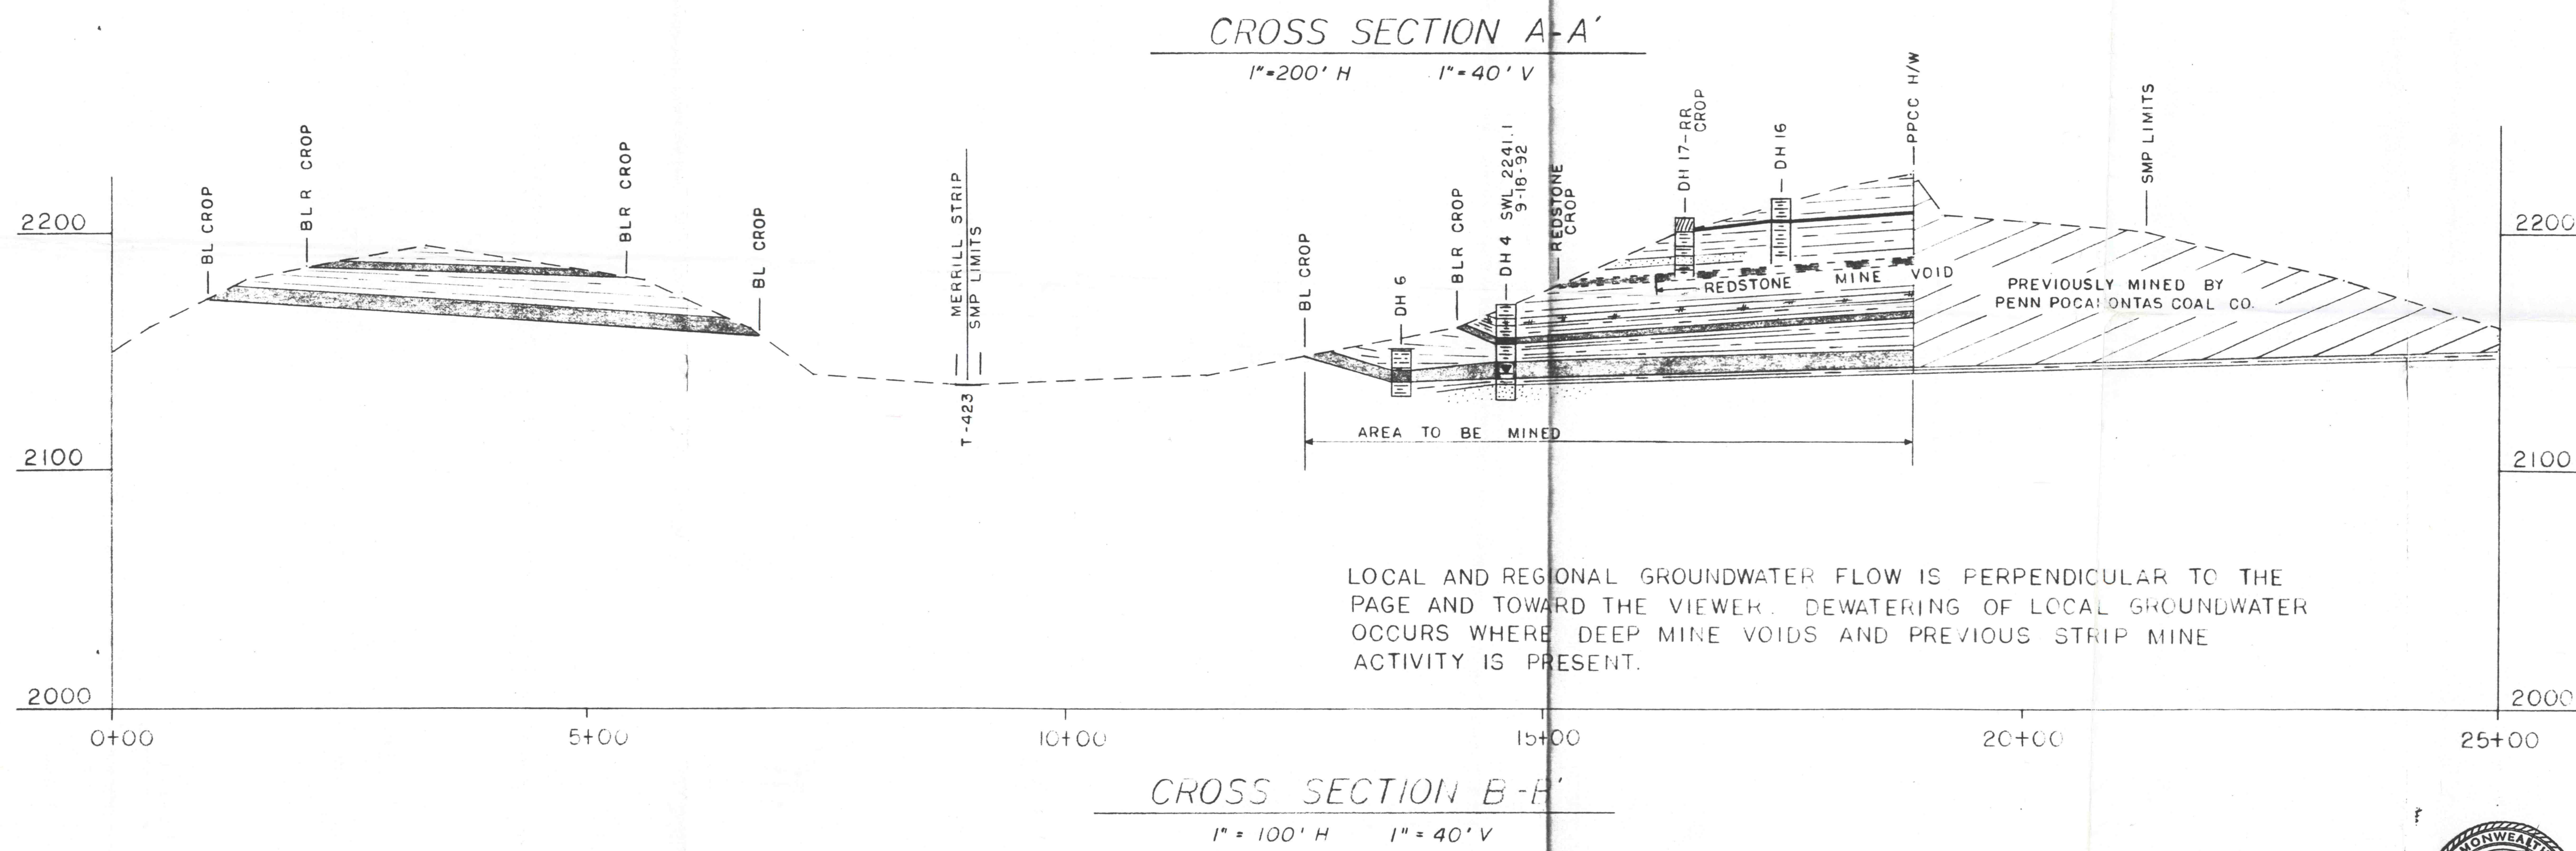


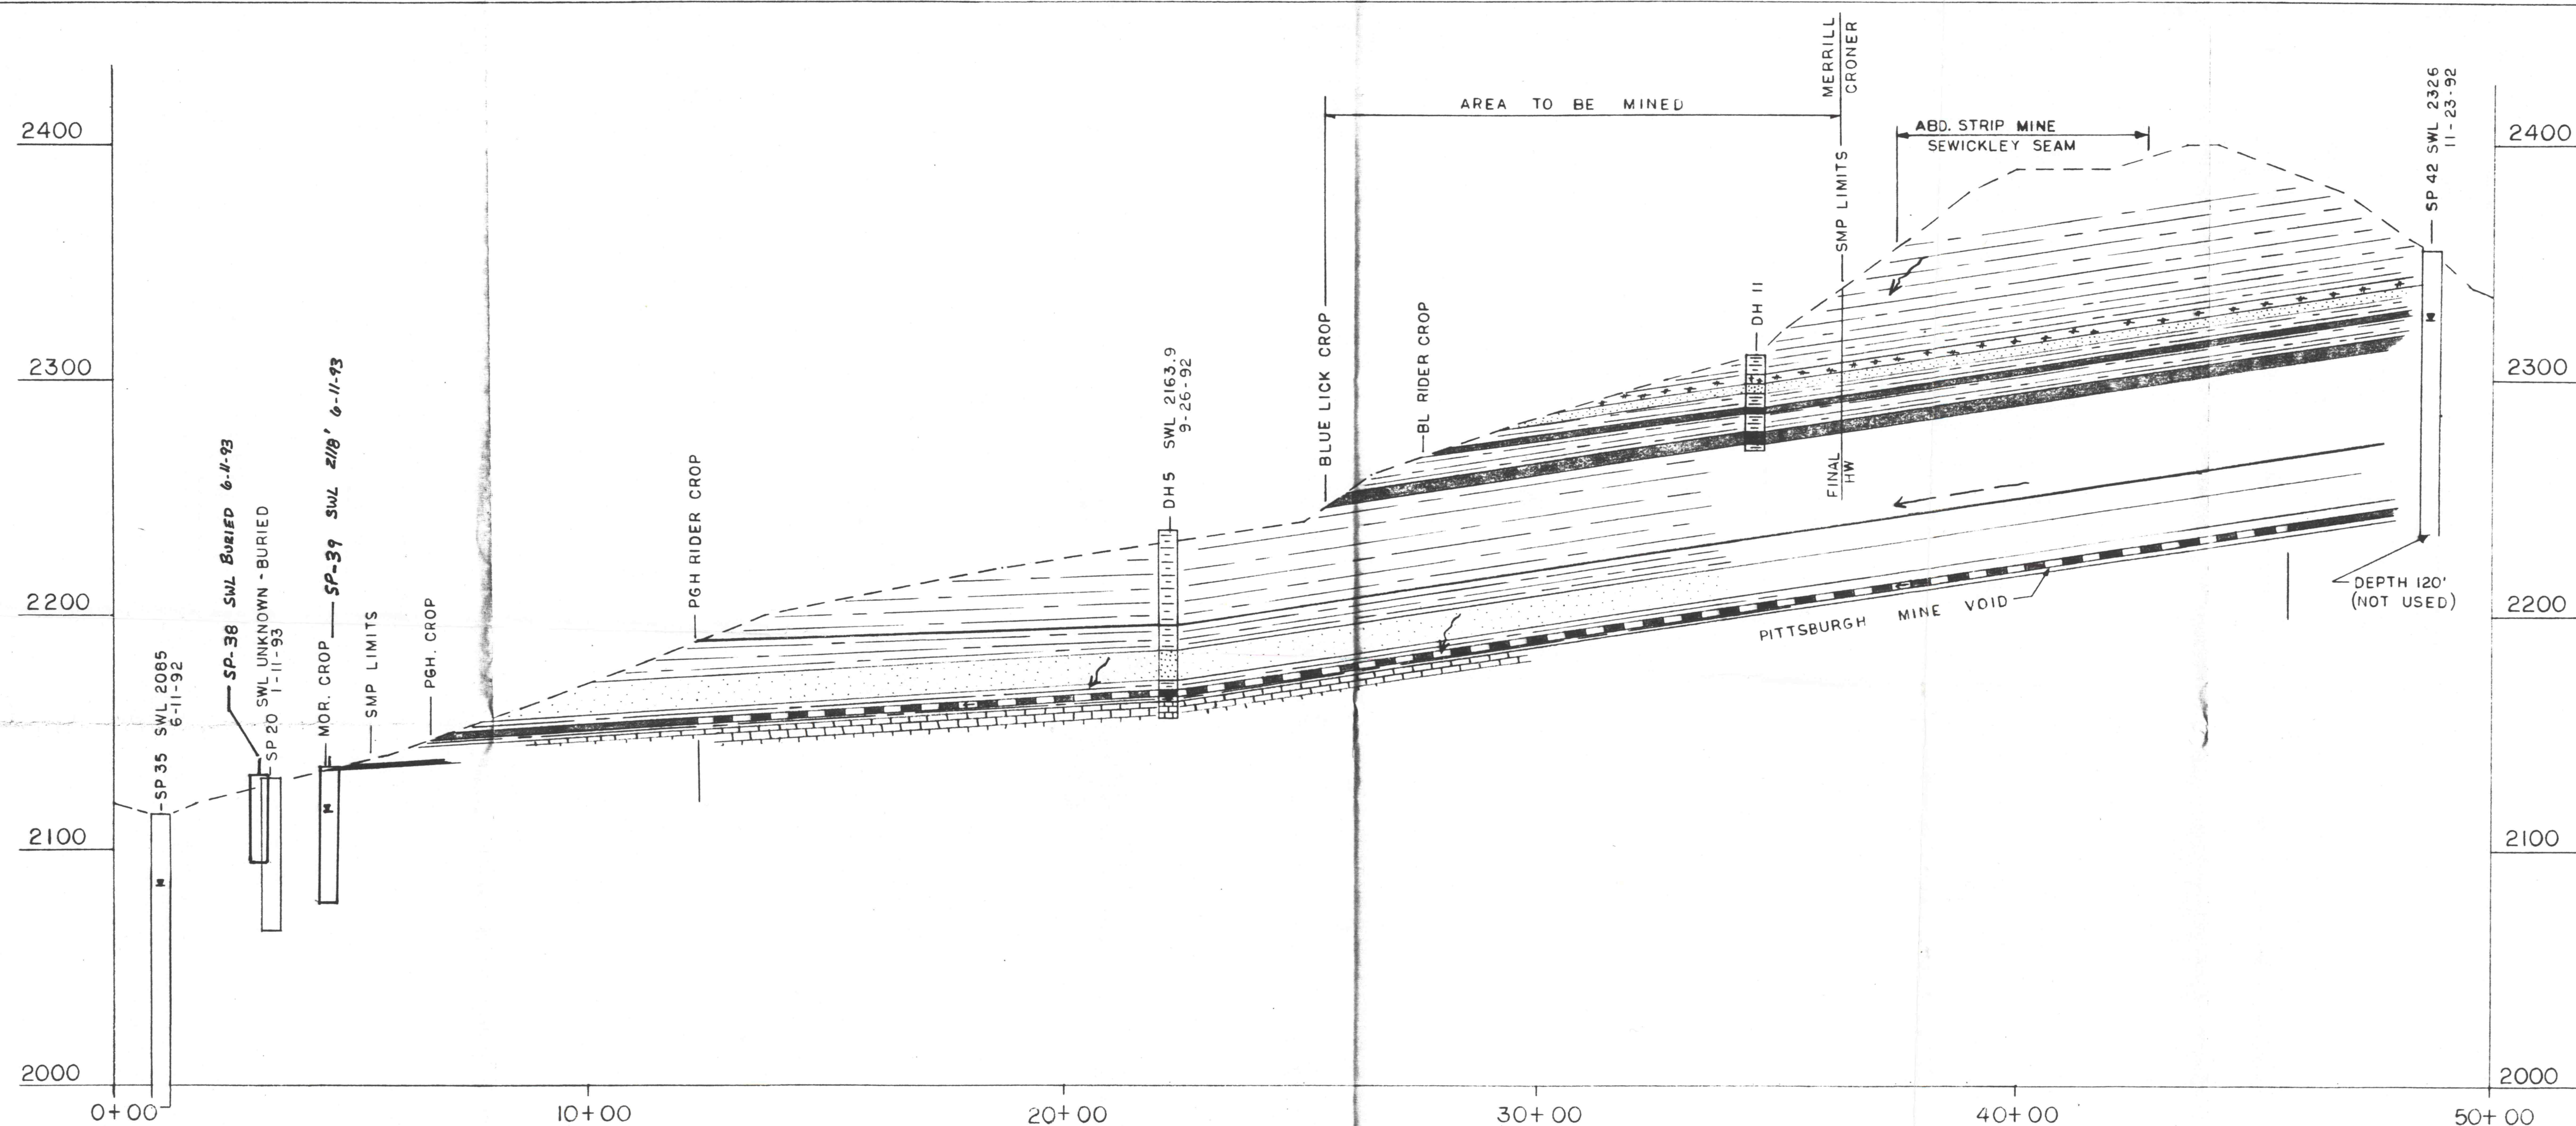

OFFICE

RECEIVED
 JUN 24 1993
 Ebensburg, PA
 Bureau of Mining & Reclamation

FUTURE INDUSTRIES, INC.
LITTLE MERRILL STRIP
GEOLOGIC CROSS SECTIONS

BROTHERSVALLEY TWP **SOMERSET CO.**
RD 1, CENTRAL CITY, PA 15926
MUSSER ENGINEERING, INC.

MEI

JUN 6 1993