


REVISION
12-1
8-8-93

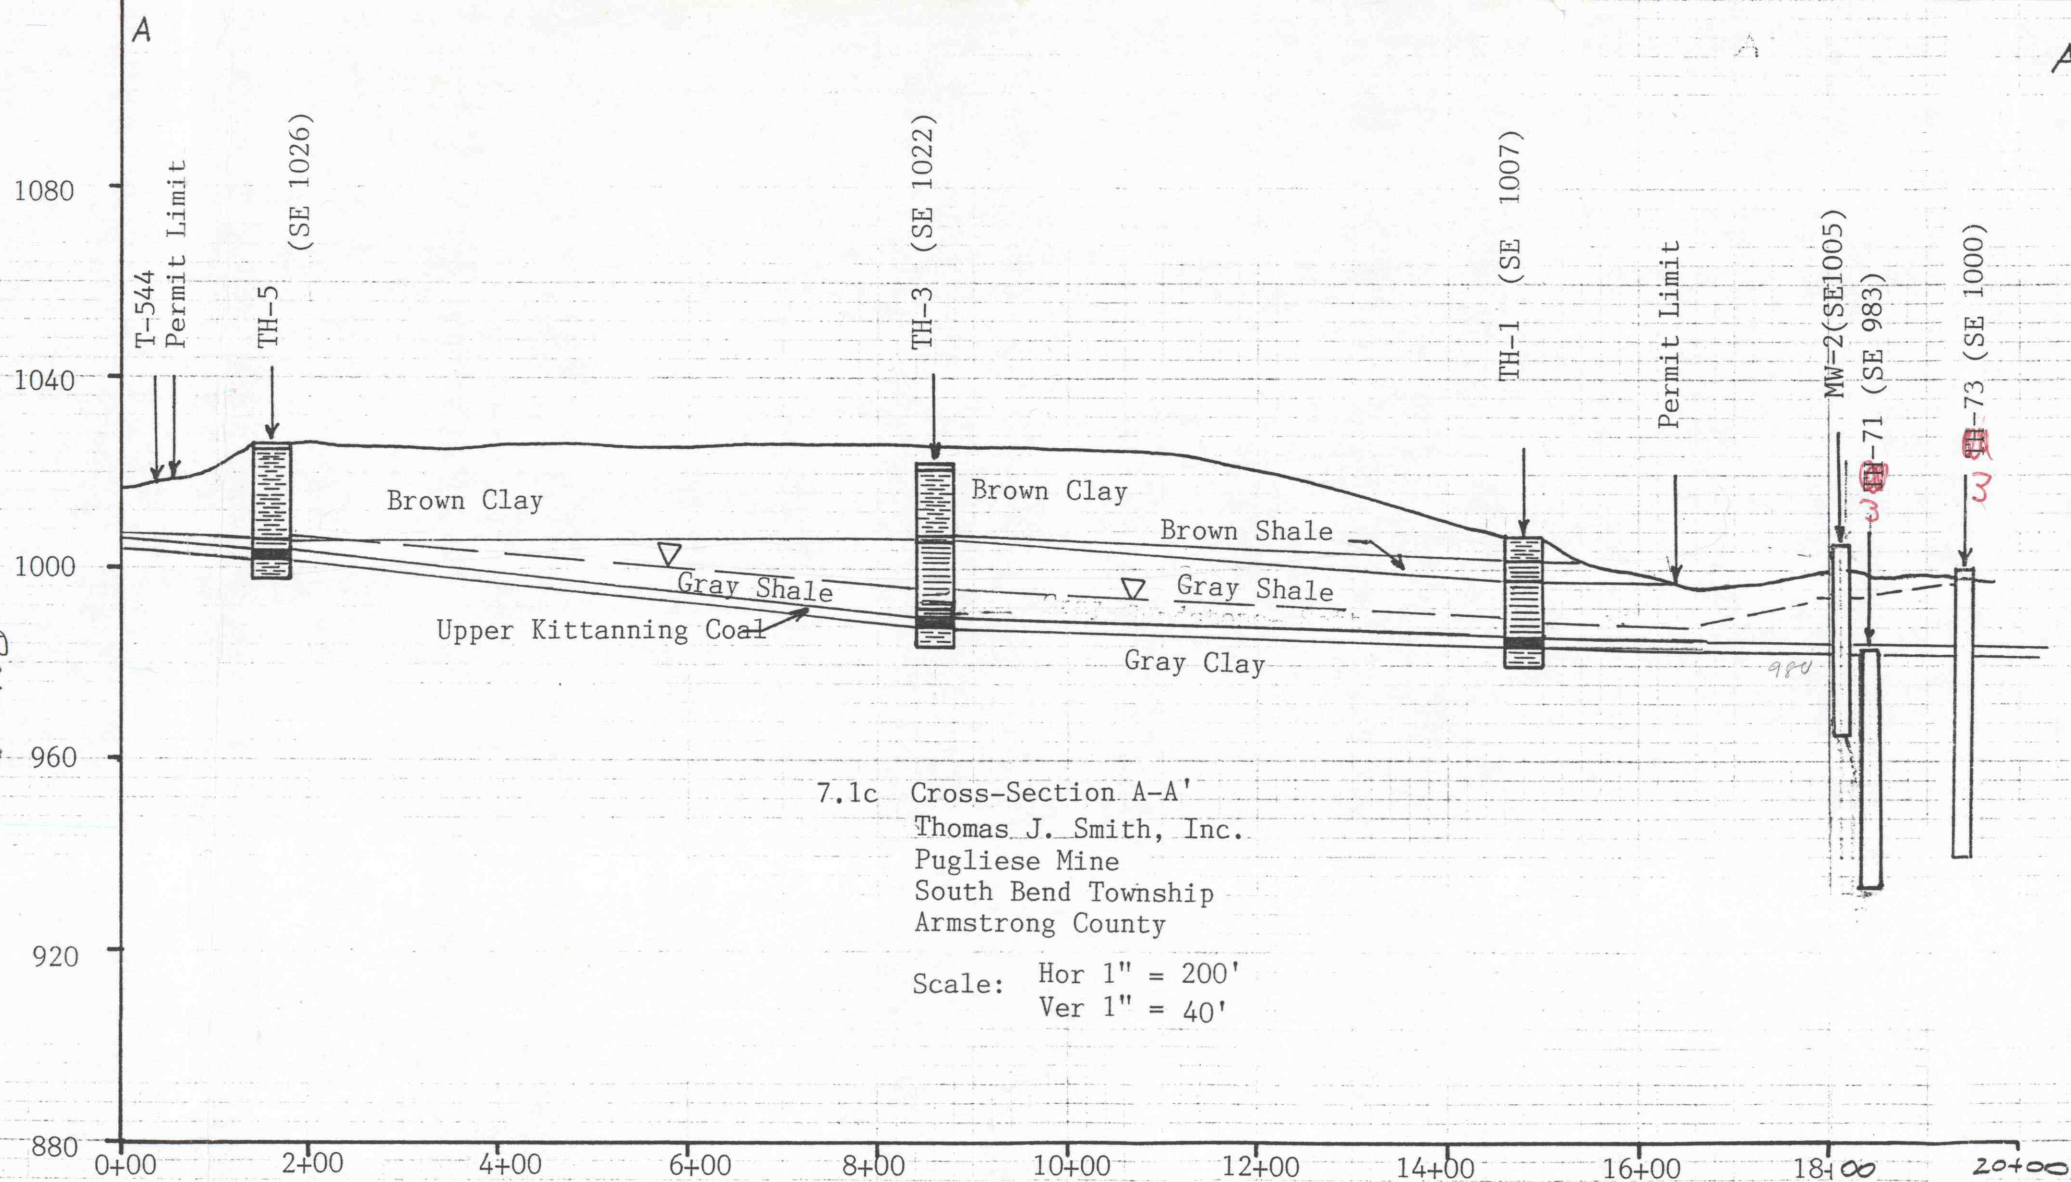

PERPENDICULAR TO DIP