ROCHESTER MILLS QUADRANGLE
PENNSYLVANIA—INDIANA CO.
7.5 MINUTE SERIES (TOPOGRAPHIC)
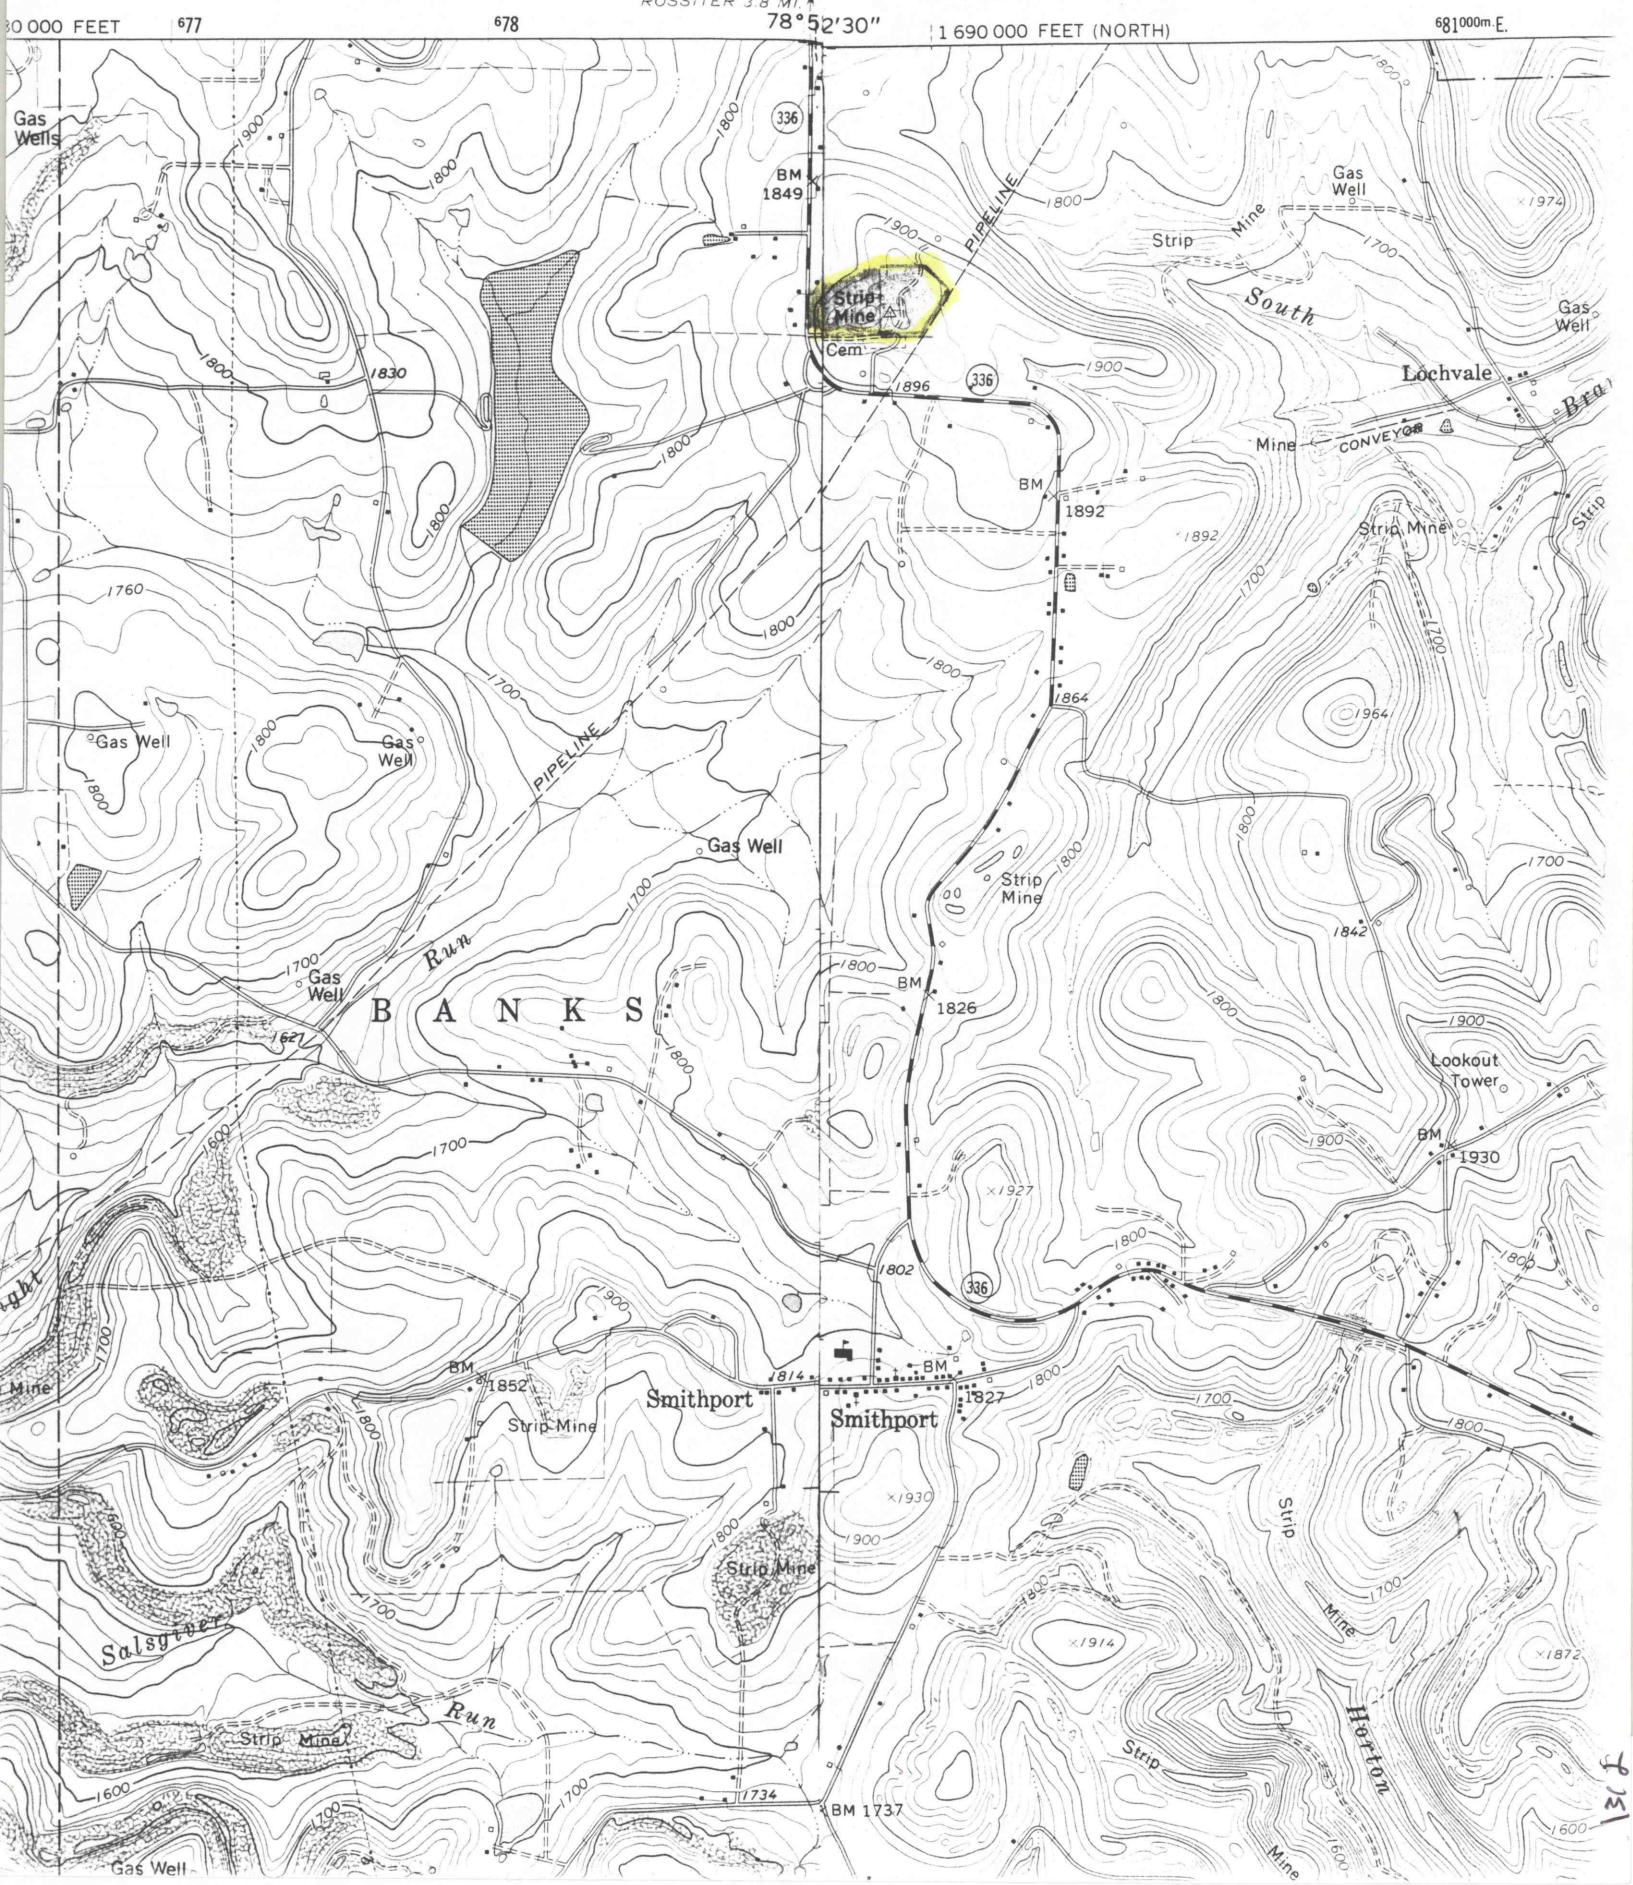
UNITED STATES
DEPARTMENT OF THE INTERIOR
GEOLOGICAL SURVEY