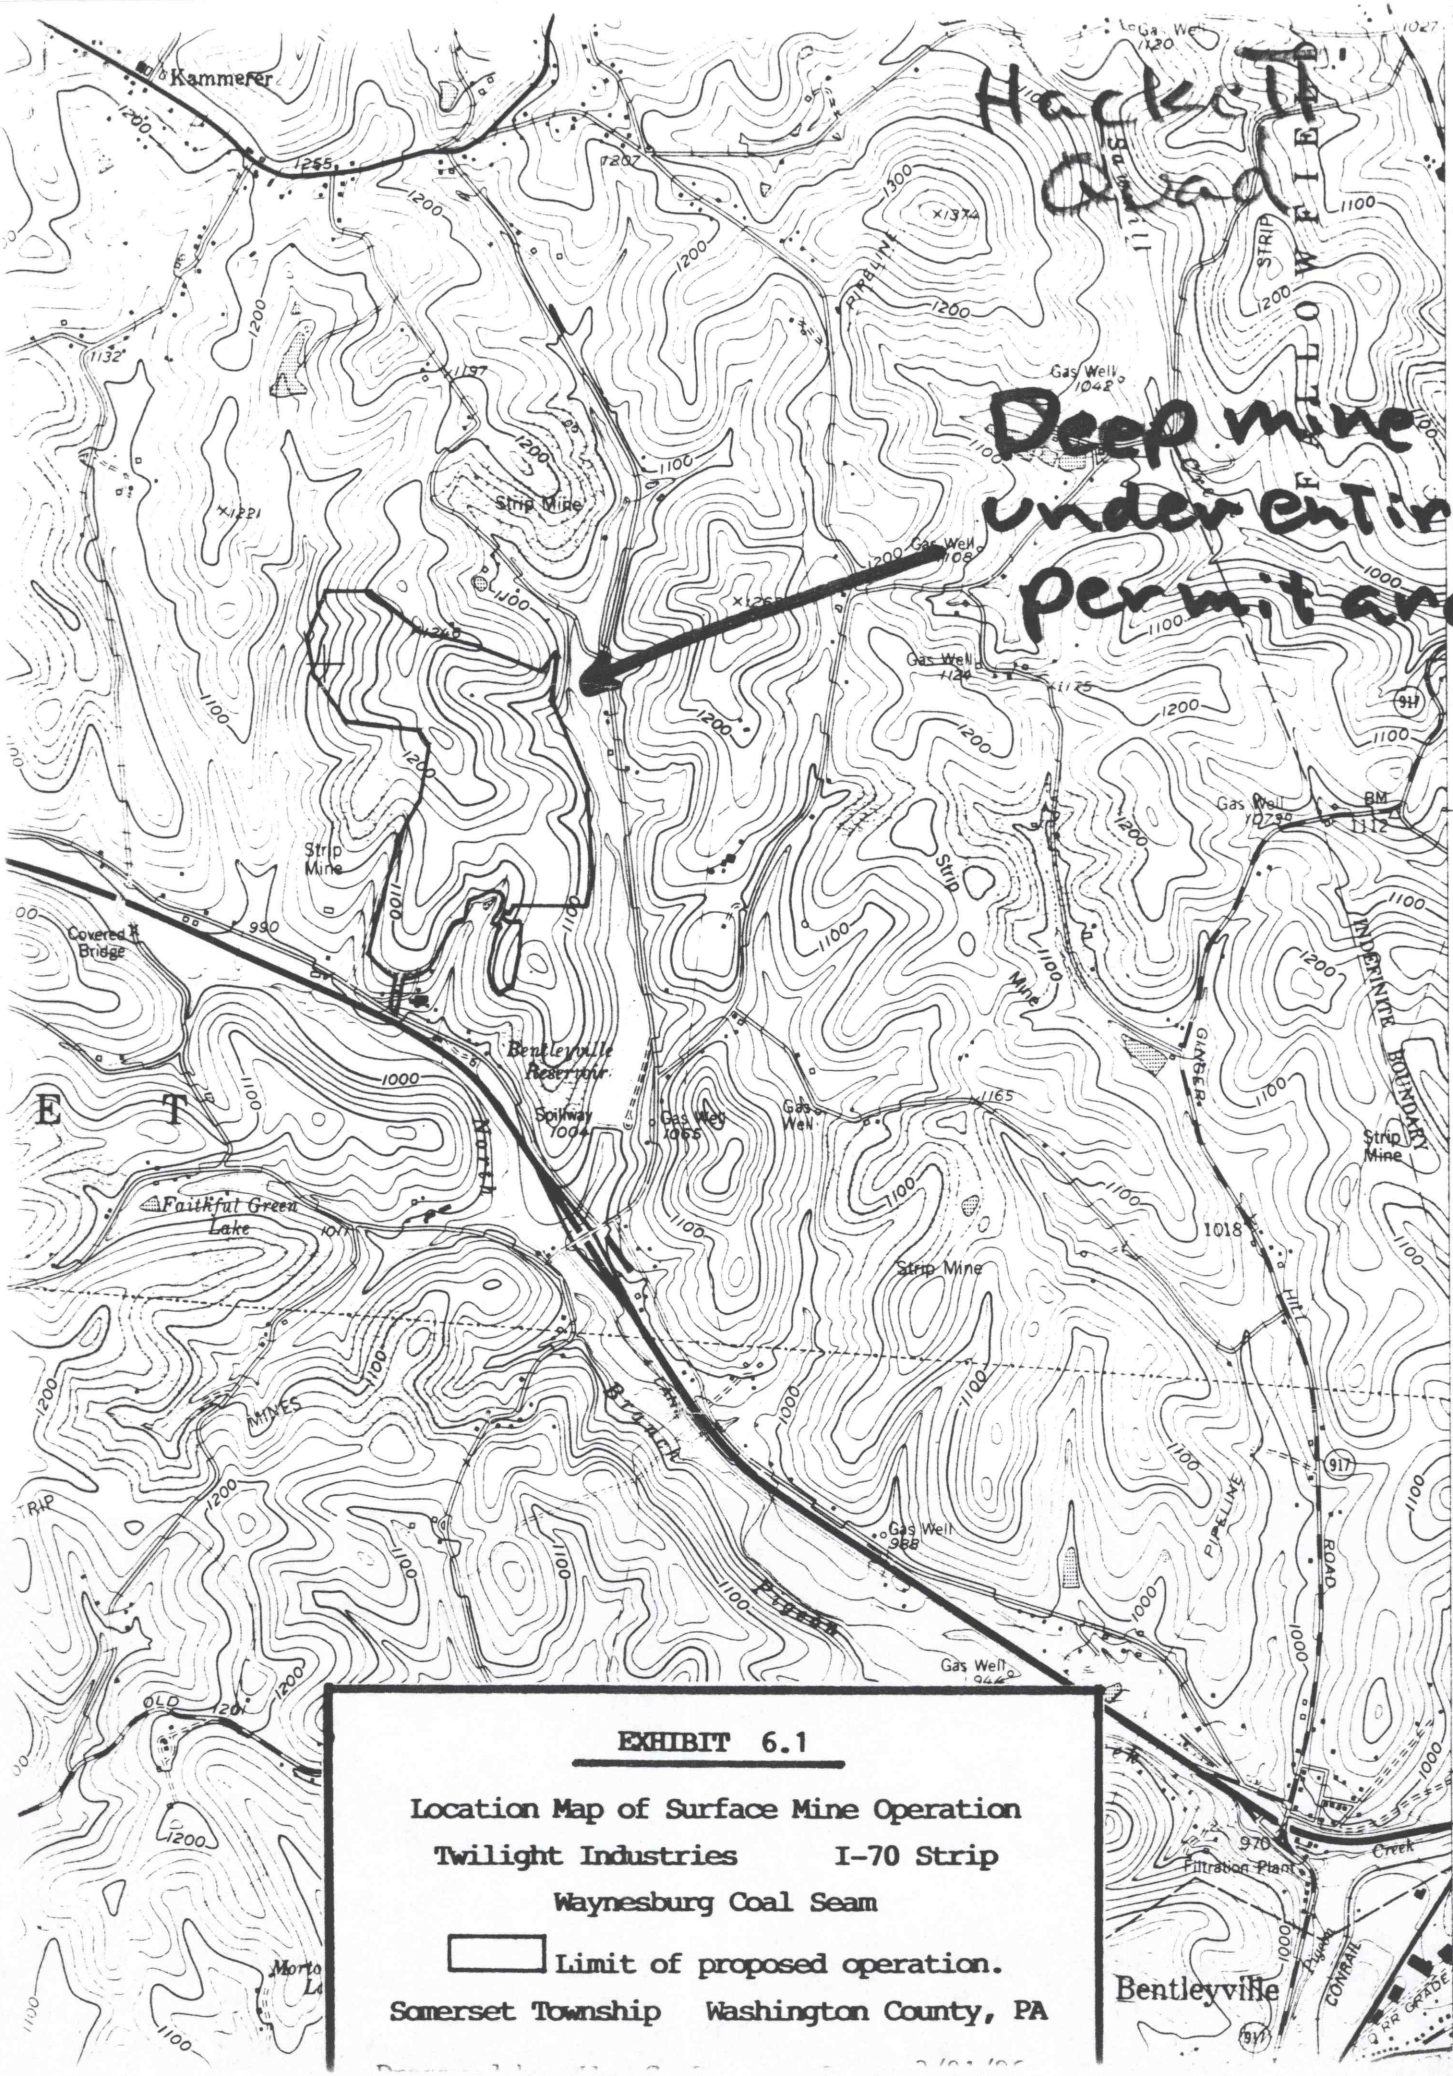

EXHIBIT 6.1

Location Map of Surface Mine Operation

Twilight Industries I-70 Strip

Waynesburg Coal Seam

Limit of proposed operation.

Somerset Township Washington County, PA