


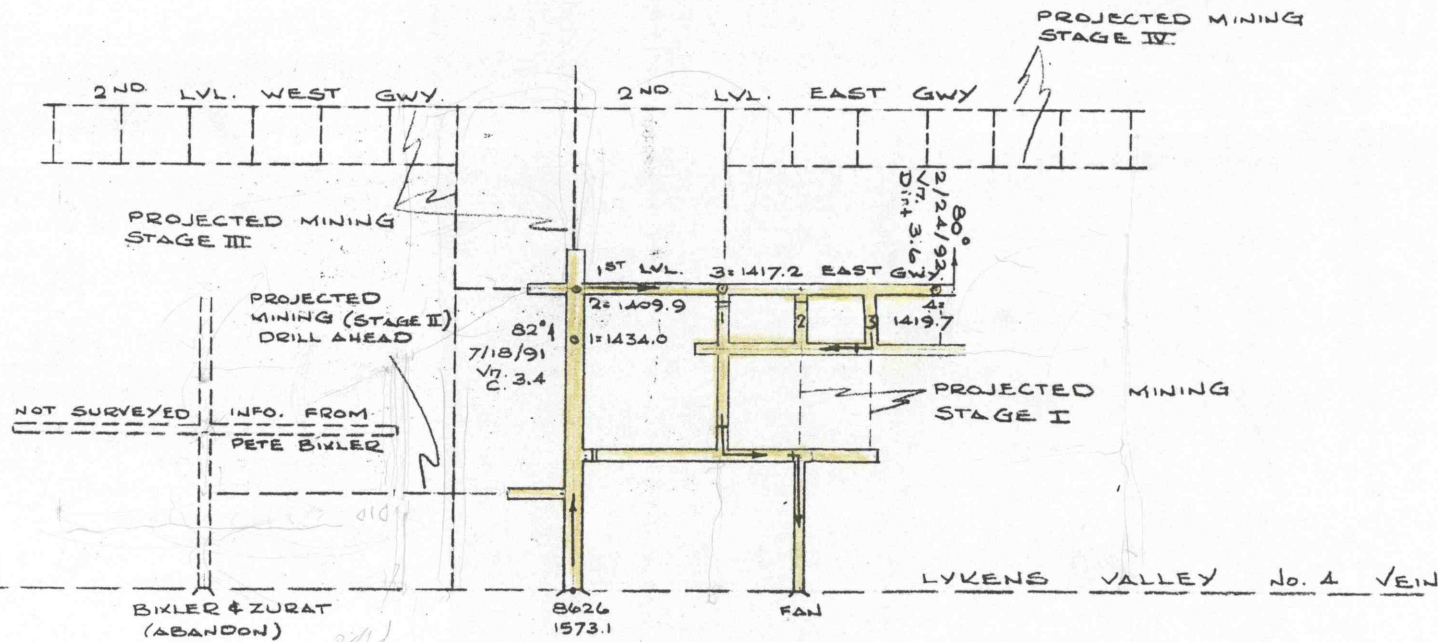

MSHA I.D.# 36-08014

SCALE: 1" = 100'

ON VEIN SECTION or VIEW OF THE
LV COAL COMPANY's No. 4 Slope

David L. Williams

PORTER TOWNSHIP

SCHUYLKILL COUNTY

PENNSYLVANIA

1348