


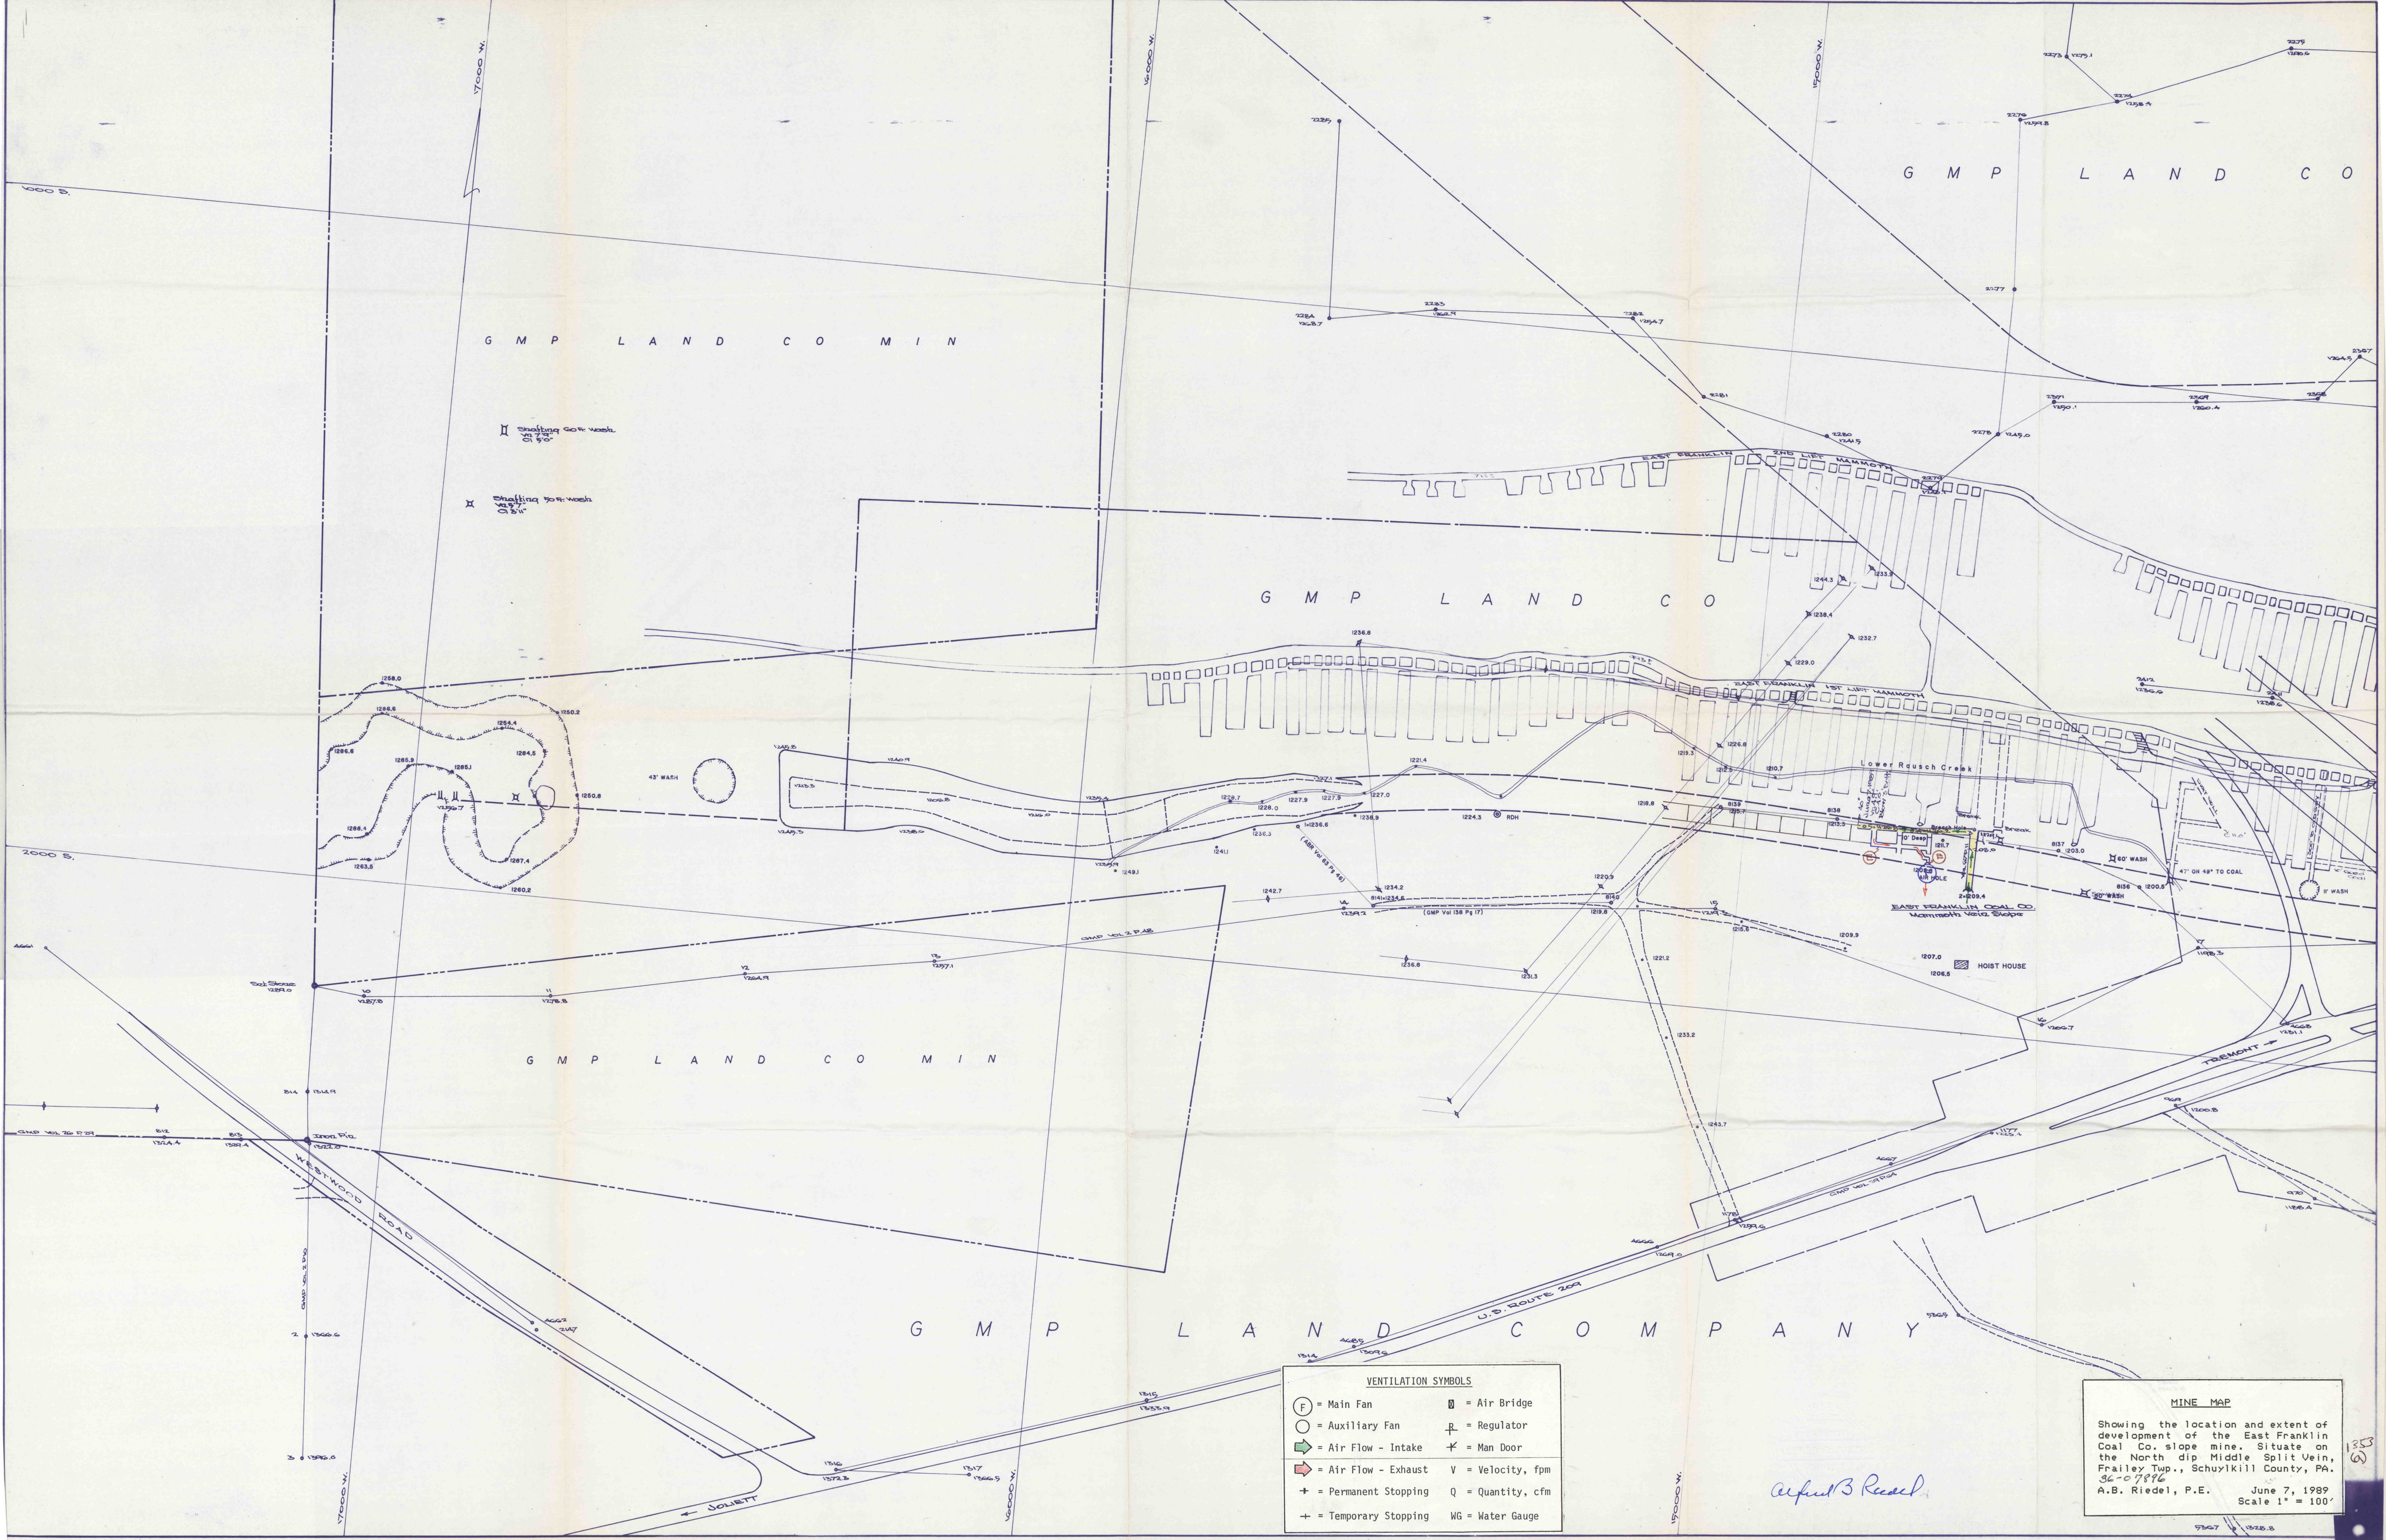

G M P L A N D C O M I N

G M P L A N D C O

G M P L A N D C O

G M P L A N D C O M I N

G M P L A N D C O M P A N Y

VENTILATION SYMBOLS			
(F) = Main Fan	(A) = Air Bridge	(V) = Velocity, fpm	
(O) = Auxiliary Fan	(R) = Regulator	(Q) = Quantity, cfm	
(I) = Air Flow - Intake	(M) = Man Door	(WG) = Water Gauge	
(E) = Air Flow - Exhaust			
(+) = Permanent Stopping			
(-+) = Temporary Stopping			

MINE MAP
Showing the location and extent of development of the East Franklin Coal Co. slope mine. Situate on the North dip Middle Split Vein, Frailey Twp., Schuylkill County, PA.
A.B. Riedel, P.E. June 7, 1989
Scale 1" = 100'