


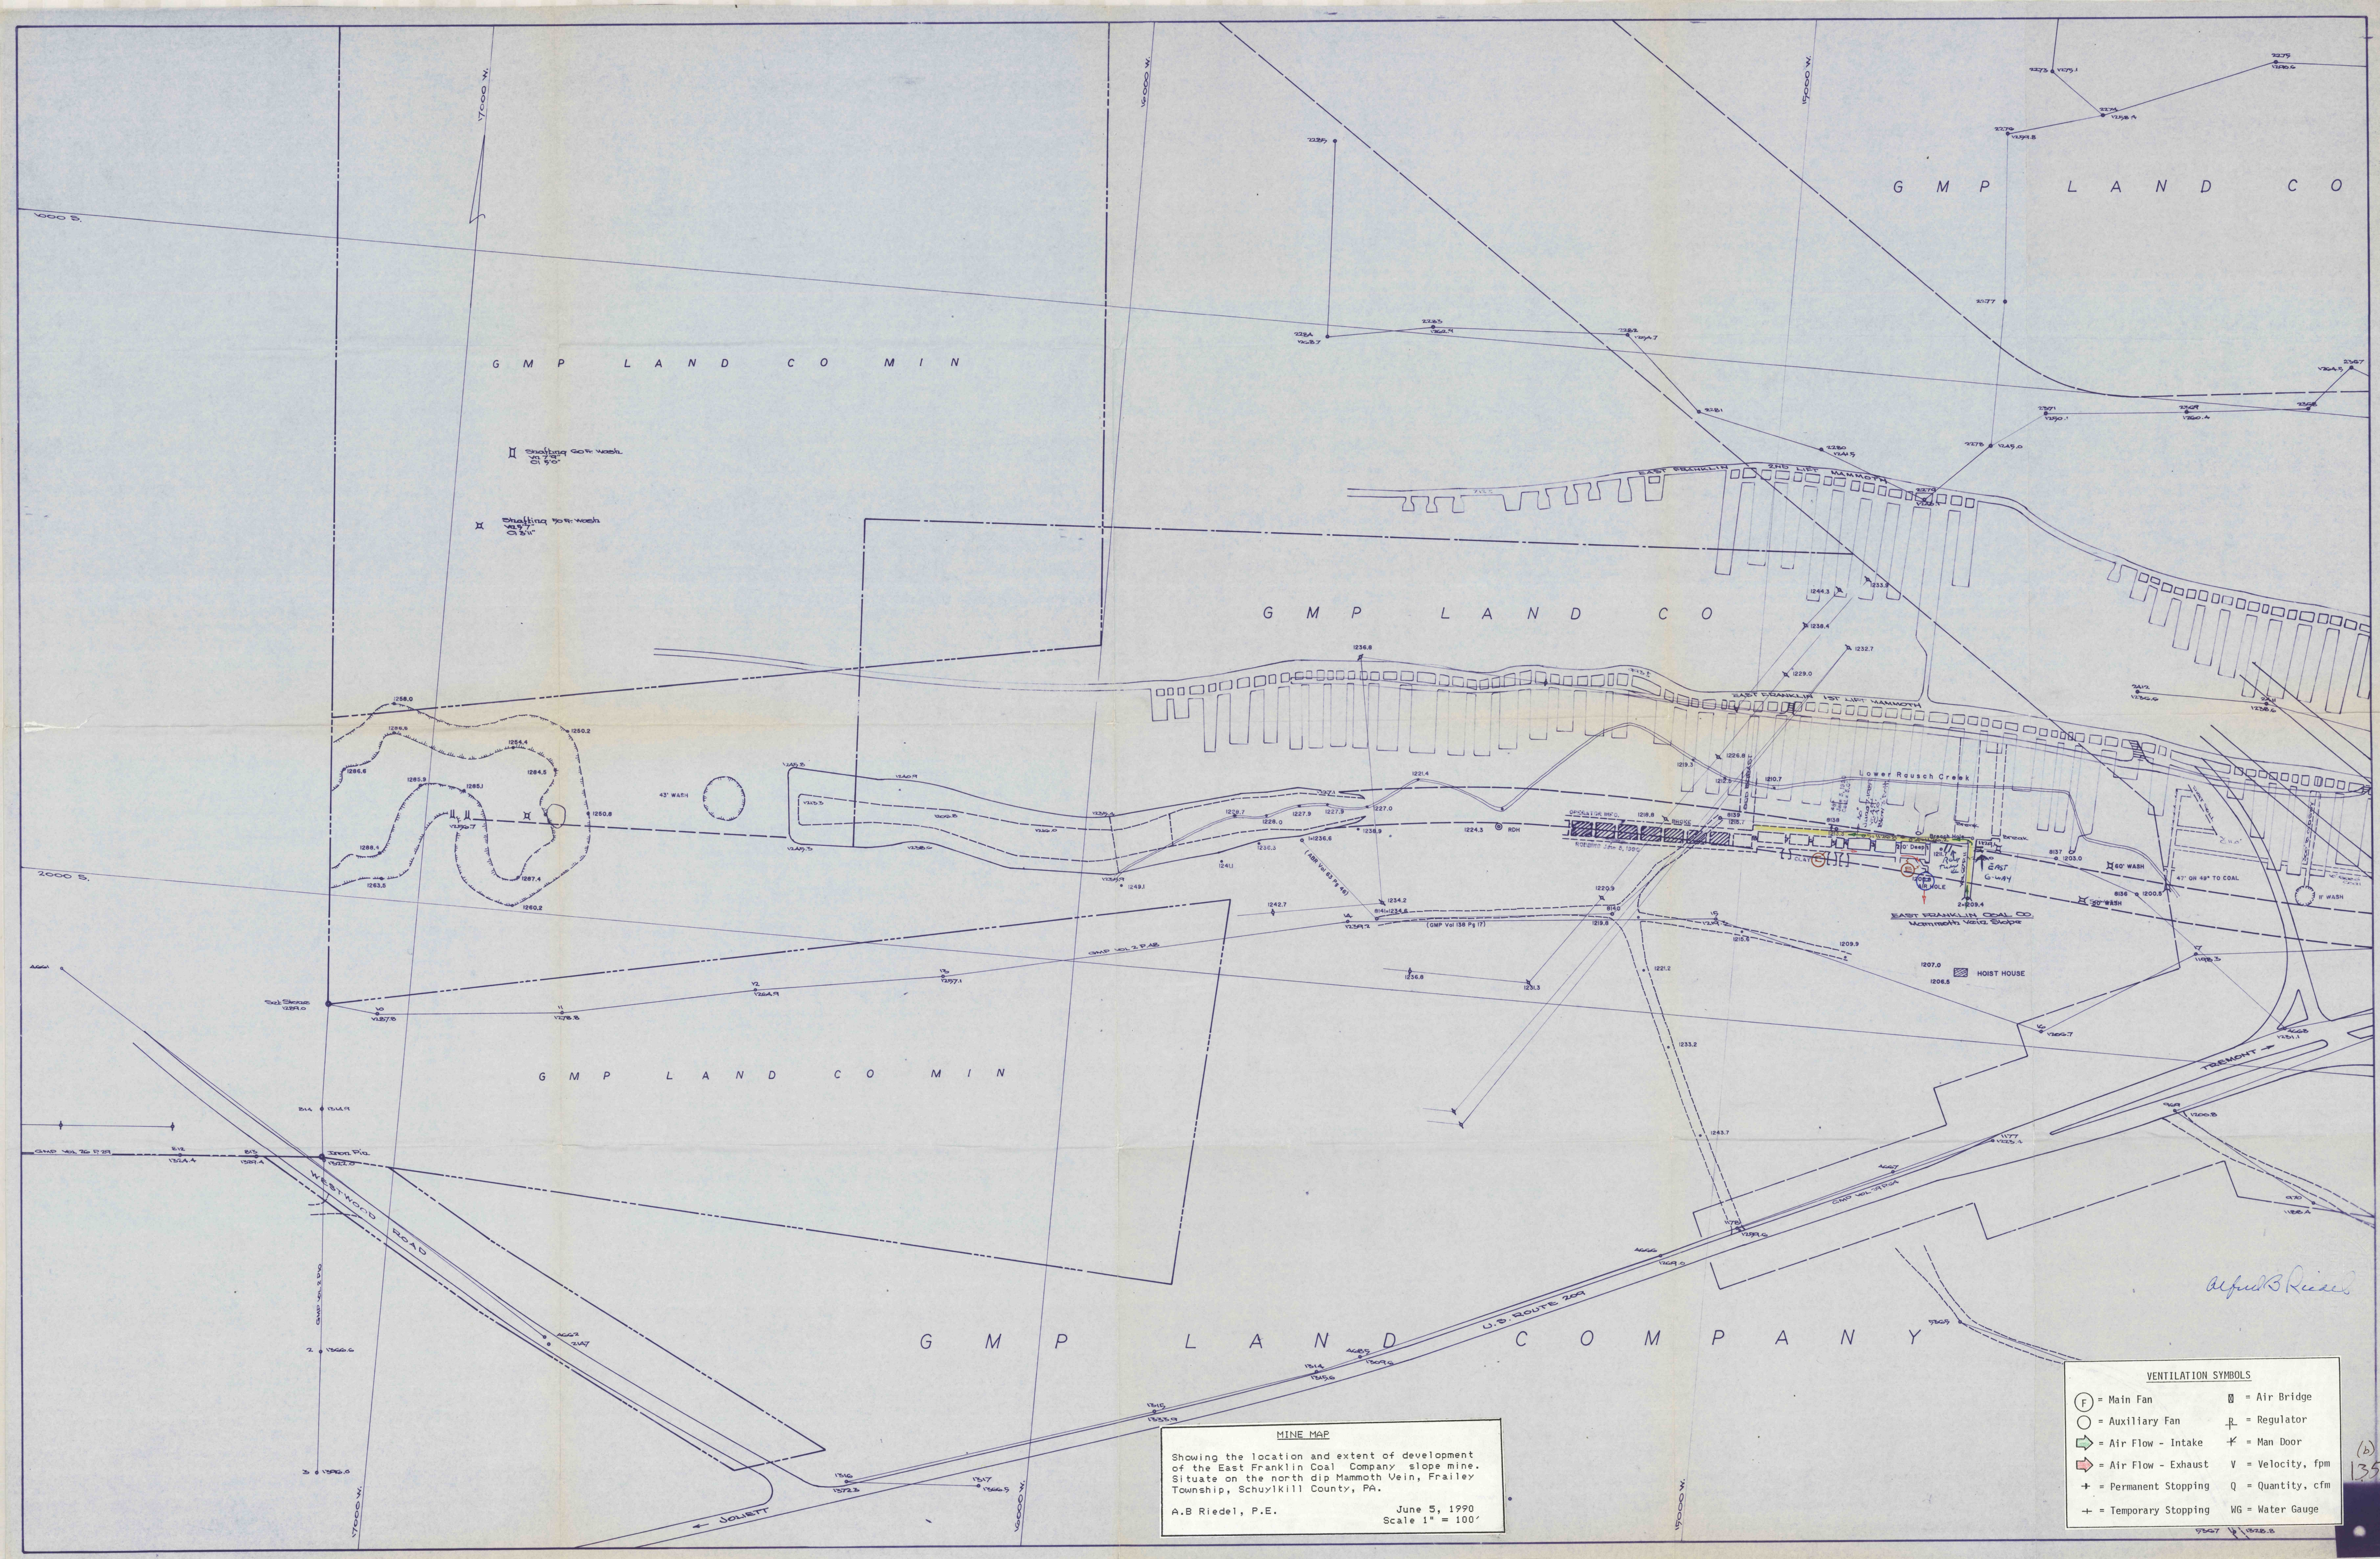

G M P L A N D C O M I N

G M P L A N D C O

G M P L A N D C O

G M P L A N D C O M I N

G M P L A N D C O M P A N Y

MINE MAP
Showing the location and extent of development of the East Franklin Coal Company slope mine. Situate on the north dip Mammoth Vein, Frailey Township, Schuylkill County, PA.
A.B. Riedel, P.E. June 5, 1990
Scale 1" = 100'

VENTILATION SYMBOLS	
(F) = Main Fan	(A) = Air Bridge
(O) = Auxiliary Fan	(R) = Regulator
(I) = Air Flow - Intake	(M) = Man Door
(E) = Air Flow - Exhaust	(V) = Velocity, fpm
(+) = Permanent Stopping	(Q) = Quantity, cfm
(-/-) = Temporary Stopping	(WG) = Water Gauge

A.B. Riedel