


CROSS SECTION

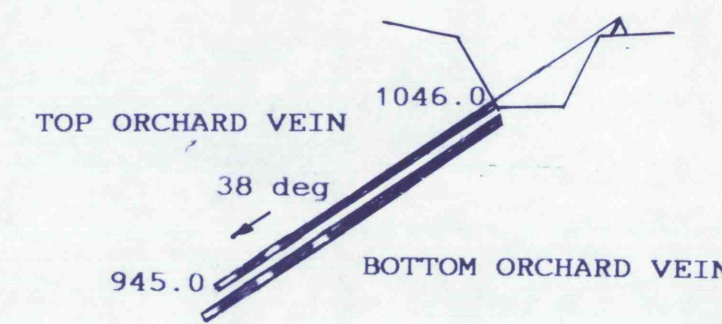


795.0
Middle Creek Mine Pool Elev.

REILLY TOWNSHIP
FRAILEY TOWNSHIP

- TOP ORCHARD WORKINGS
- BOTTOM ORCHARD WORKINGS

LEGEND

- Intake Air
- Return Air
- Escapeway
- Exhaust Fan
- Slope Entrance
- Permanent Stopping
- Temporary Stopping
- Overcast

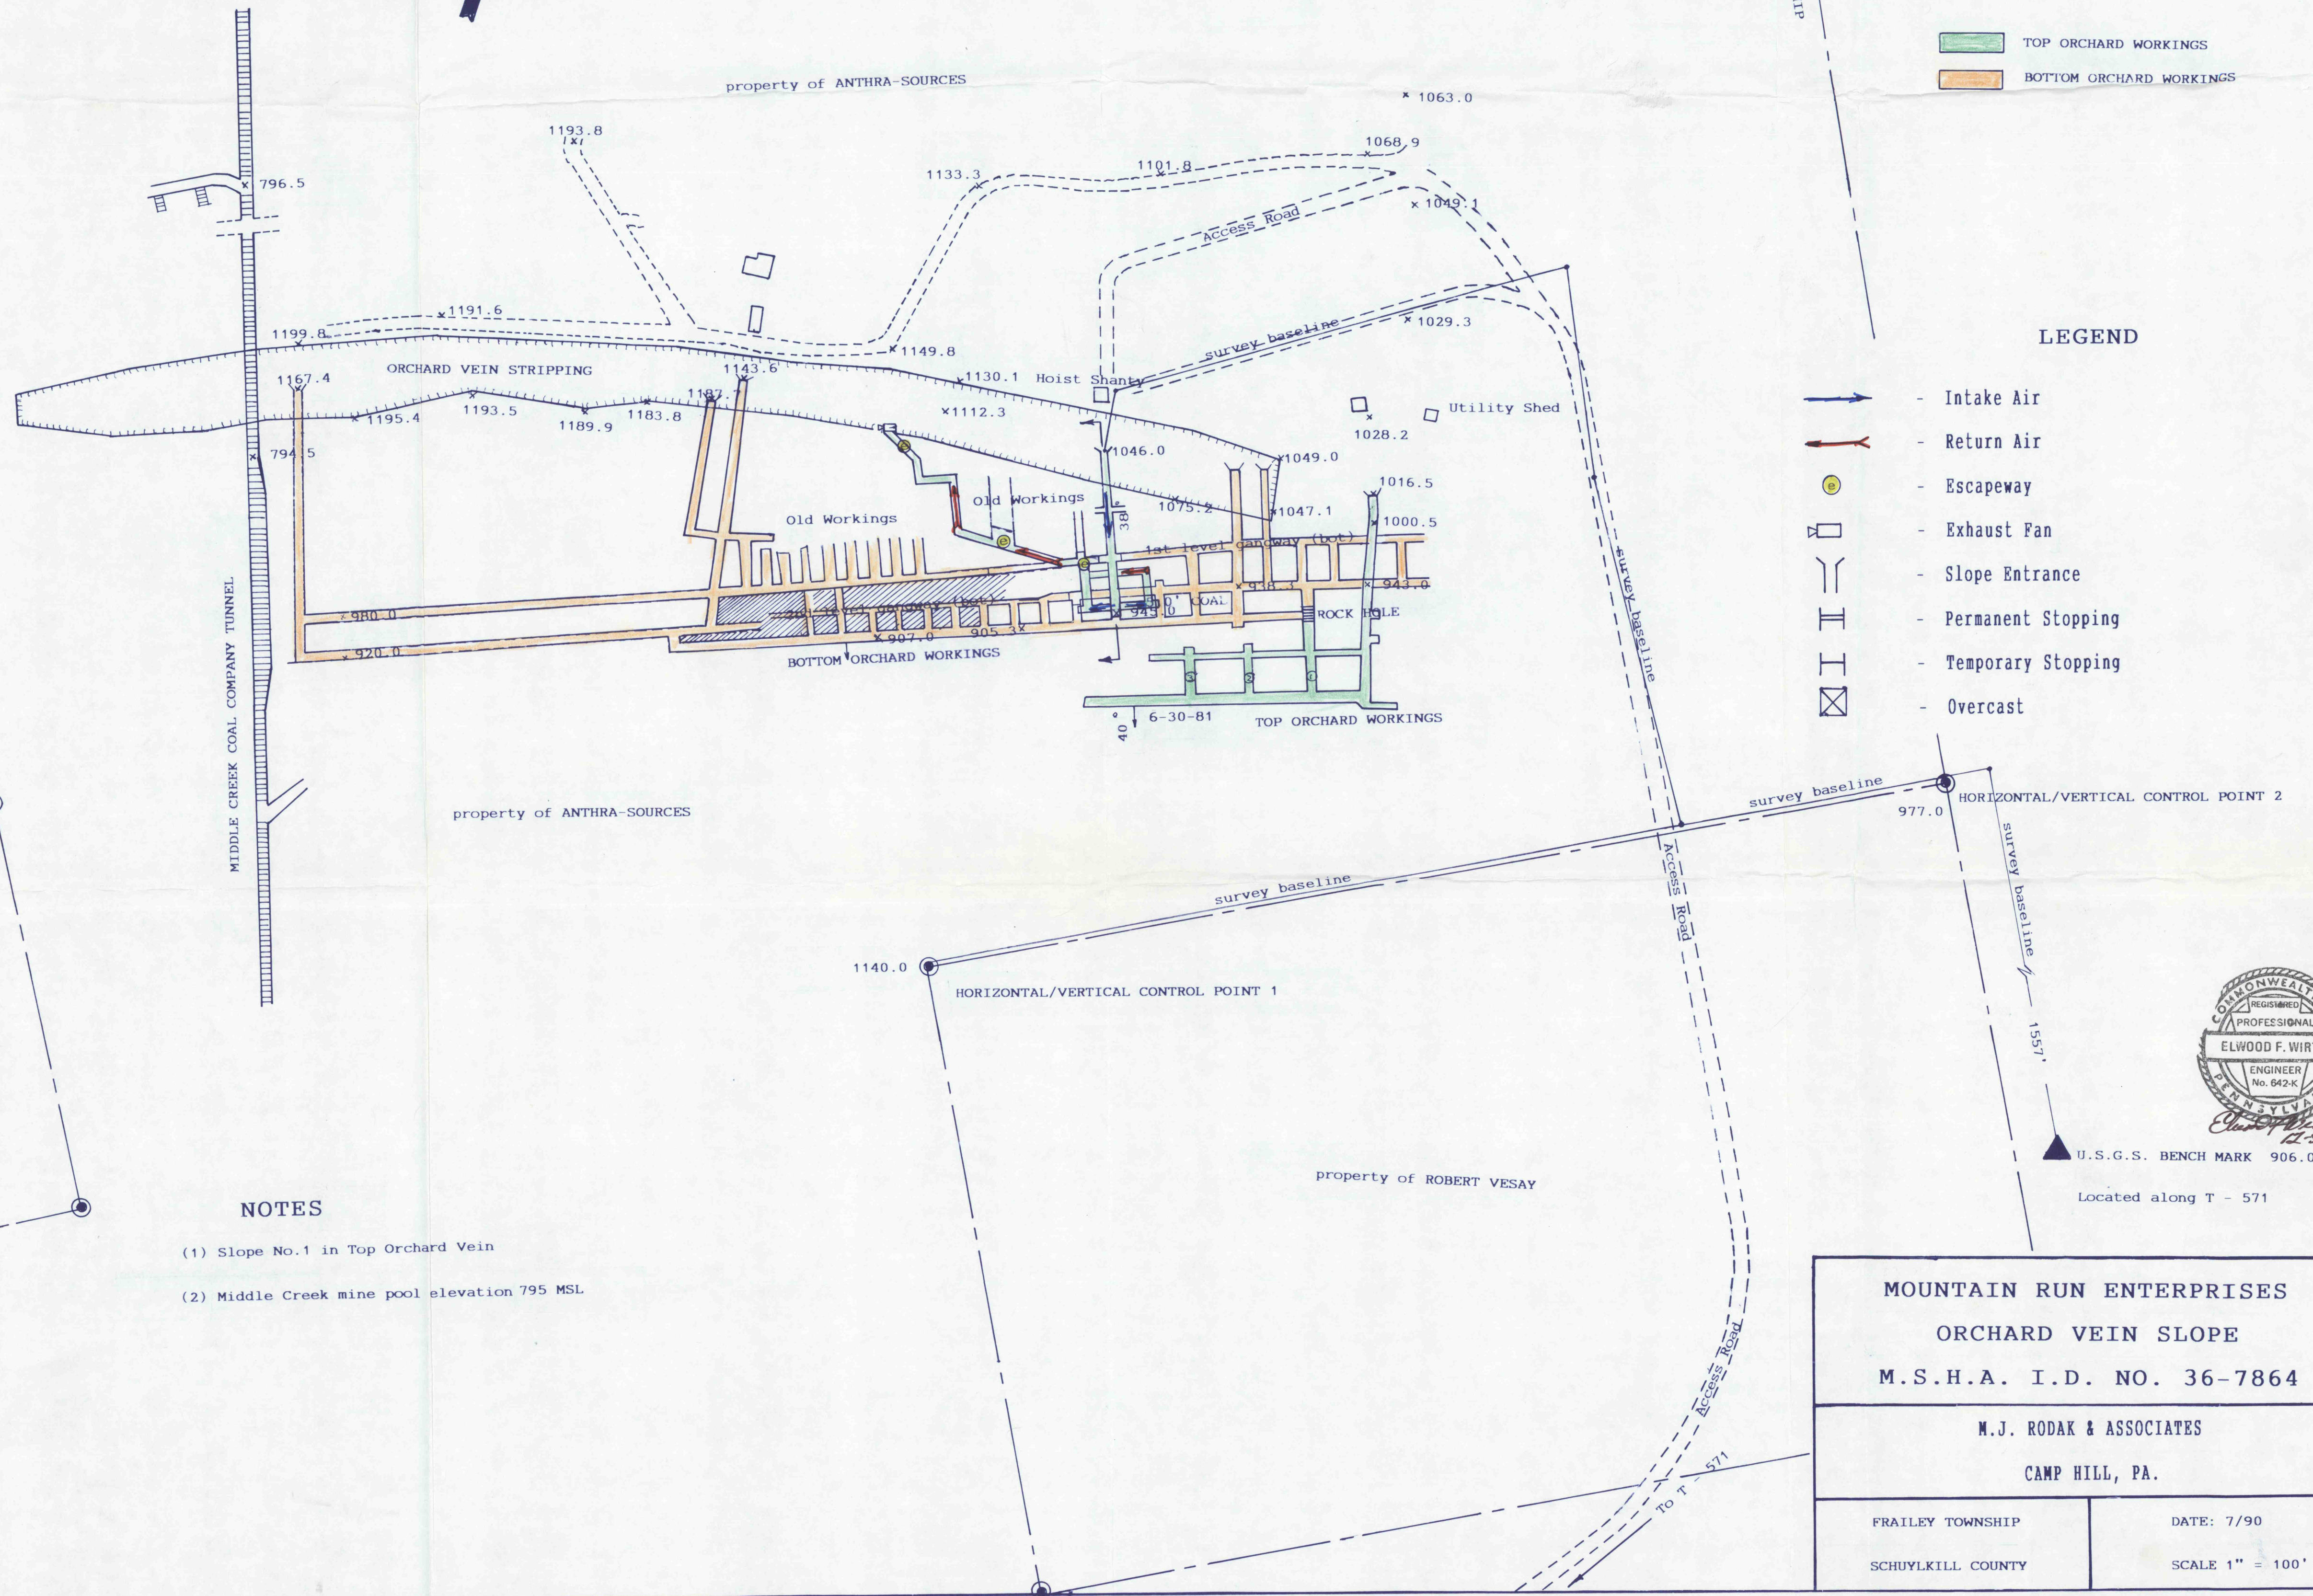

NOTES

- Slope No.1 in Top Orchard Vein
- Middle Creek mine pool elevation 795 MSL

MOUNTAIN RUN ENTERPRISES
ORCHARD VEIN SLOPE
M.S.H.A. I.D. NO. 36-7864

M.J. RODAK & ASSOCIATES

CAMP HILL, PA.

FRAILEY TOWNSHIP

SCHUYLKILL COUNTY

DATE: 7/90

SCALE 1" = 100'