


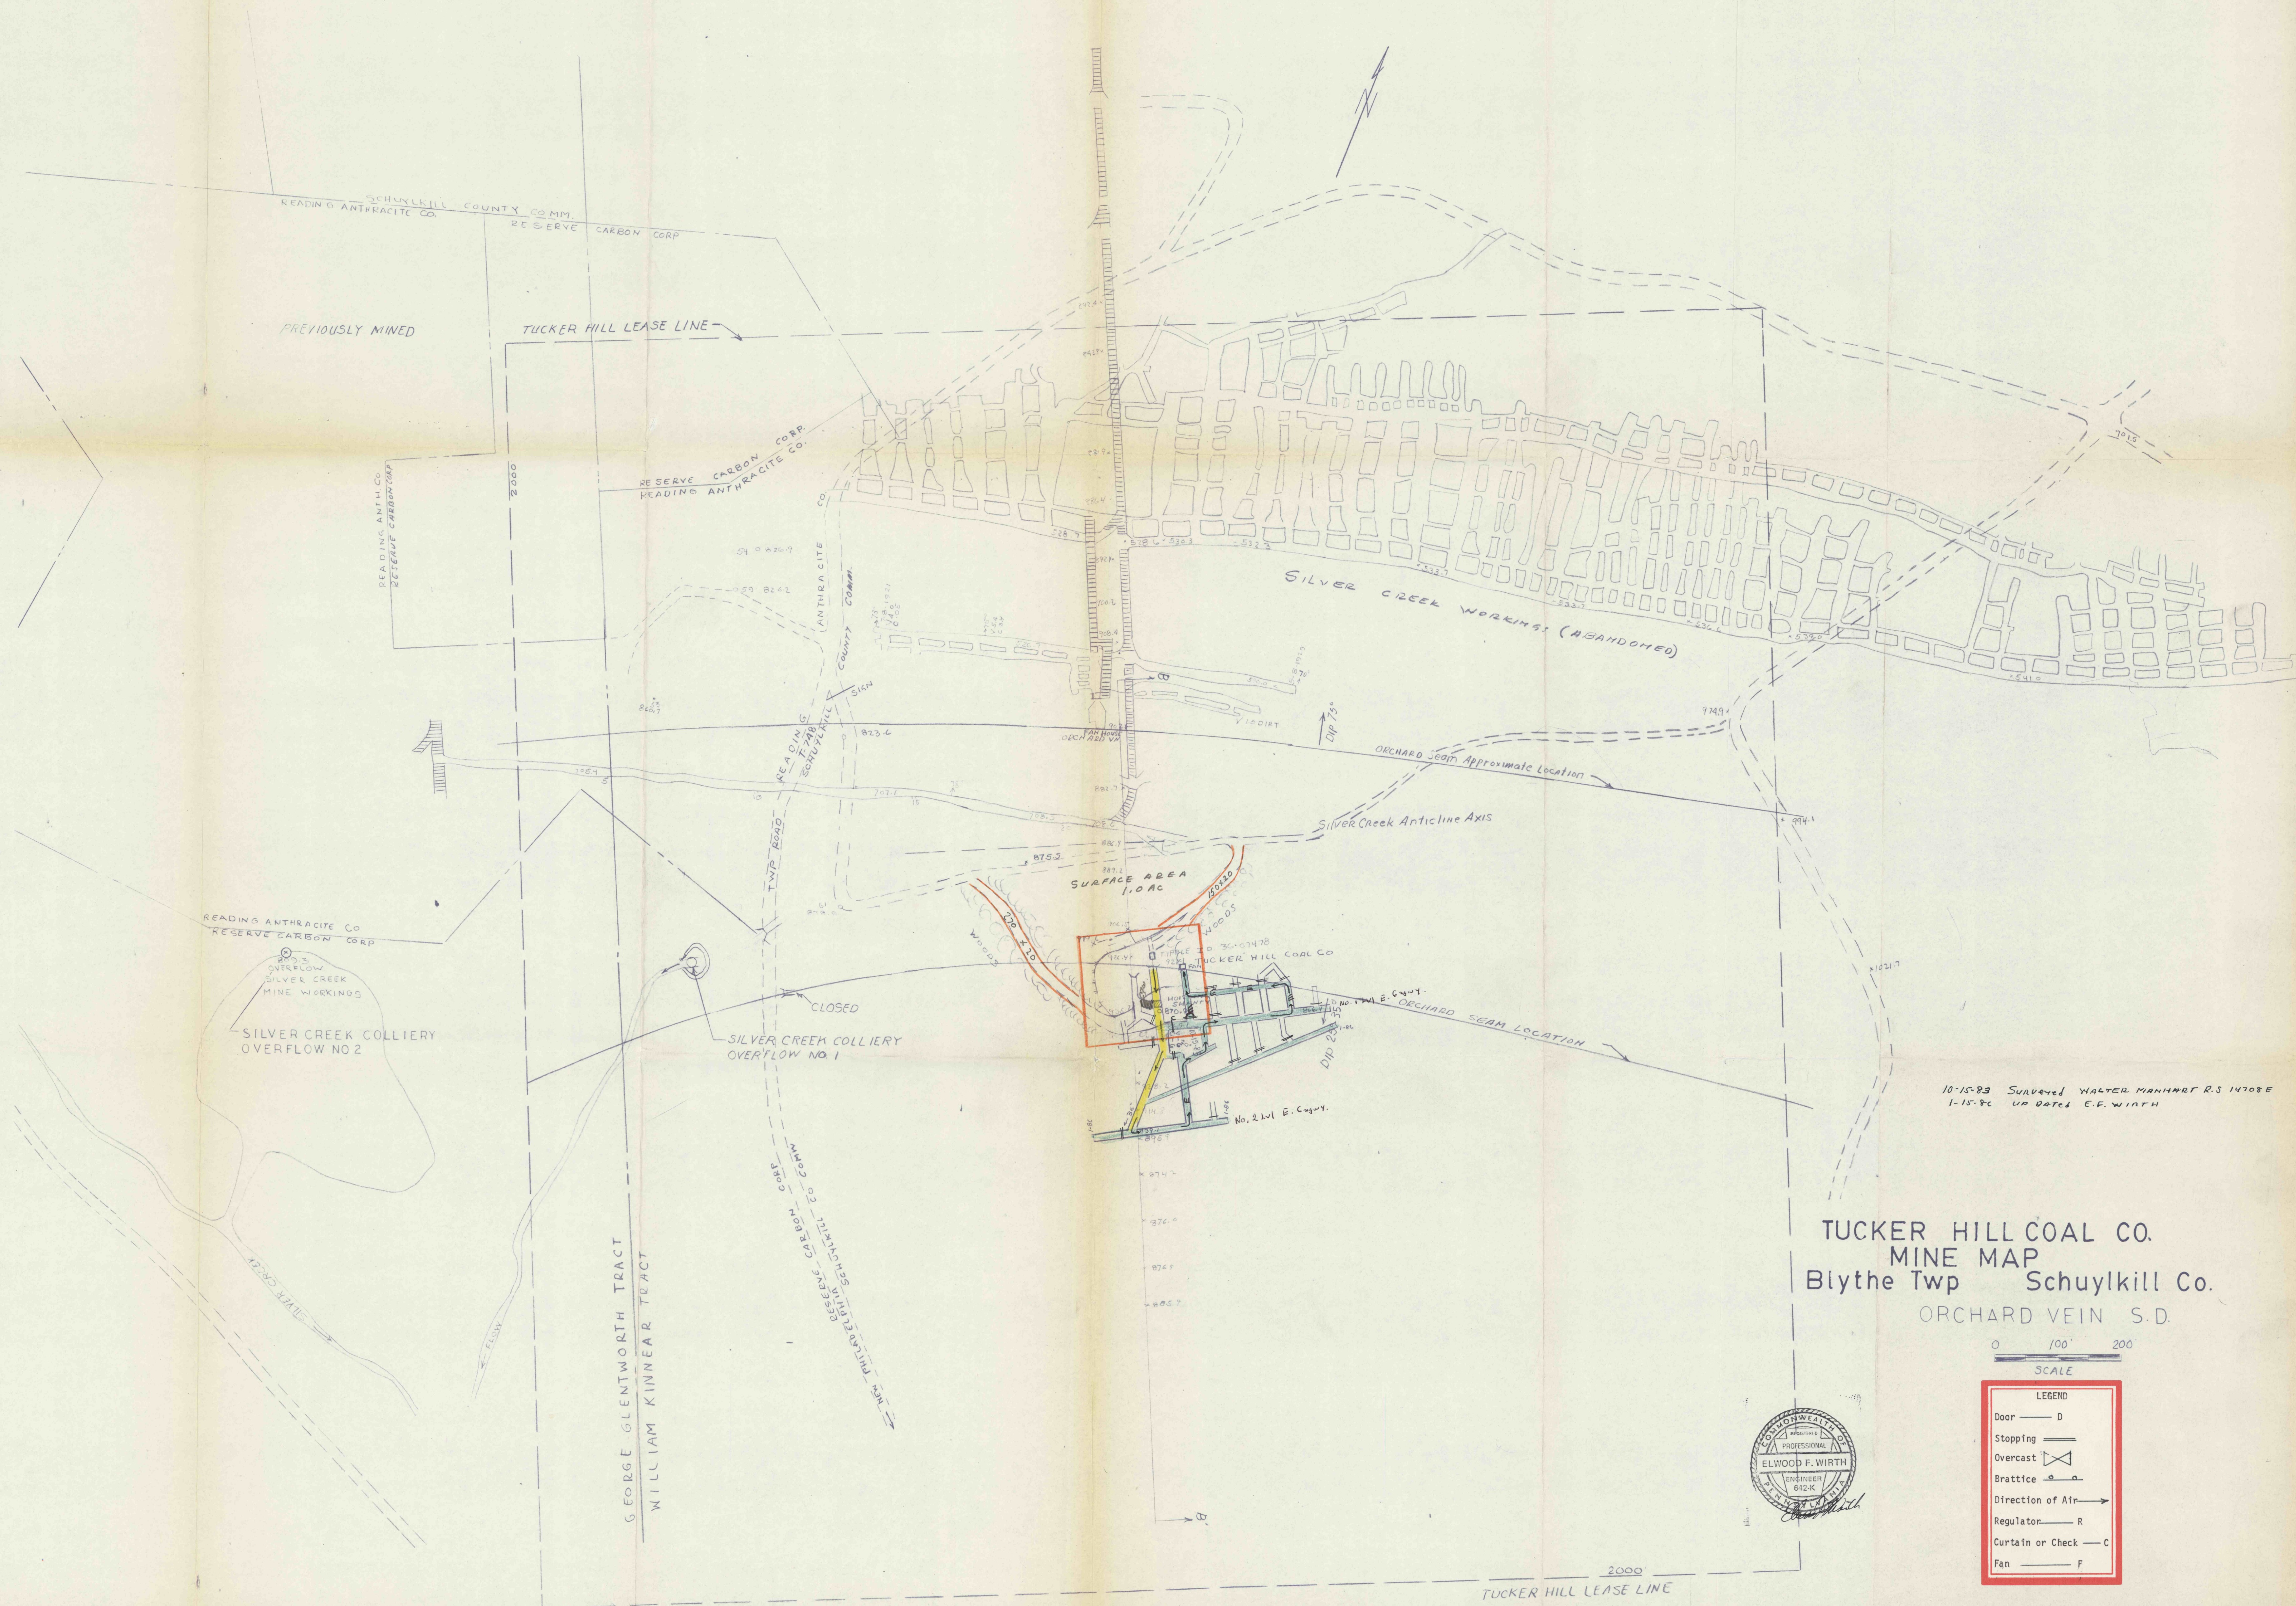

TUCKER HILL COAL CO.
MINE MAP
Blythe Twp Schuylkill Co.
ORCHARD VEIN S.D.

0 100 200
SCALE

- LEGEND
- Door — D
 - Stopping —
 - Overcast —
 - Brattice —
 - Direction of Air —
 - Regulator — R
 - Curtain or Check — C
 - Fan — F

