


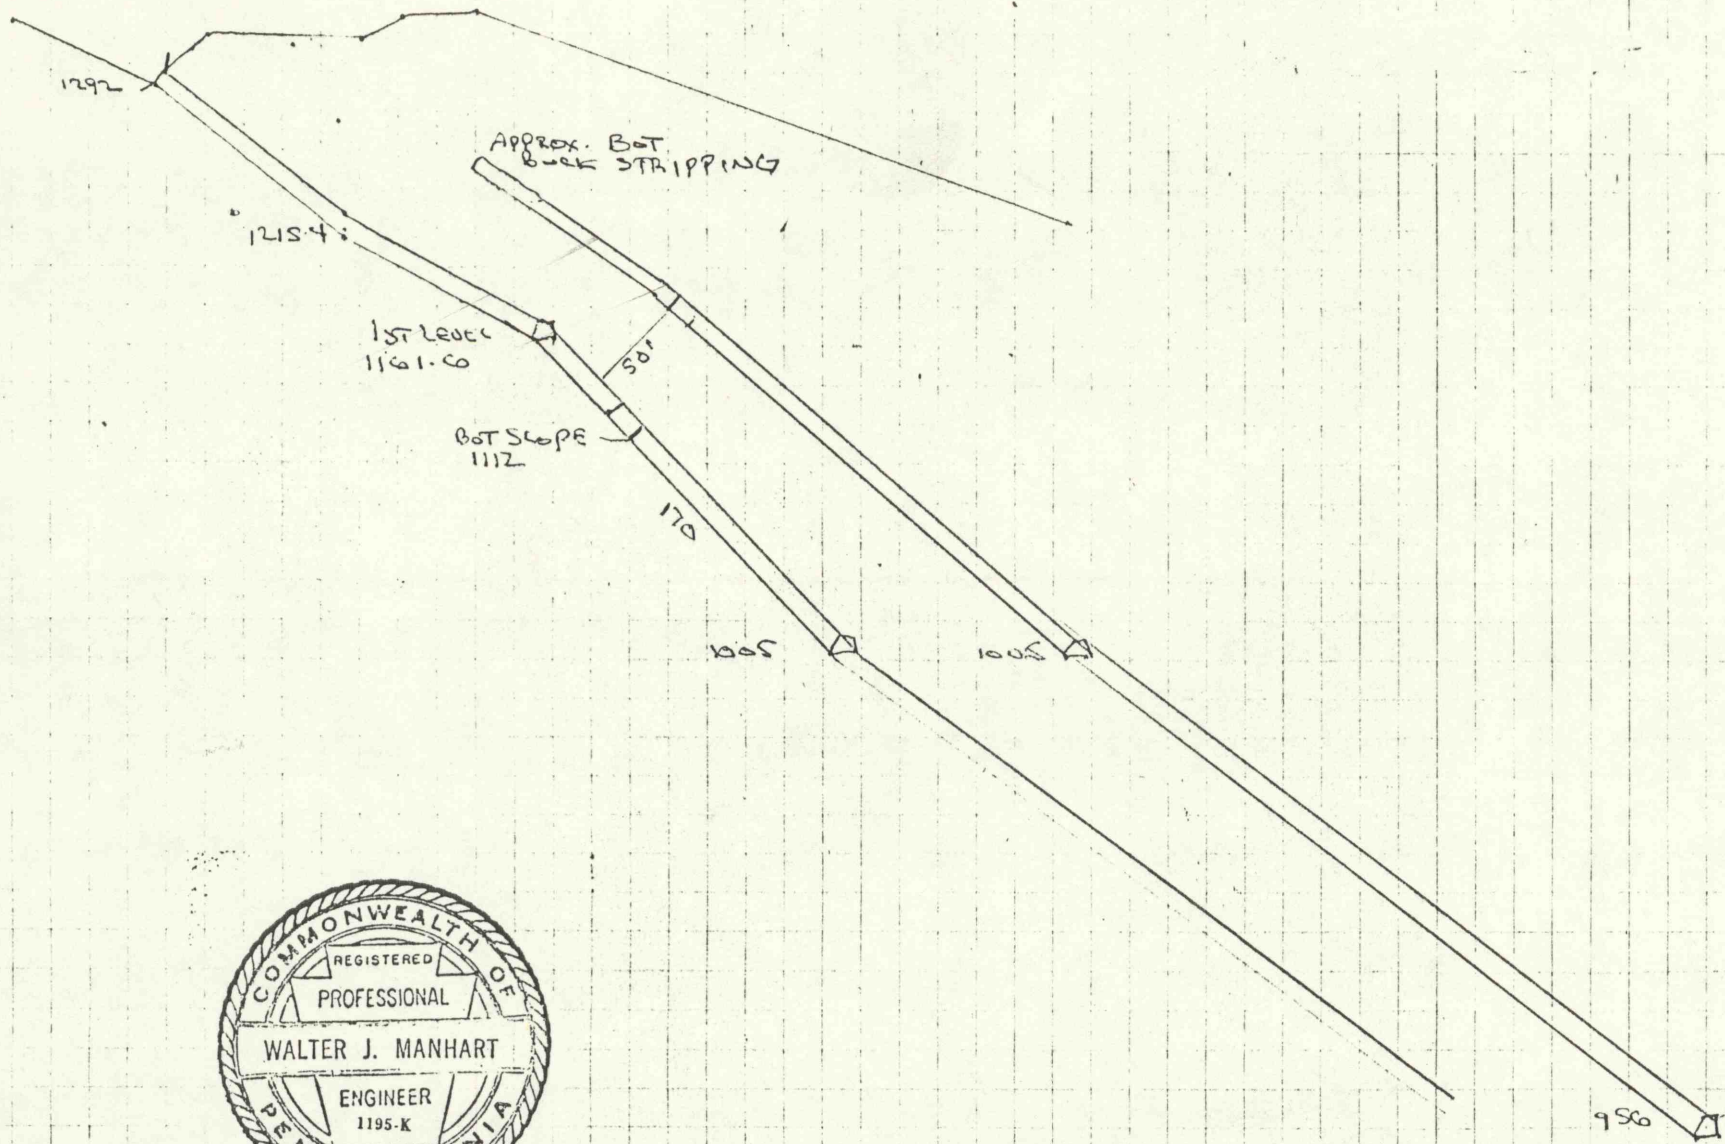

SECTION THRU
MINE HILL No. 50 Slope

1381