


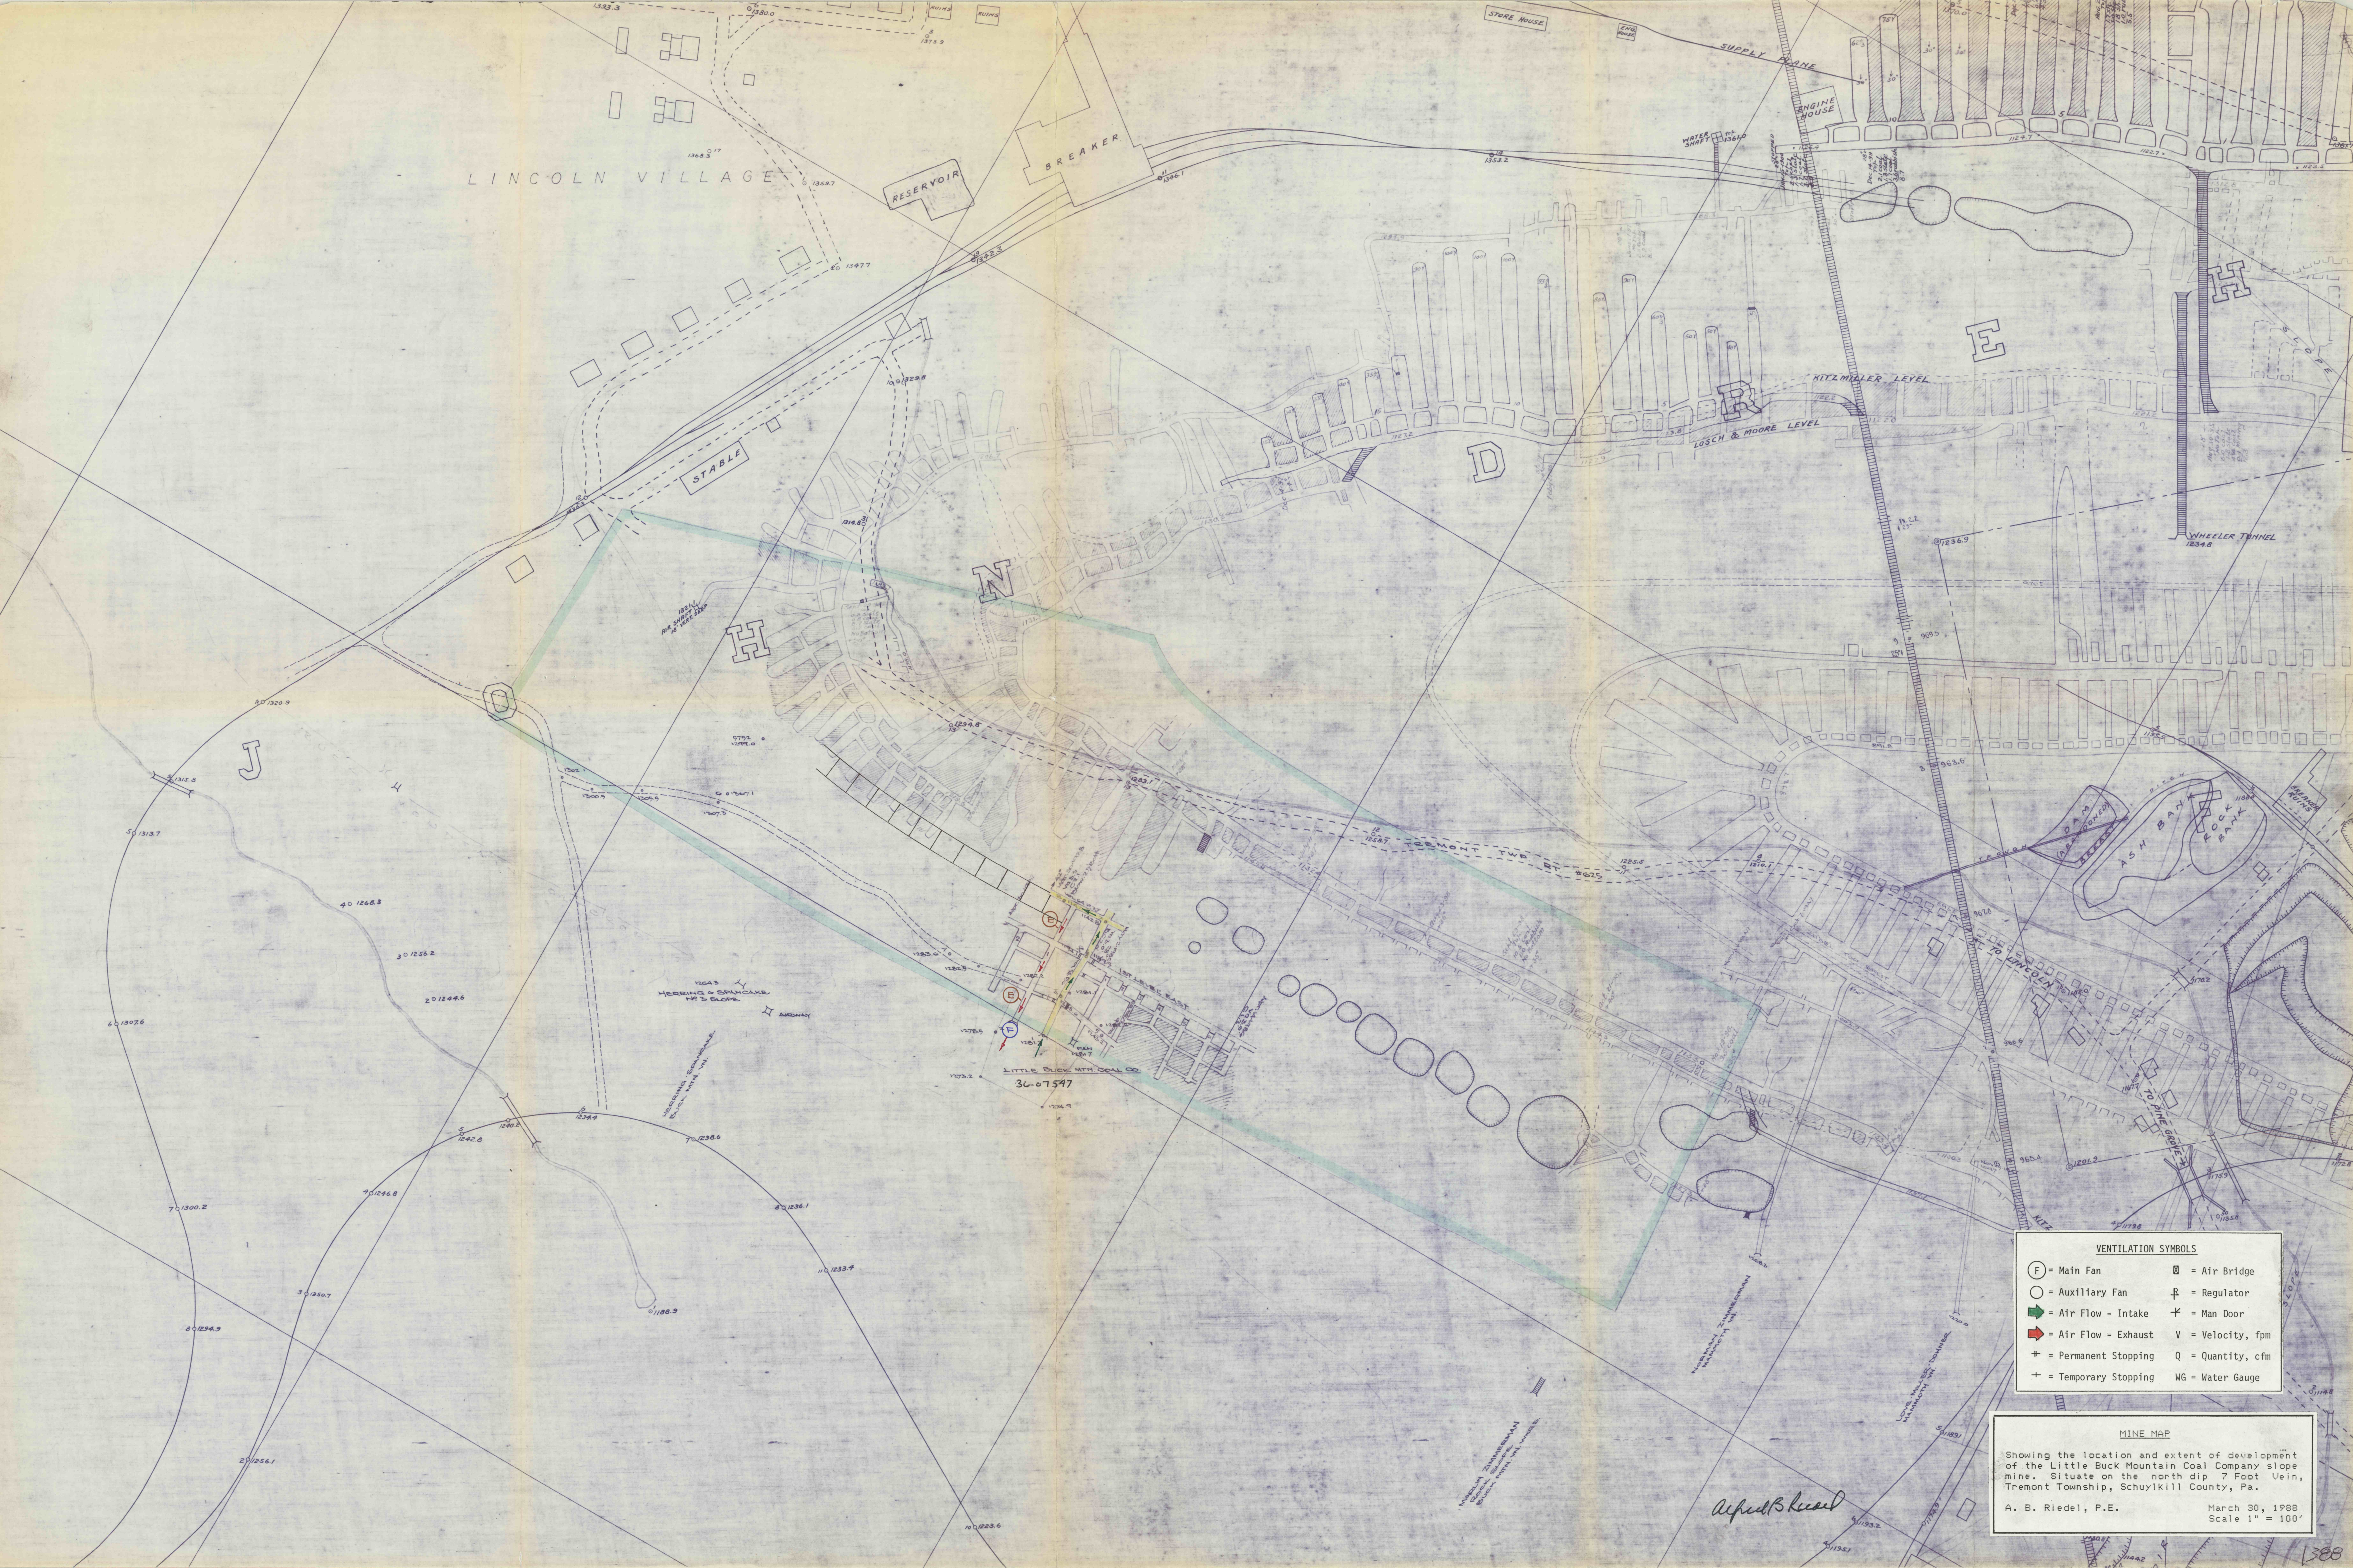

VENTILATION SYMBOLS			
(F) = Main Fan	(A) = Air Bridge	(R) = Regulator	(M) = Man Door
(A) = Auxiliary Fan	(V) = Velocity, fpm	(Q) = Quantity, cfm	(S) = Permanent Stopping
(I) = Air Flow - Intake	(E) = Air Flow - Exhaust	(T) = Temporary Stopping	(W) = Water Gauge

MINE MAP

Showing the location and extent of development of the Little Buck Mountain Coal Company slope mine. Situate on the north dip 7 Foot Vein, Tremont Township, Schuylkill County, Pa.

A. B. Riedel, P.E. March 30, 1928
Scale 1" = 100'