
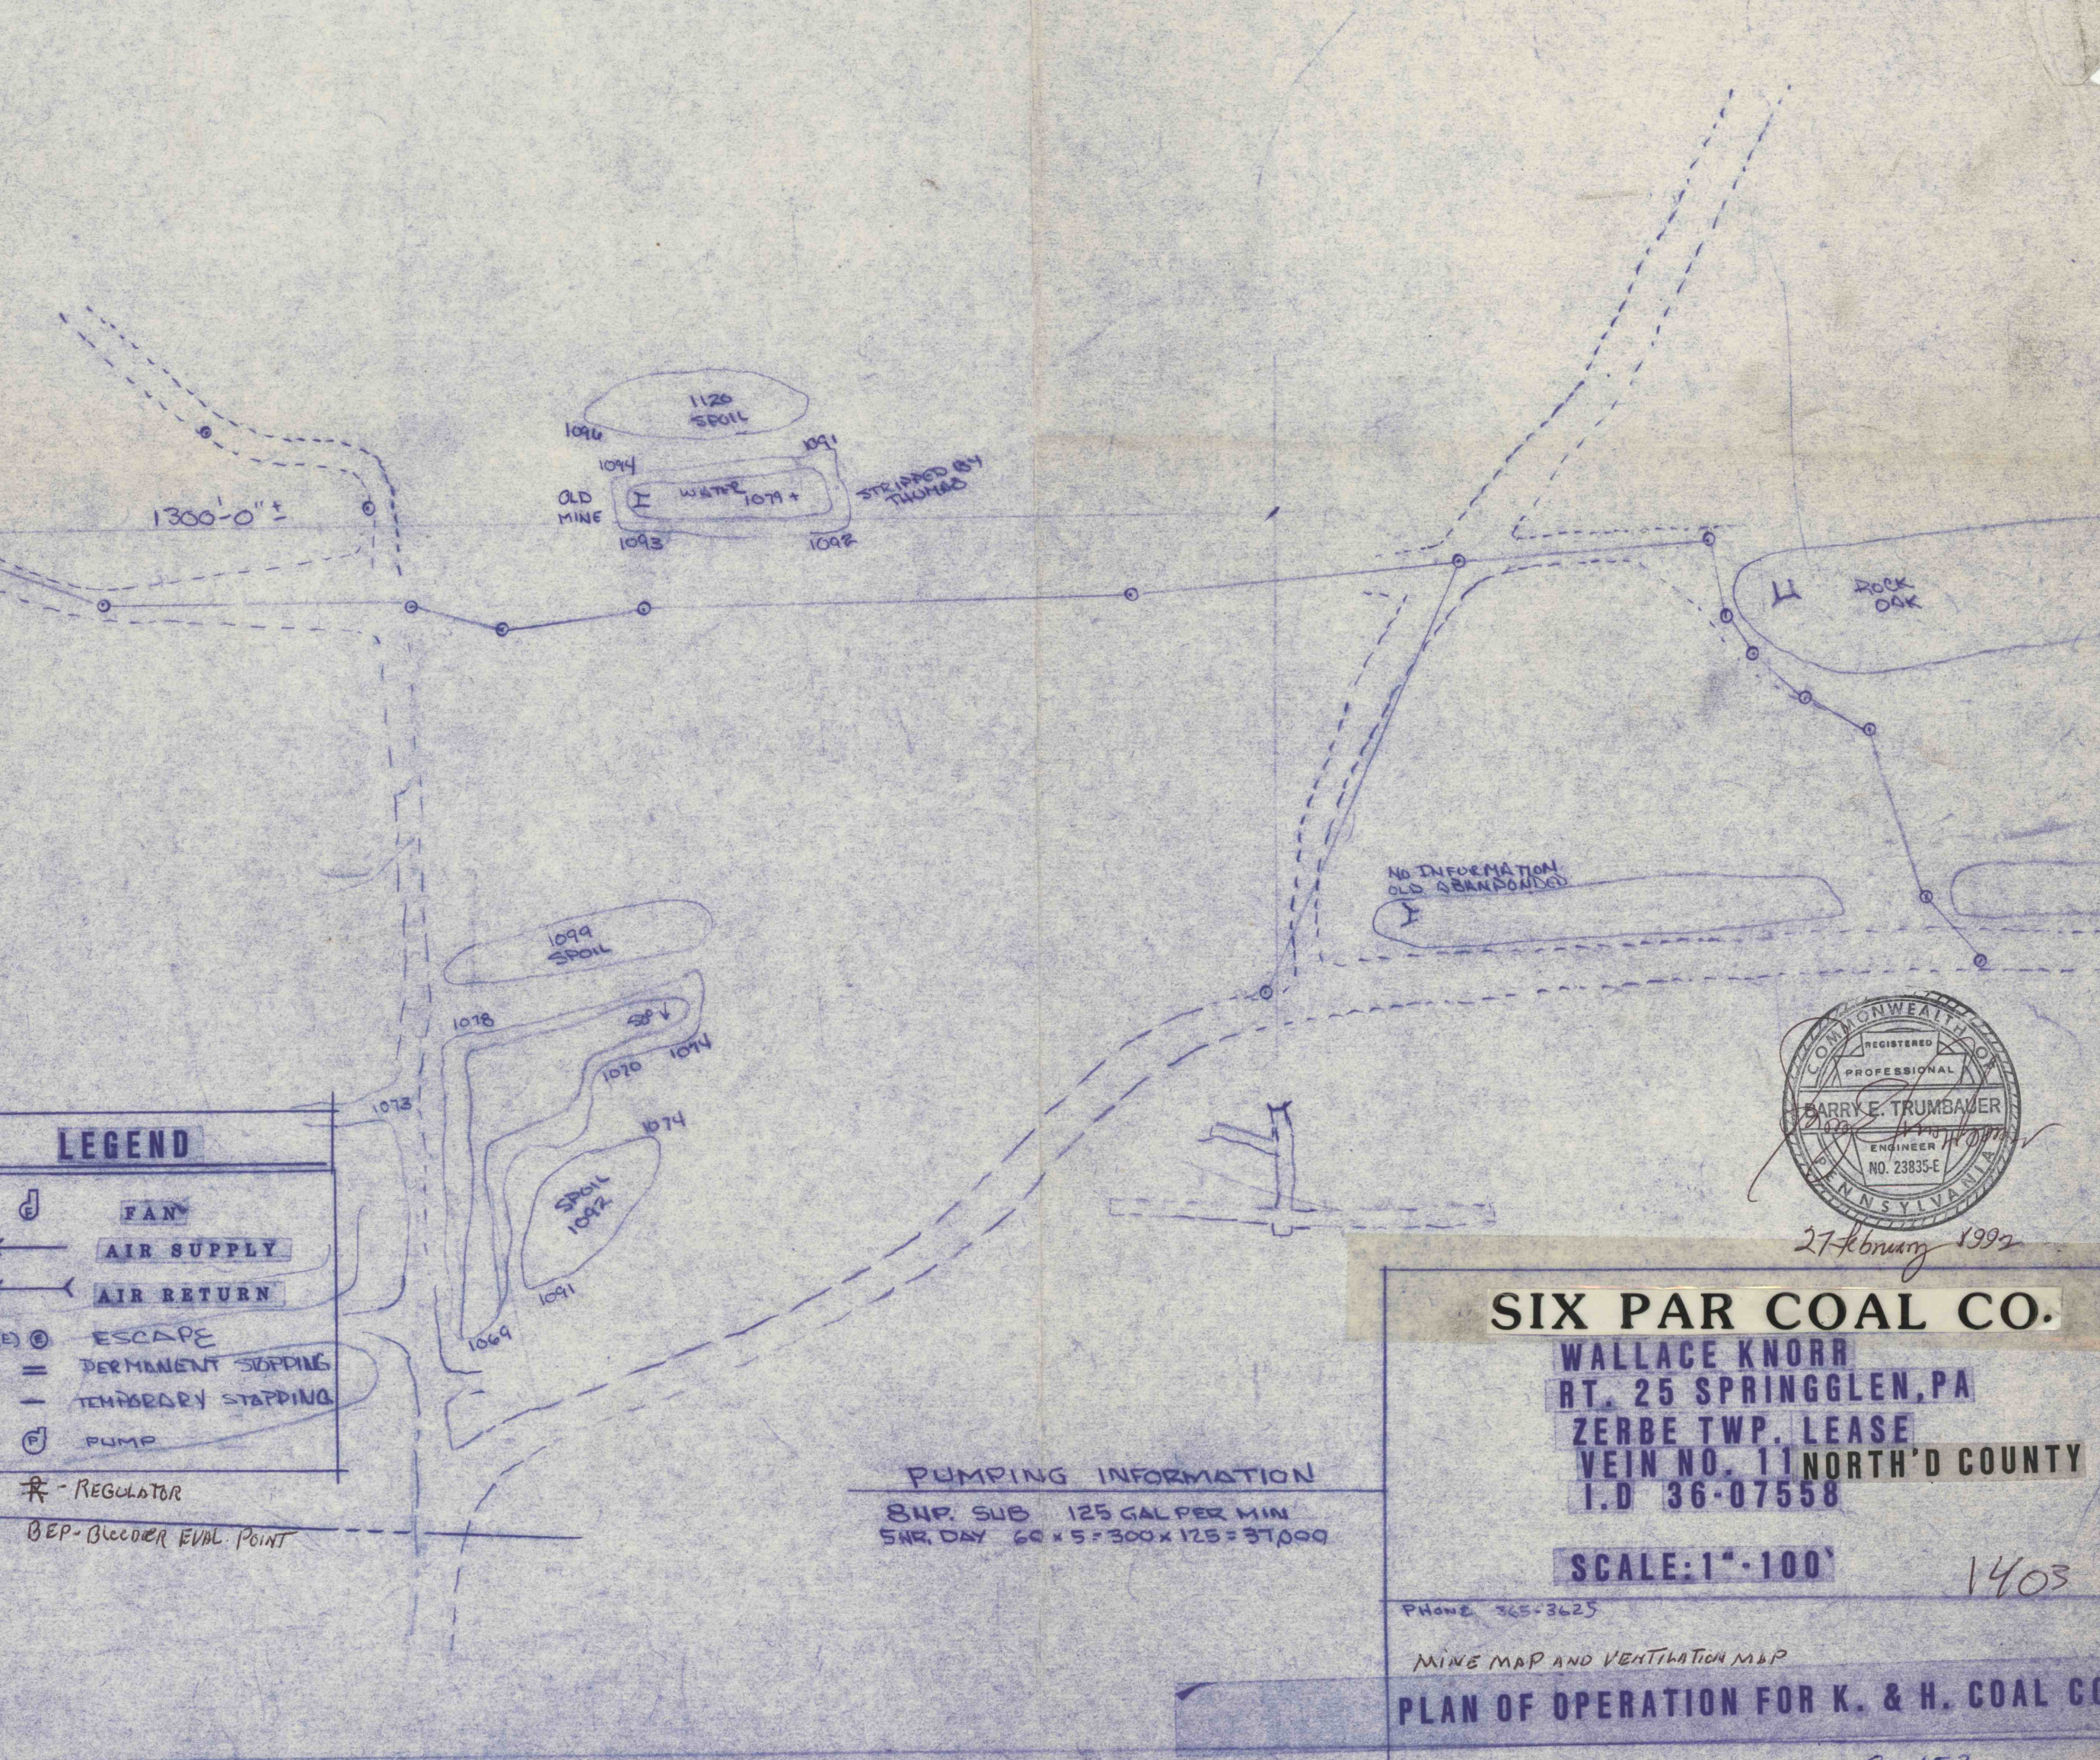
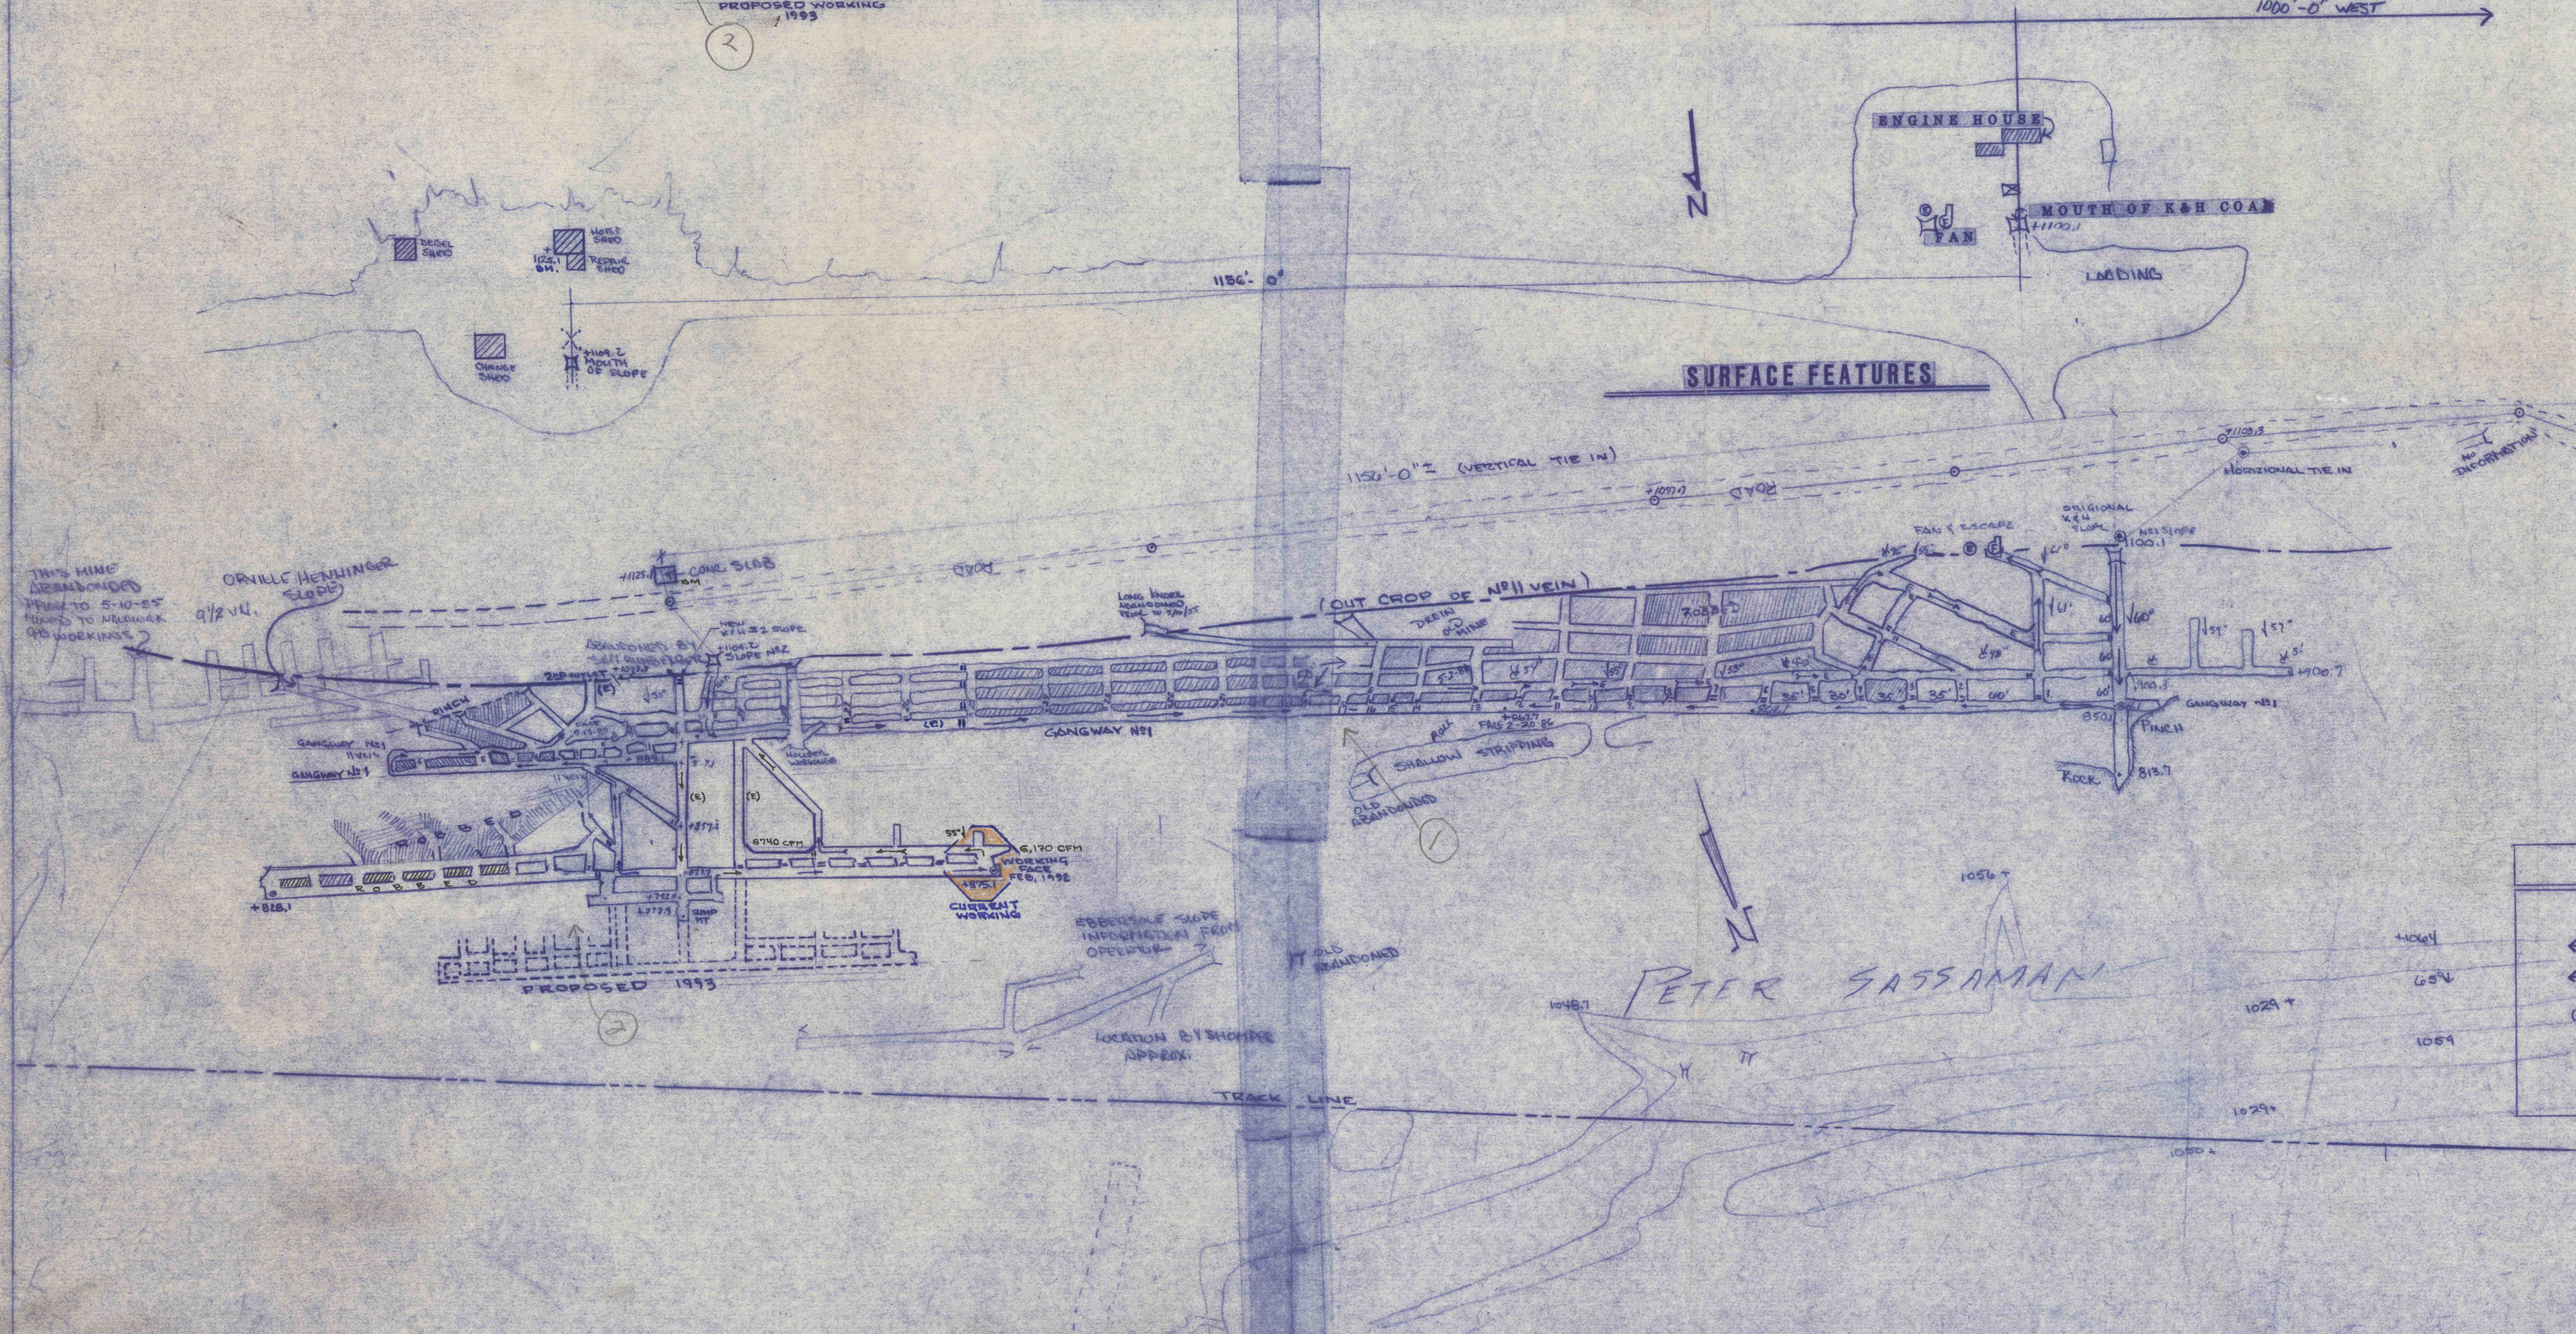
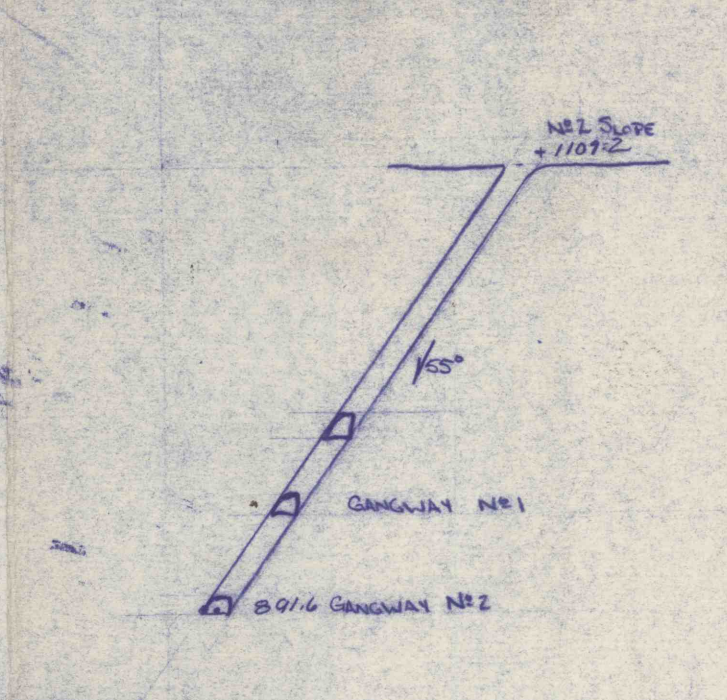
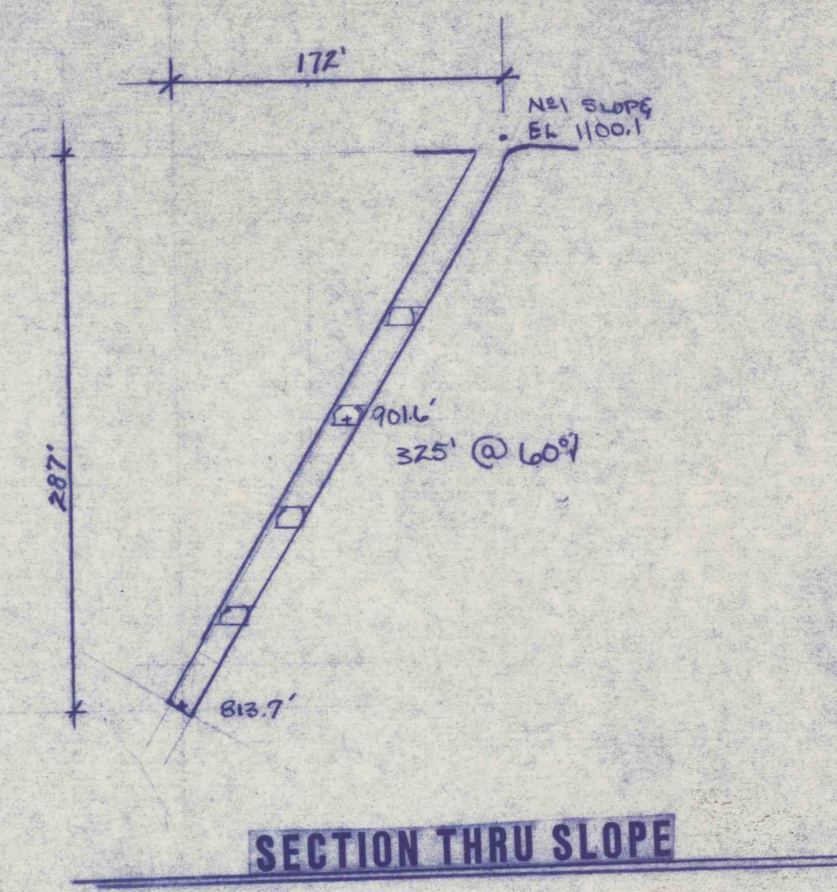


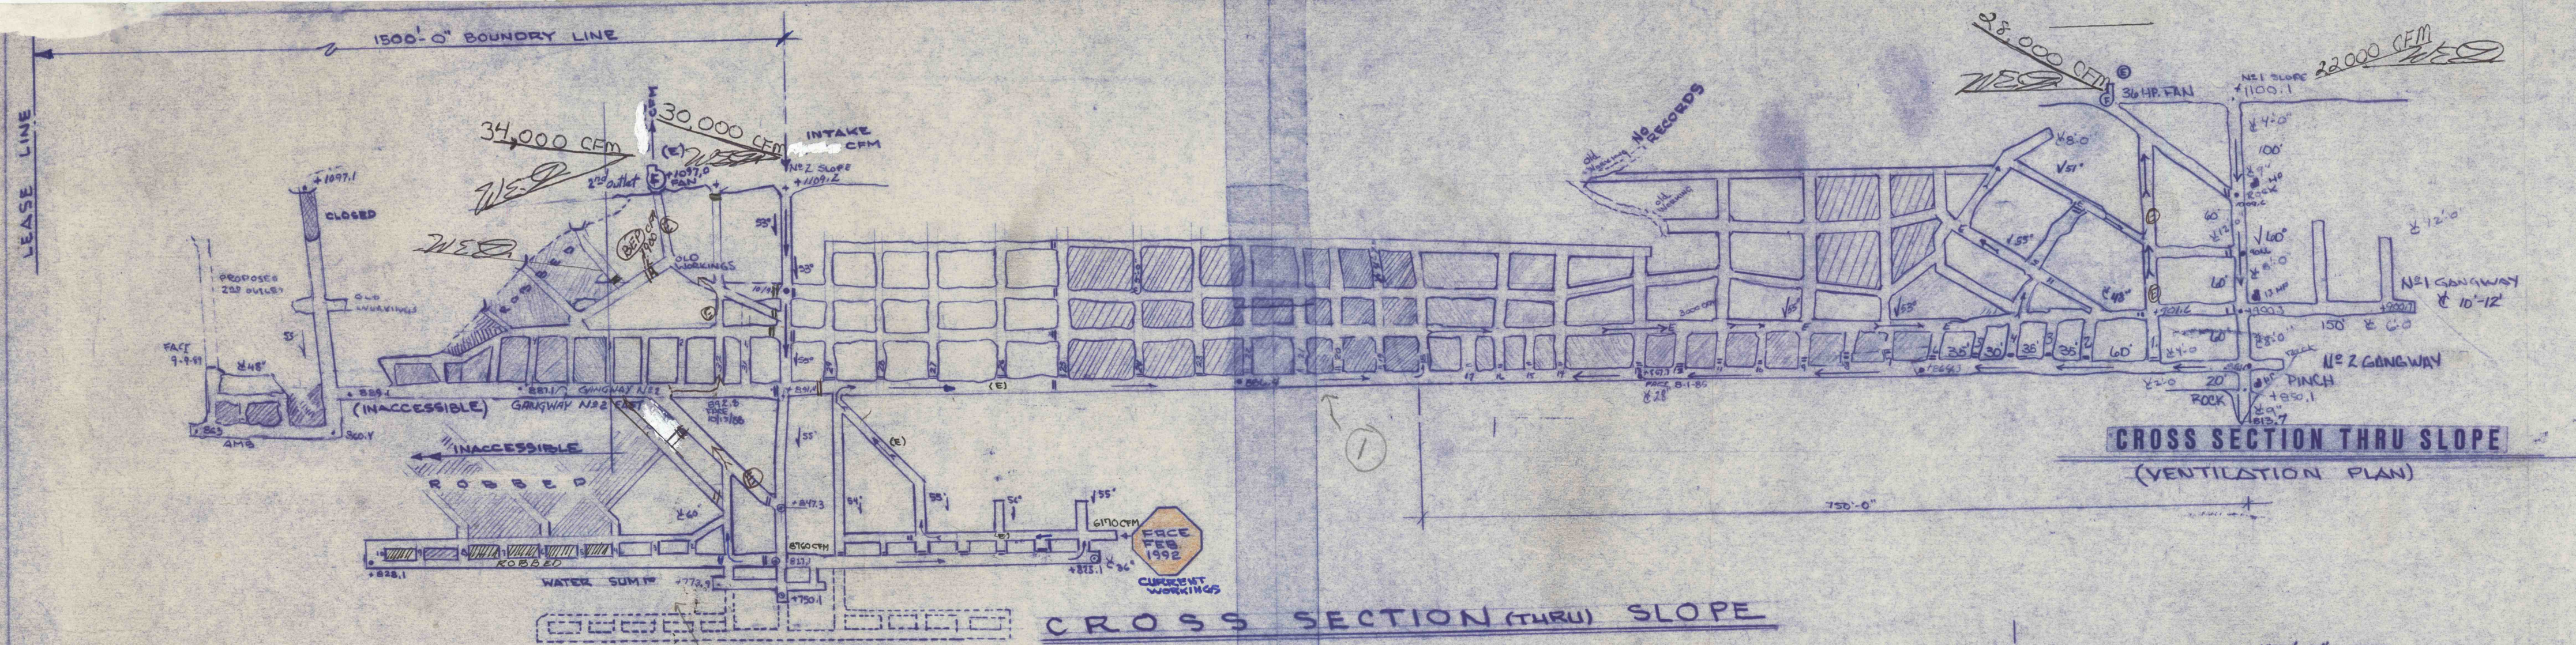


LEGEND	
	FAN
	AIR SUPPLY
	AIR RETURN
	ESCAPE
	PERMANENT STOPPAGE
	TEMPORARY STOPPAGE
	PUMP
	REGULATOR
	BEP - Breaker End Point

PUMPING INFORMATION
 SHP. SUB 125 GAL PER MIN
 SHP. DAY 60 x 5 = 300 x 125 = 37,500

SIX PAR COAL CO.
 WALLACE KNORR
 RT. 25 SPRINGGLEN, PA
 ZERBE TWP. LEASE
 VEIN NO. 11 NORTH'D COUNTY
 I.D. 36-07558
 SCALE: 1"=100'

Phone 365-3625
 MINE MAP AND VENTILATION MAP
 PLAN OF OPERATION FOR K. & H. COAL CO.

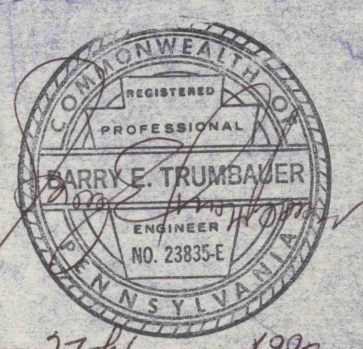

27 January 1992

1403

C-152