



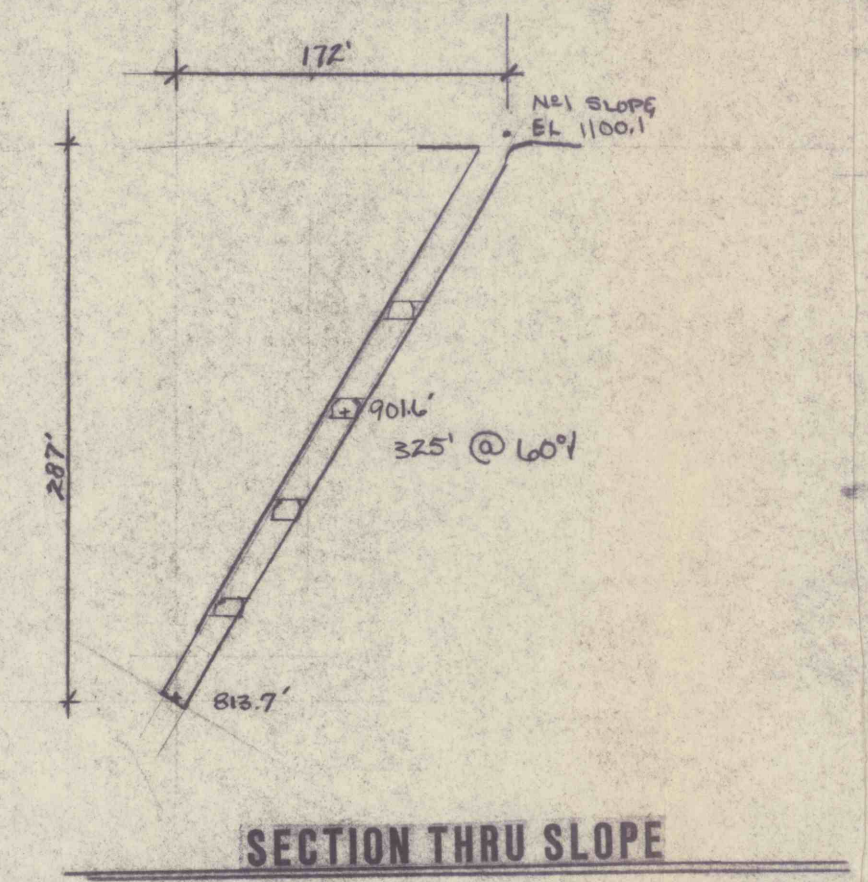

1000'-0" EAST 1000'-0" WEST

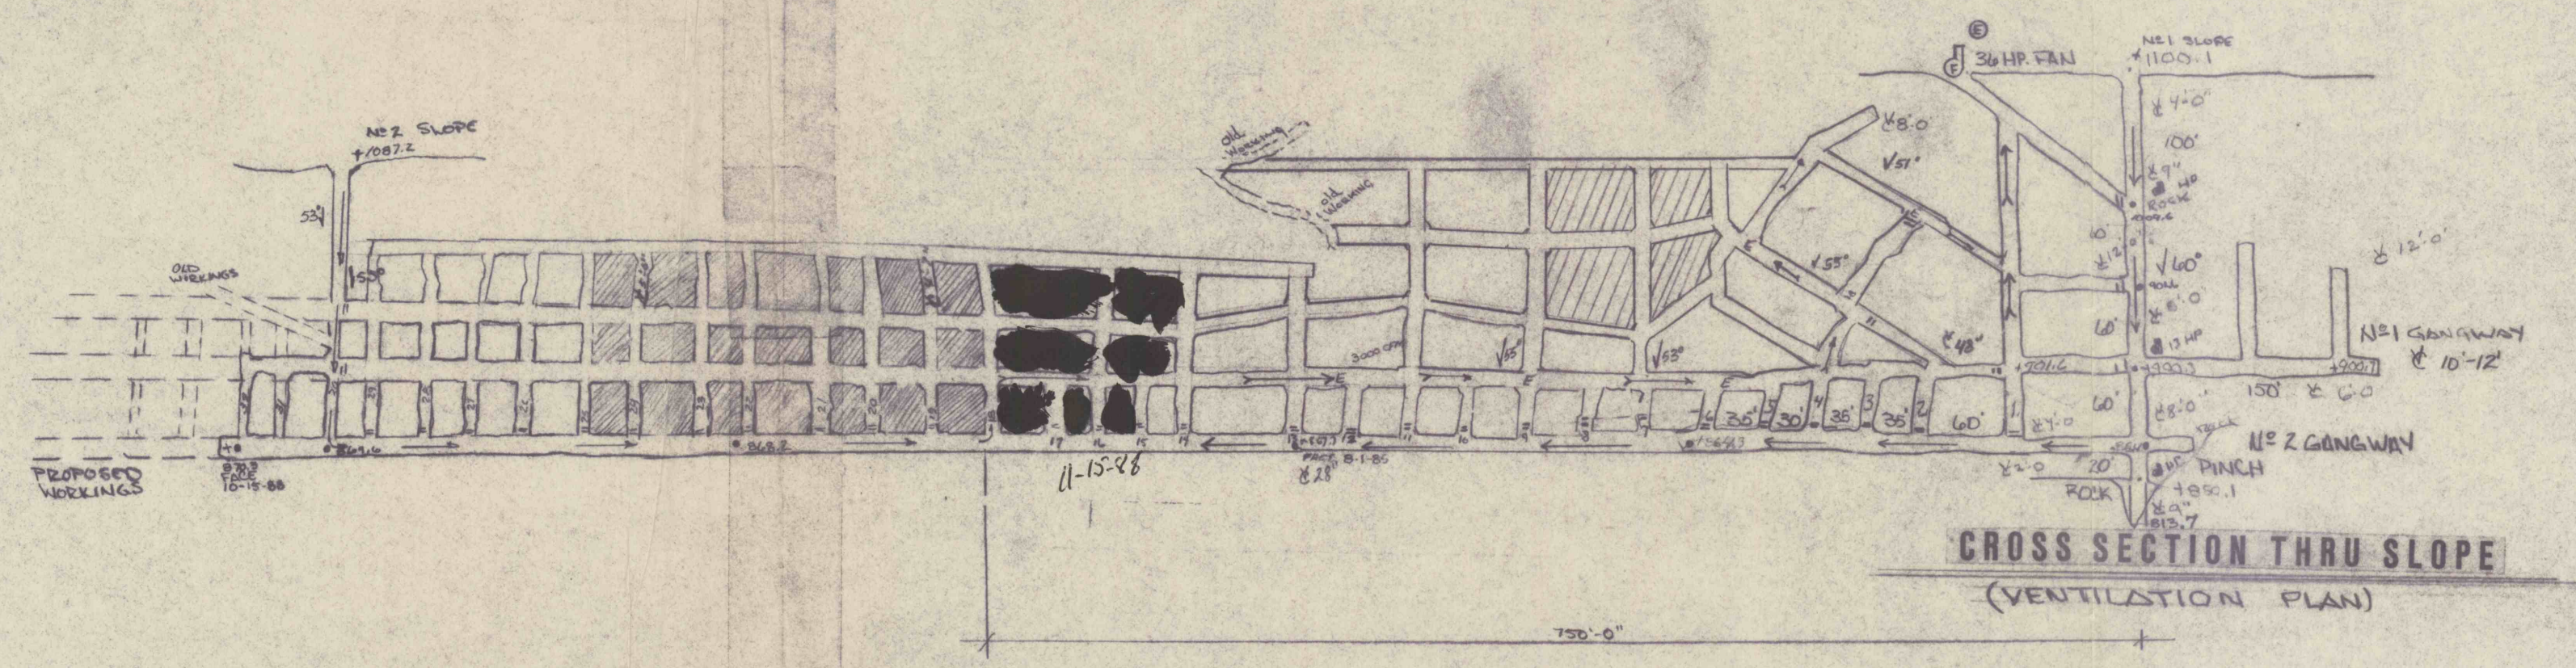