




MINE MAP
SHOWING NONAGGI COAL TO SLOPE
IN THE MARY METZ TRACT IN
BLYTHE TOWNSHIP, SCH. CO. PA.
SURVEYED MARCH 30, 1931 SCALE 1"=200'
WALTER J. MANHART R.S. 14708E

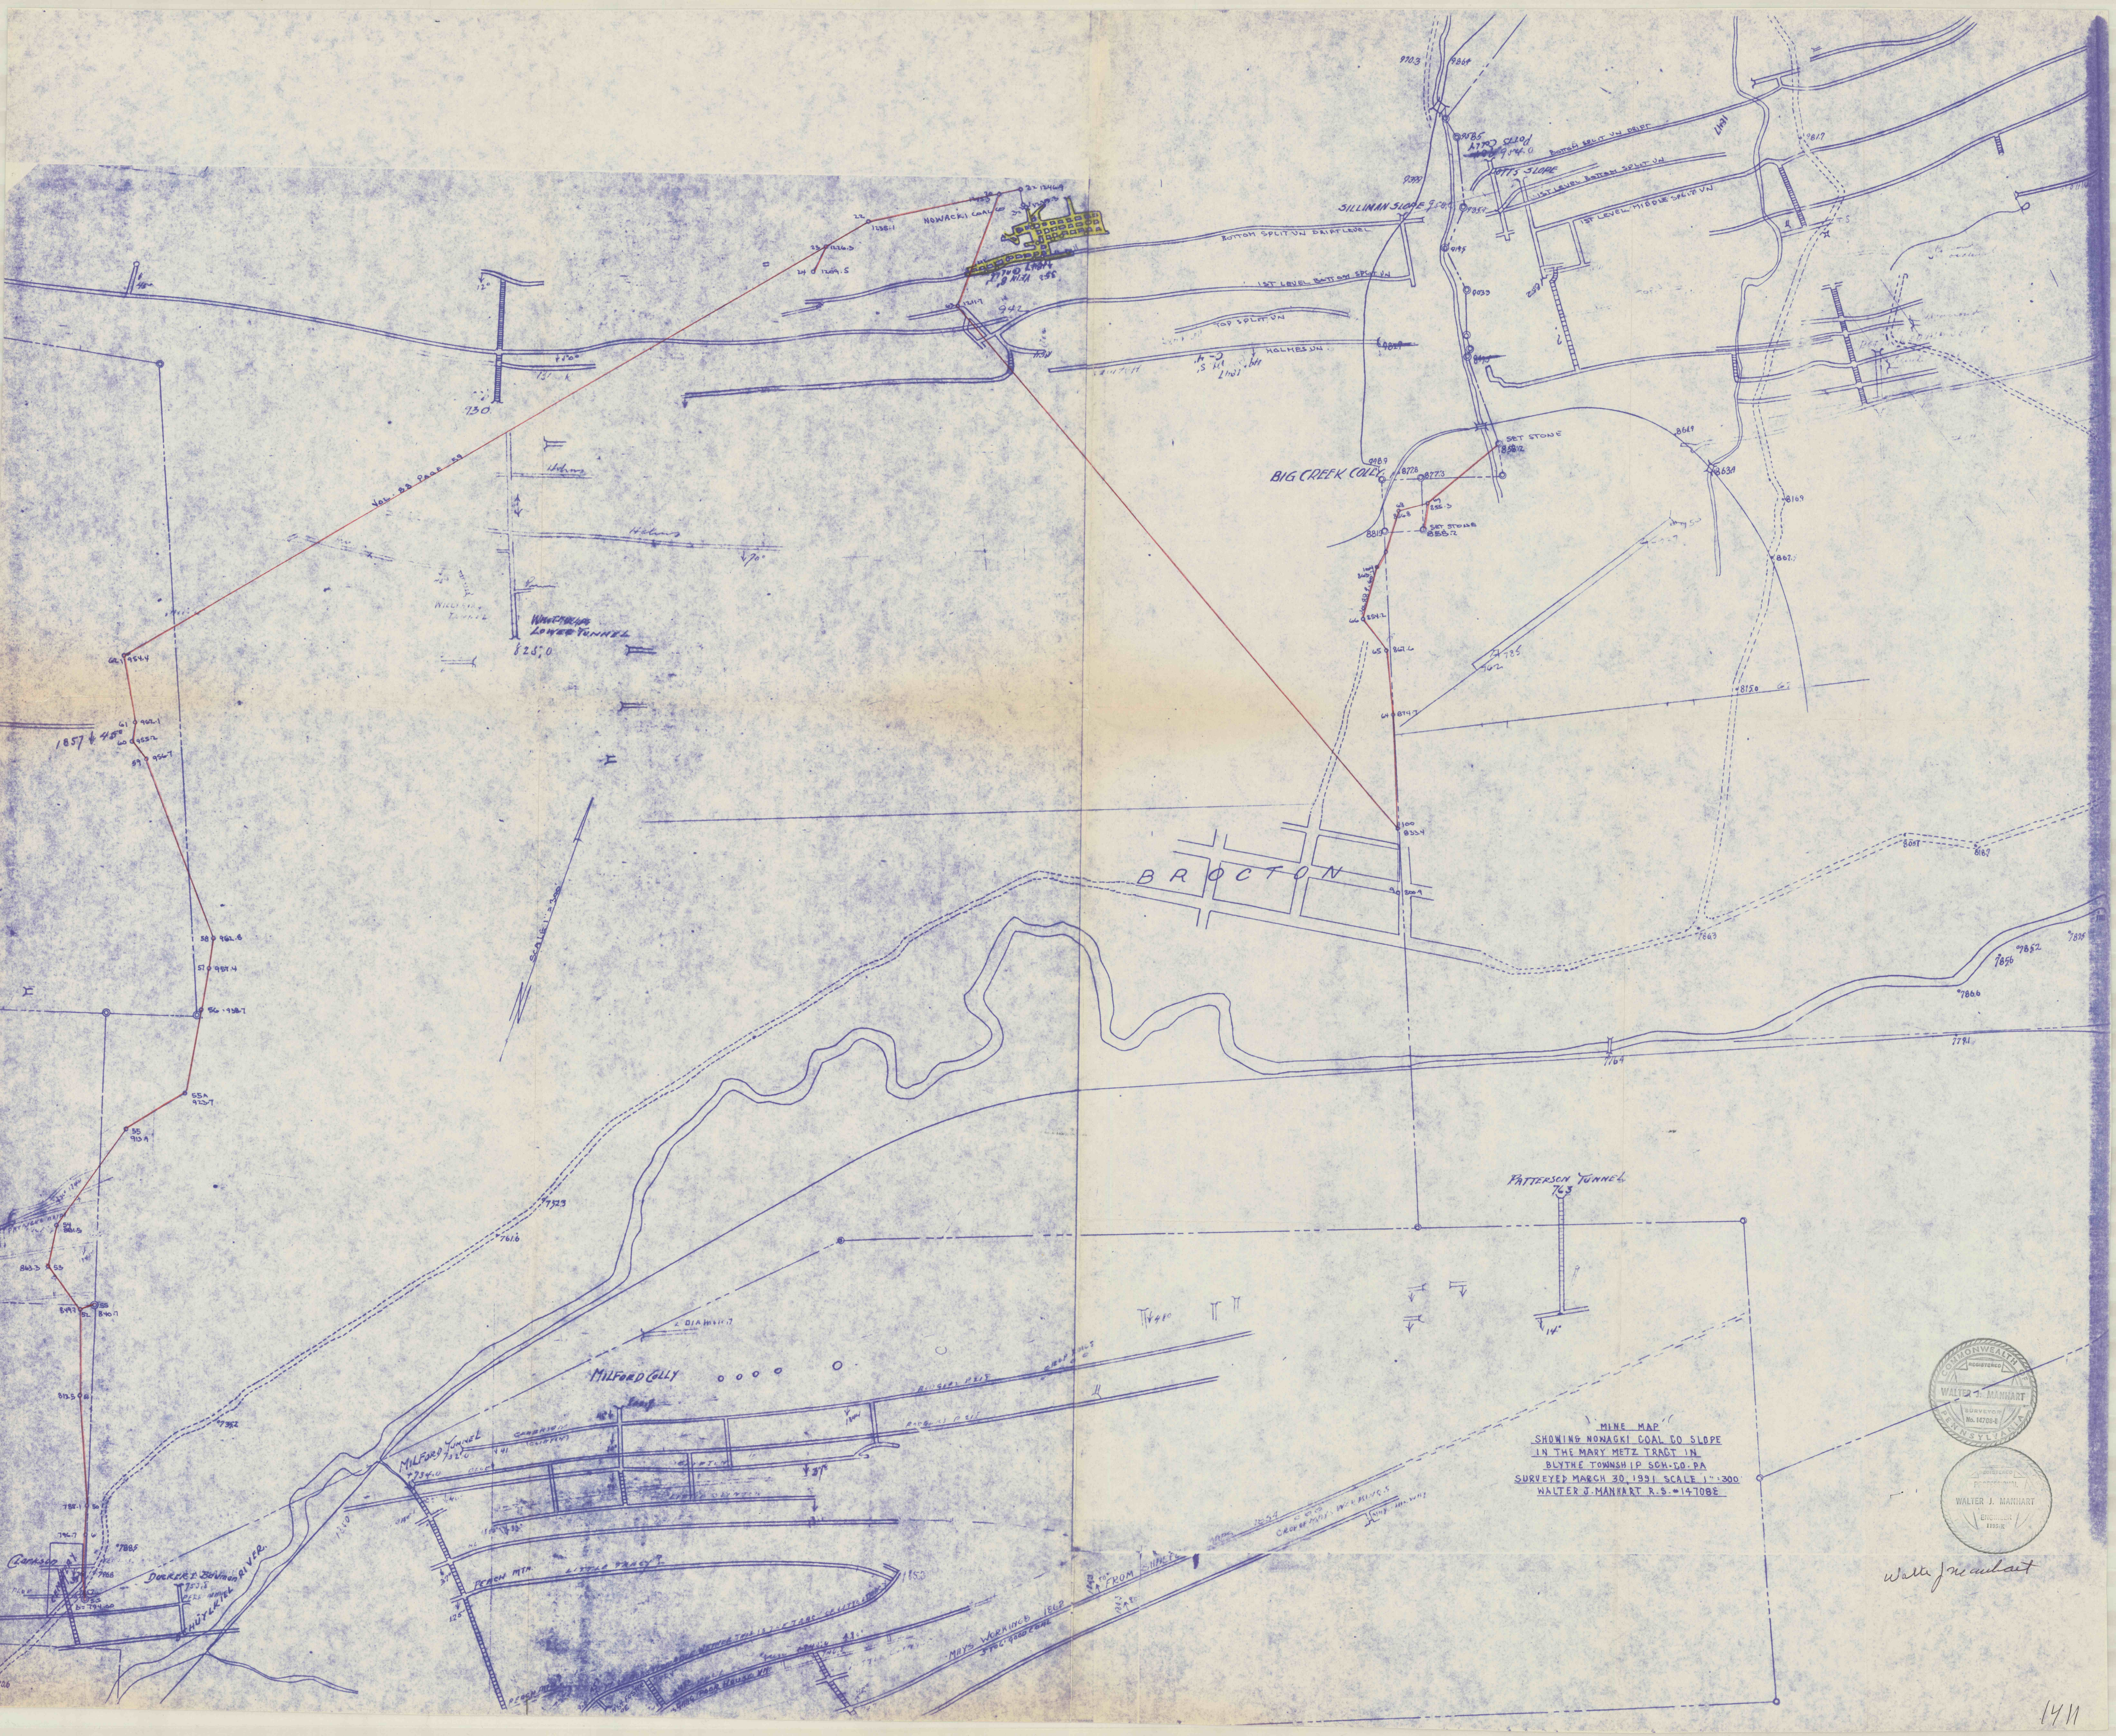

Walter J. Manhart