MINED BY:- NOWACKI COAL COMPANY

ID # 36-07592

THERE IS NO POOLED WATER ON THE SURFACE WITHIN THE MAPPED AREA

THE SUBSURFACE WATER LEVELS ARE AT LOCATIONS AND ELEVATIONS SHOWN ON MAP

THERE ARE NO RR. OR PAVED ROADWAYS LEADING TO THE MINE. ACCESS IS FROM THE DIRT ROAD OUTLINED ON THE MAP PERMINENT BUILDINGS ON THE SITE CONSIST OF THE HOIST HOUSE AND SURFACE FAN, SHOWN ON THE MAP

SURFACE SURVEY TIE IN POINTS ARE PINNED STAKES AT LOCATIONS SHOWN ON THE MAP.

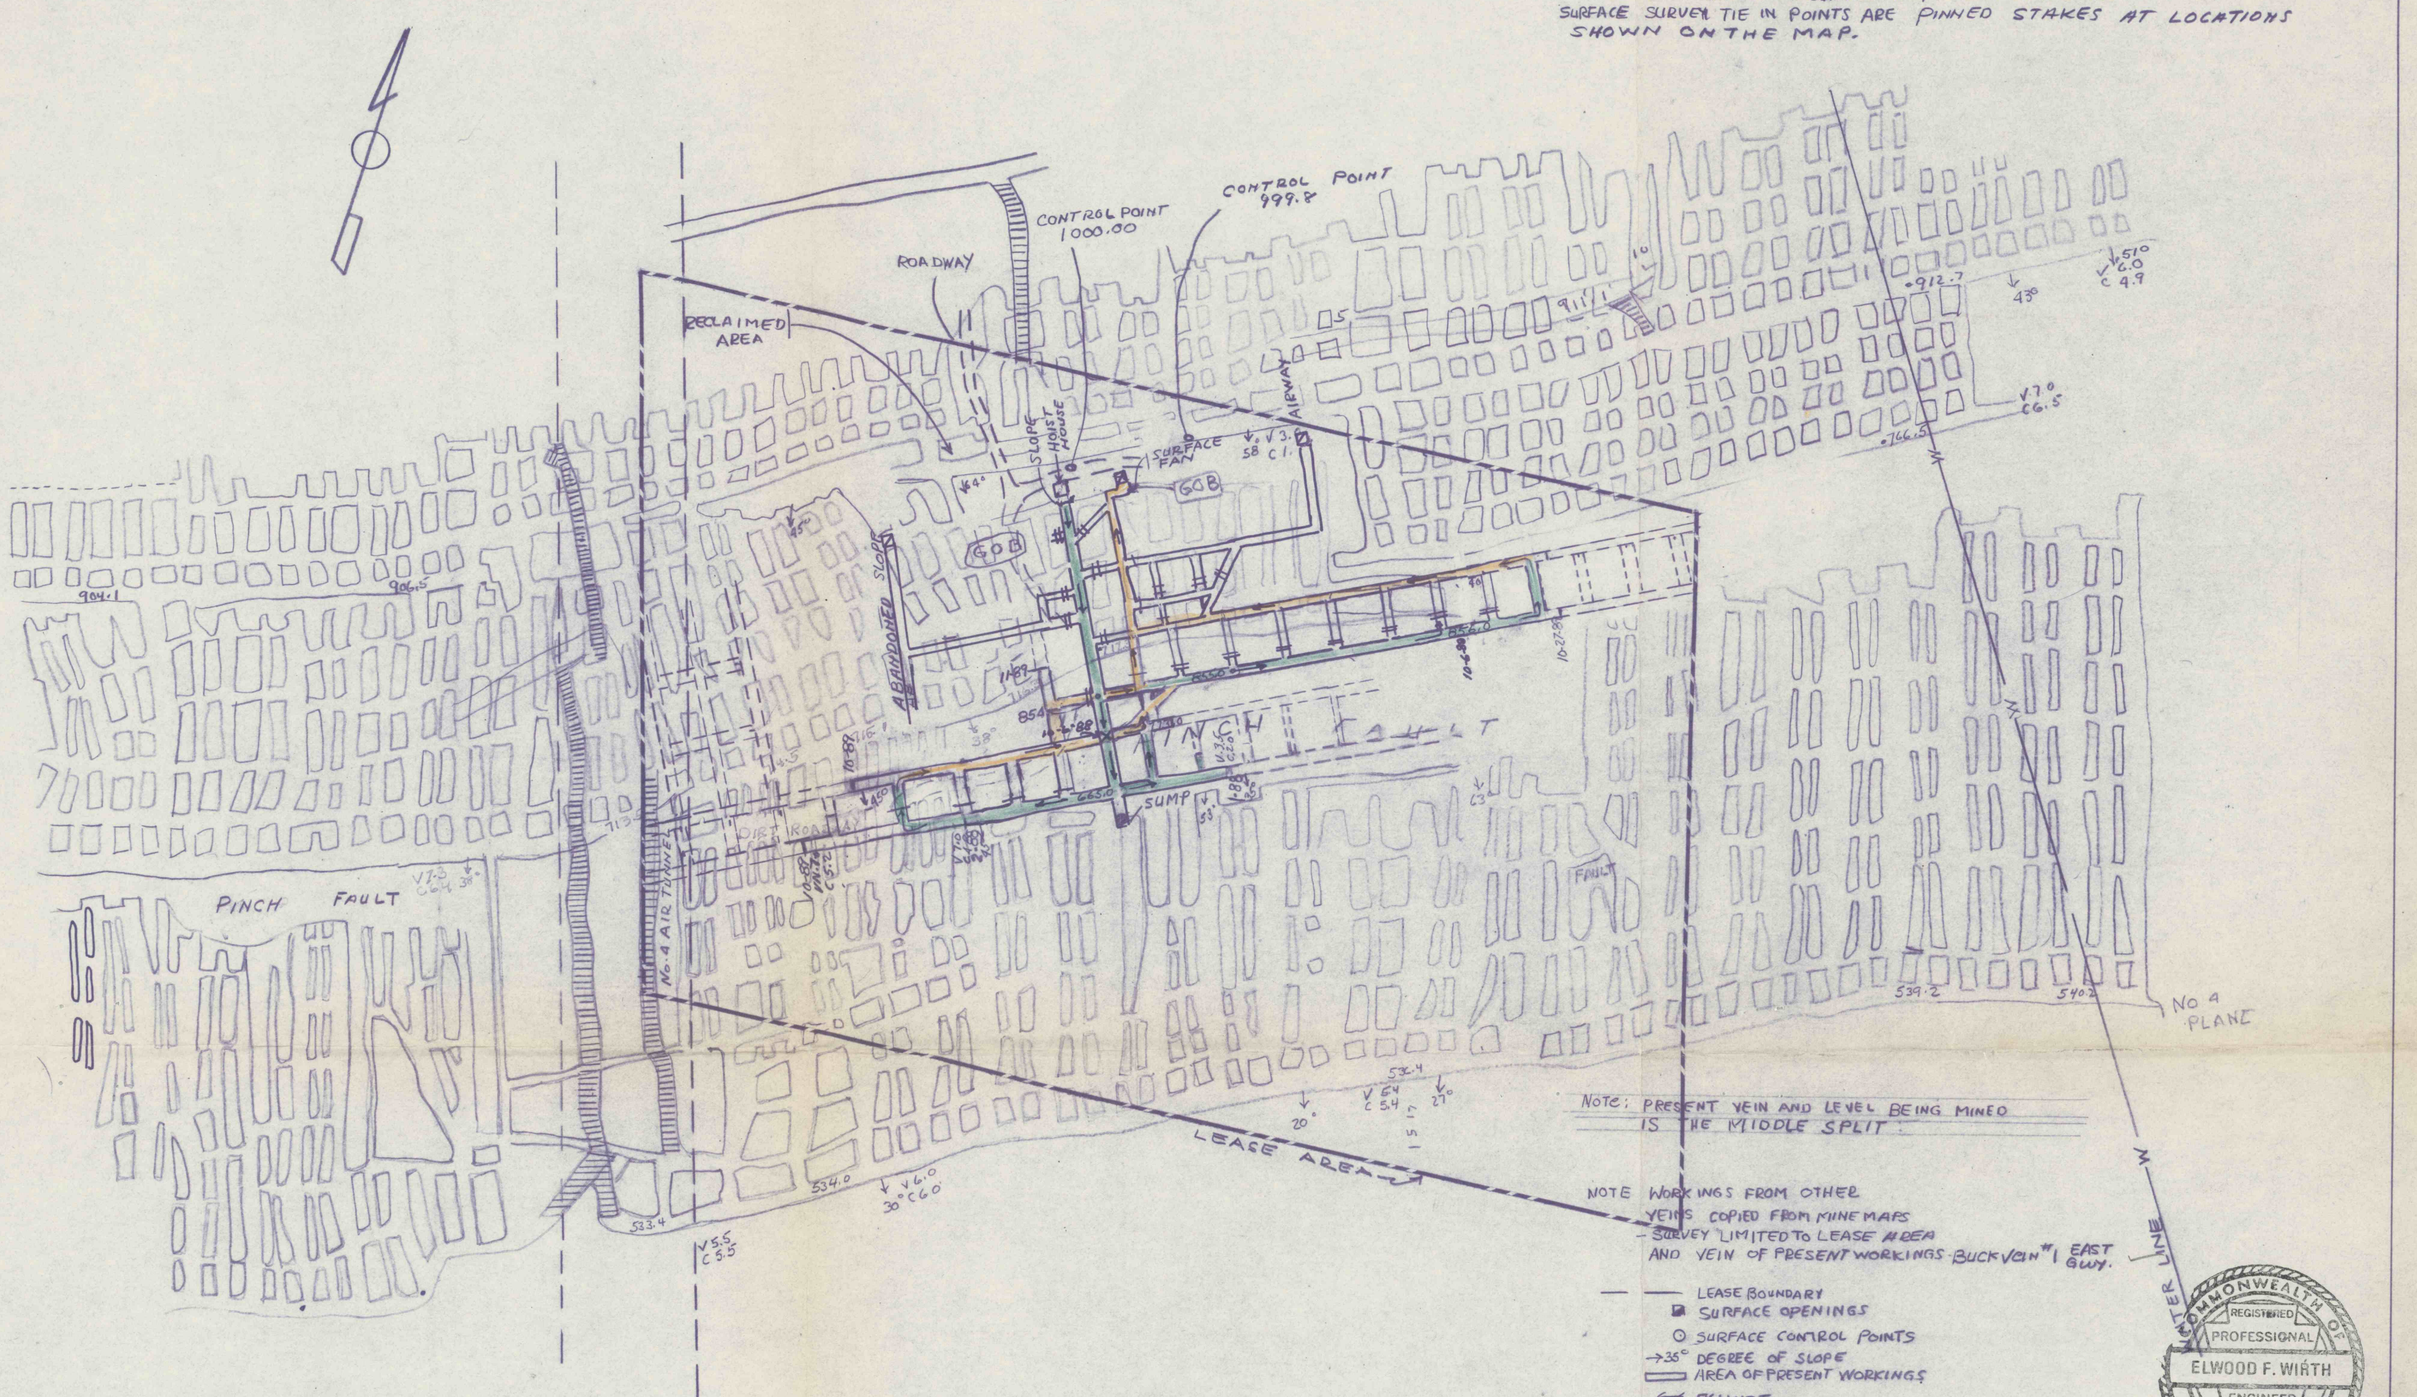

NOTE: PRESENT VEIN AND LEVEL BEING MINED IS THE MIDDLE SPLIT.

NOTE WORKINGS FROM OTHER VEINS COPIED FROM MINE MAPS - SURVEY LIMITED TO LEASE AREA AND VEIN OF PRESENT WORKINGS BUCK VEIN #1 EAST GWY.

- LEASE BOUNDARY
- SURFACE OPENINGS
- SURFACE CONTROL POINTS
- →35° DEGREE OF SLOPE
- AREA OF PRESENT WORKINGS
- EXHUST
- INTAKE
- PERMANENT STOPPINGS
- TEMPORARY STOPPINGS

COMMONWEALTH OF PENNSYLVANIA
REGISTERED PROFESSIONAL
ELWOOD F. WIRTH
ENGINEER No. 642-K

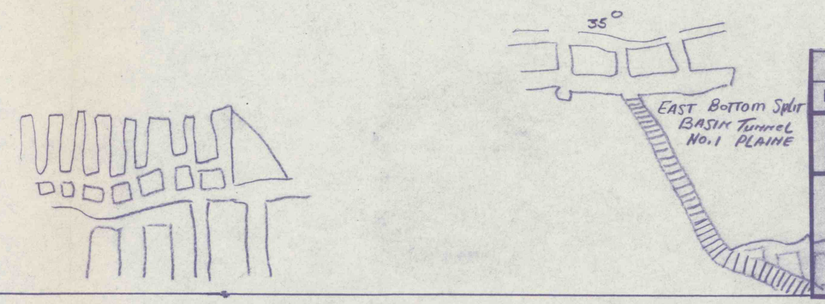

PROPOSED 1 YEAR PROJECTION

REVISIONS 11-24-86 - 11-24-87 - 11-8-88 - 11-27-89

NOWACKI COAL COMPANY 36-07592

LEASE No 7A - MARY MERTZ TRACT
SCHUYLKILL COUNTY PA.

NOWACKI COAL COMPANY SLOPE

JOB NO: # 88-1
DATE: 11-8-88
SCALE: 1" = 100'
DRAWN: E.F.W
APPROVED:

L.L-2A/24