


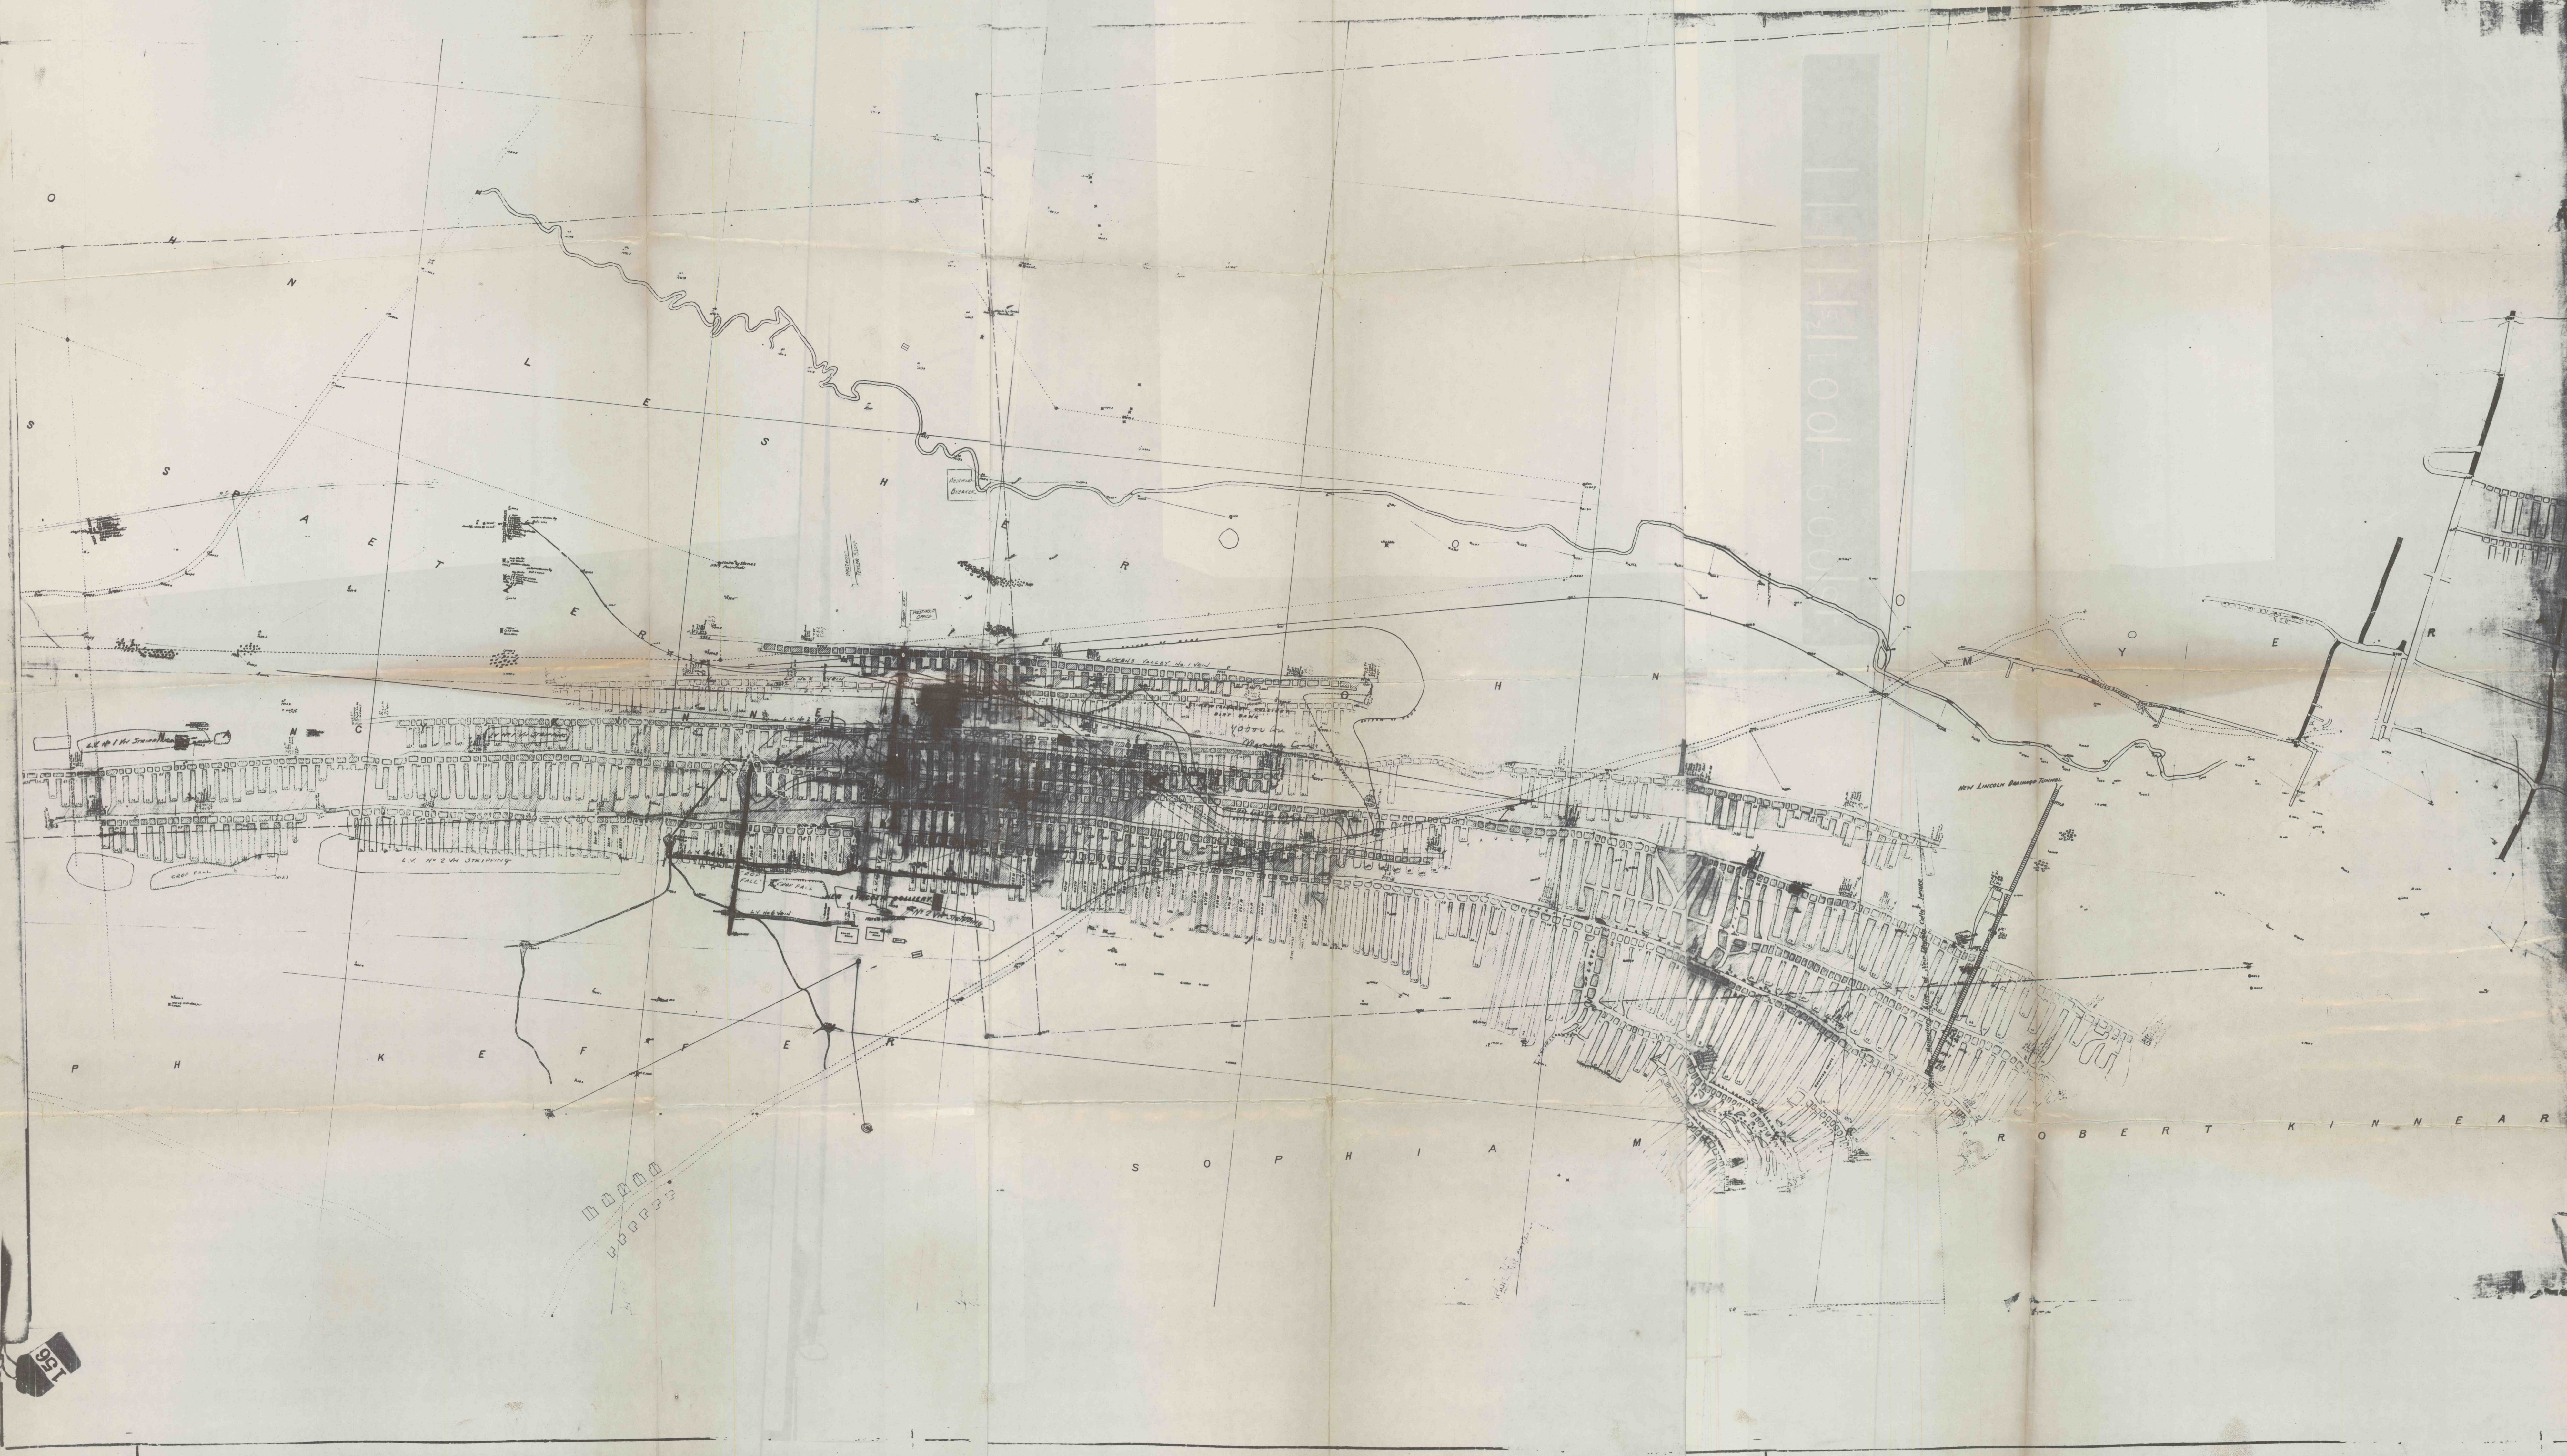

1001-6001

156

ROBERT KINNEN