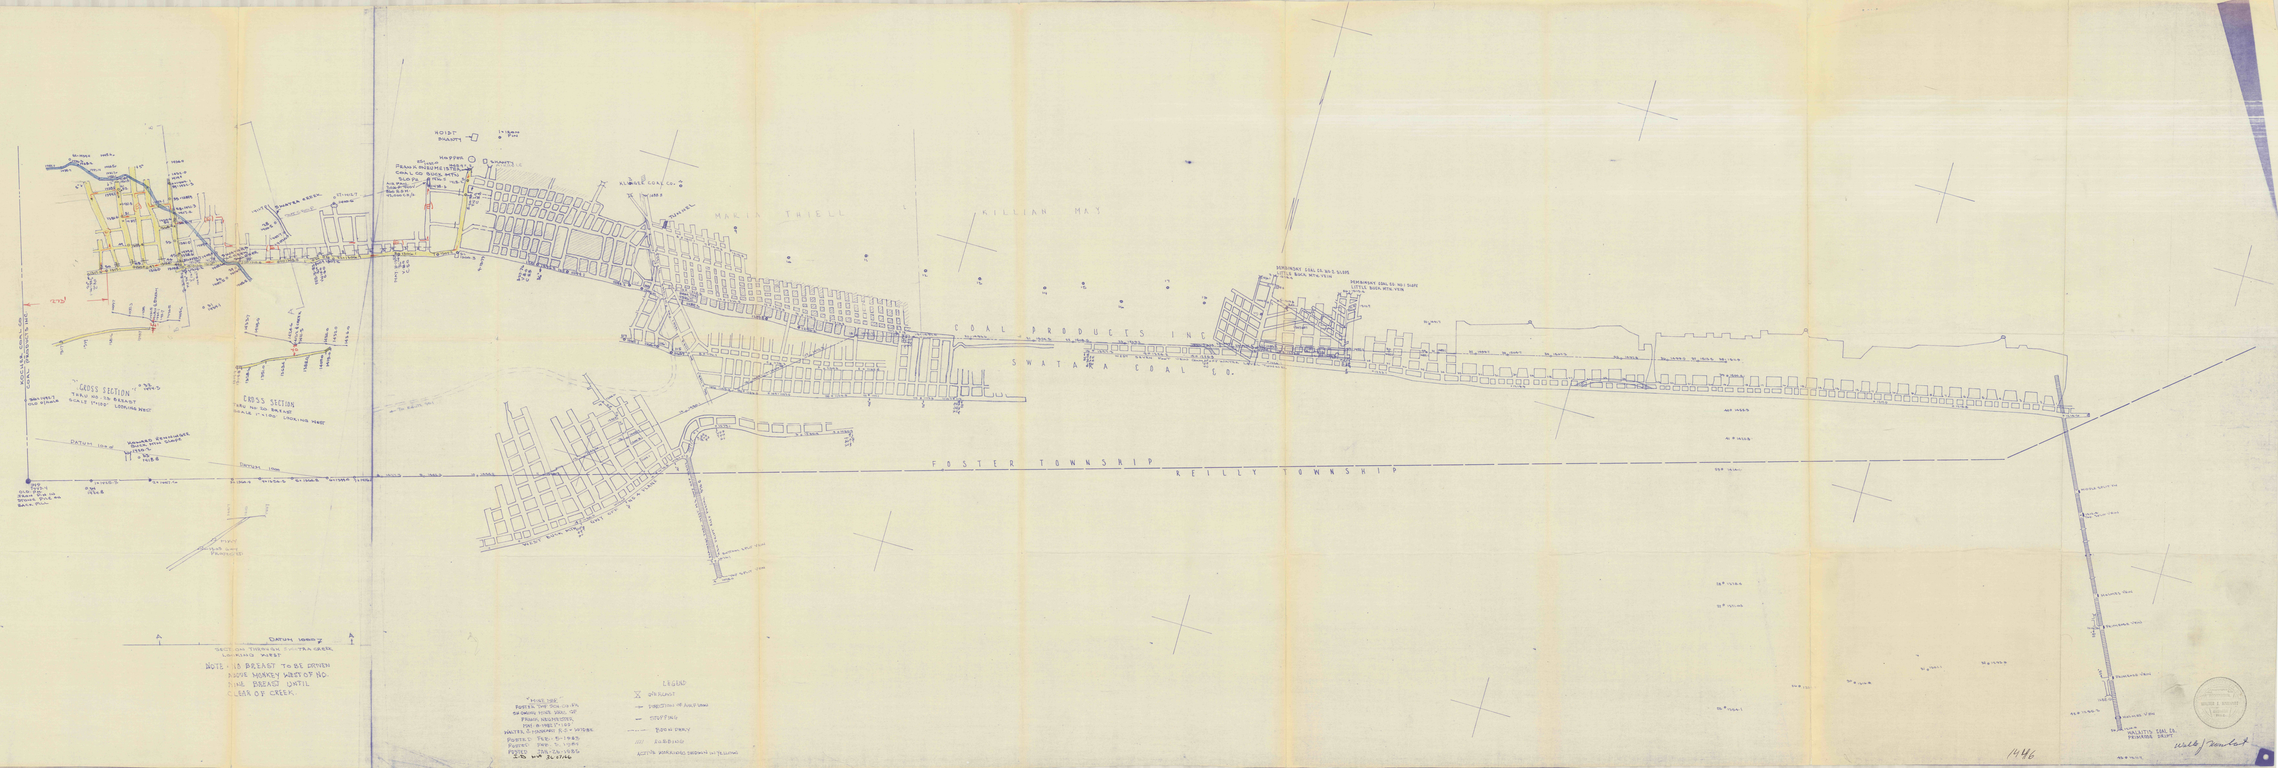
MARIA THIELL
KILLIAN MAY
COAL PRODUCTS INC.
SWATARA COAL CO.
FOSTER TOWNSHIP
REILLY TOWNSHIP
CROSS SECTION
CROSS SECTION
NOTE: 15 BREAST TO BE DRIVEN
ABOVE MONKEY WAY OF NO.
9 & BREAST UNTIL
CLEAR OF CREEK.
LEGEND
1146