


MINING PLAN

- FAN
- ⊕ BRAG LINE
- BATTERIES
- AIR INTAKE
- AIR RETURN
- ⌞⌞⌞⌞ 50 FT. PILLOW
- - - - - PROPOSED MINING

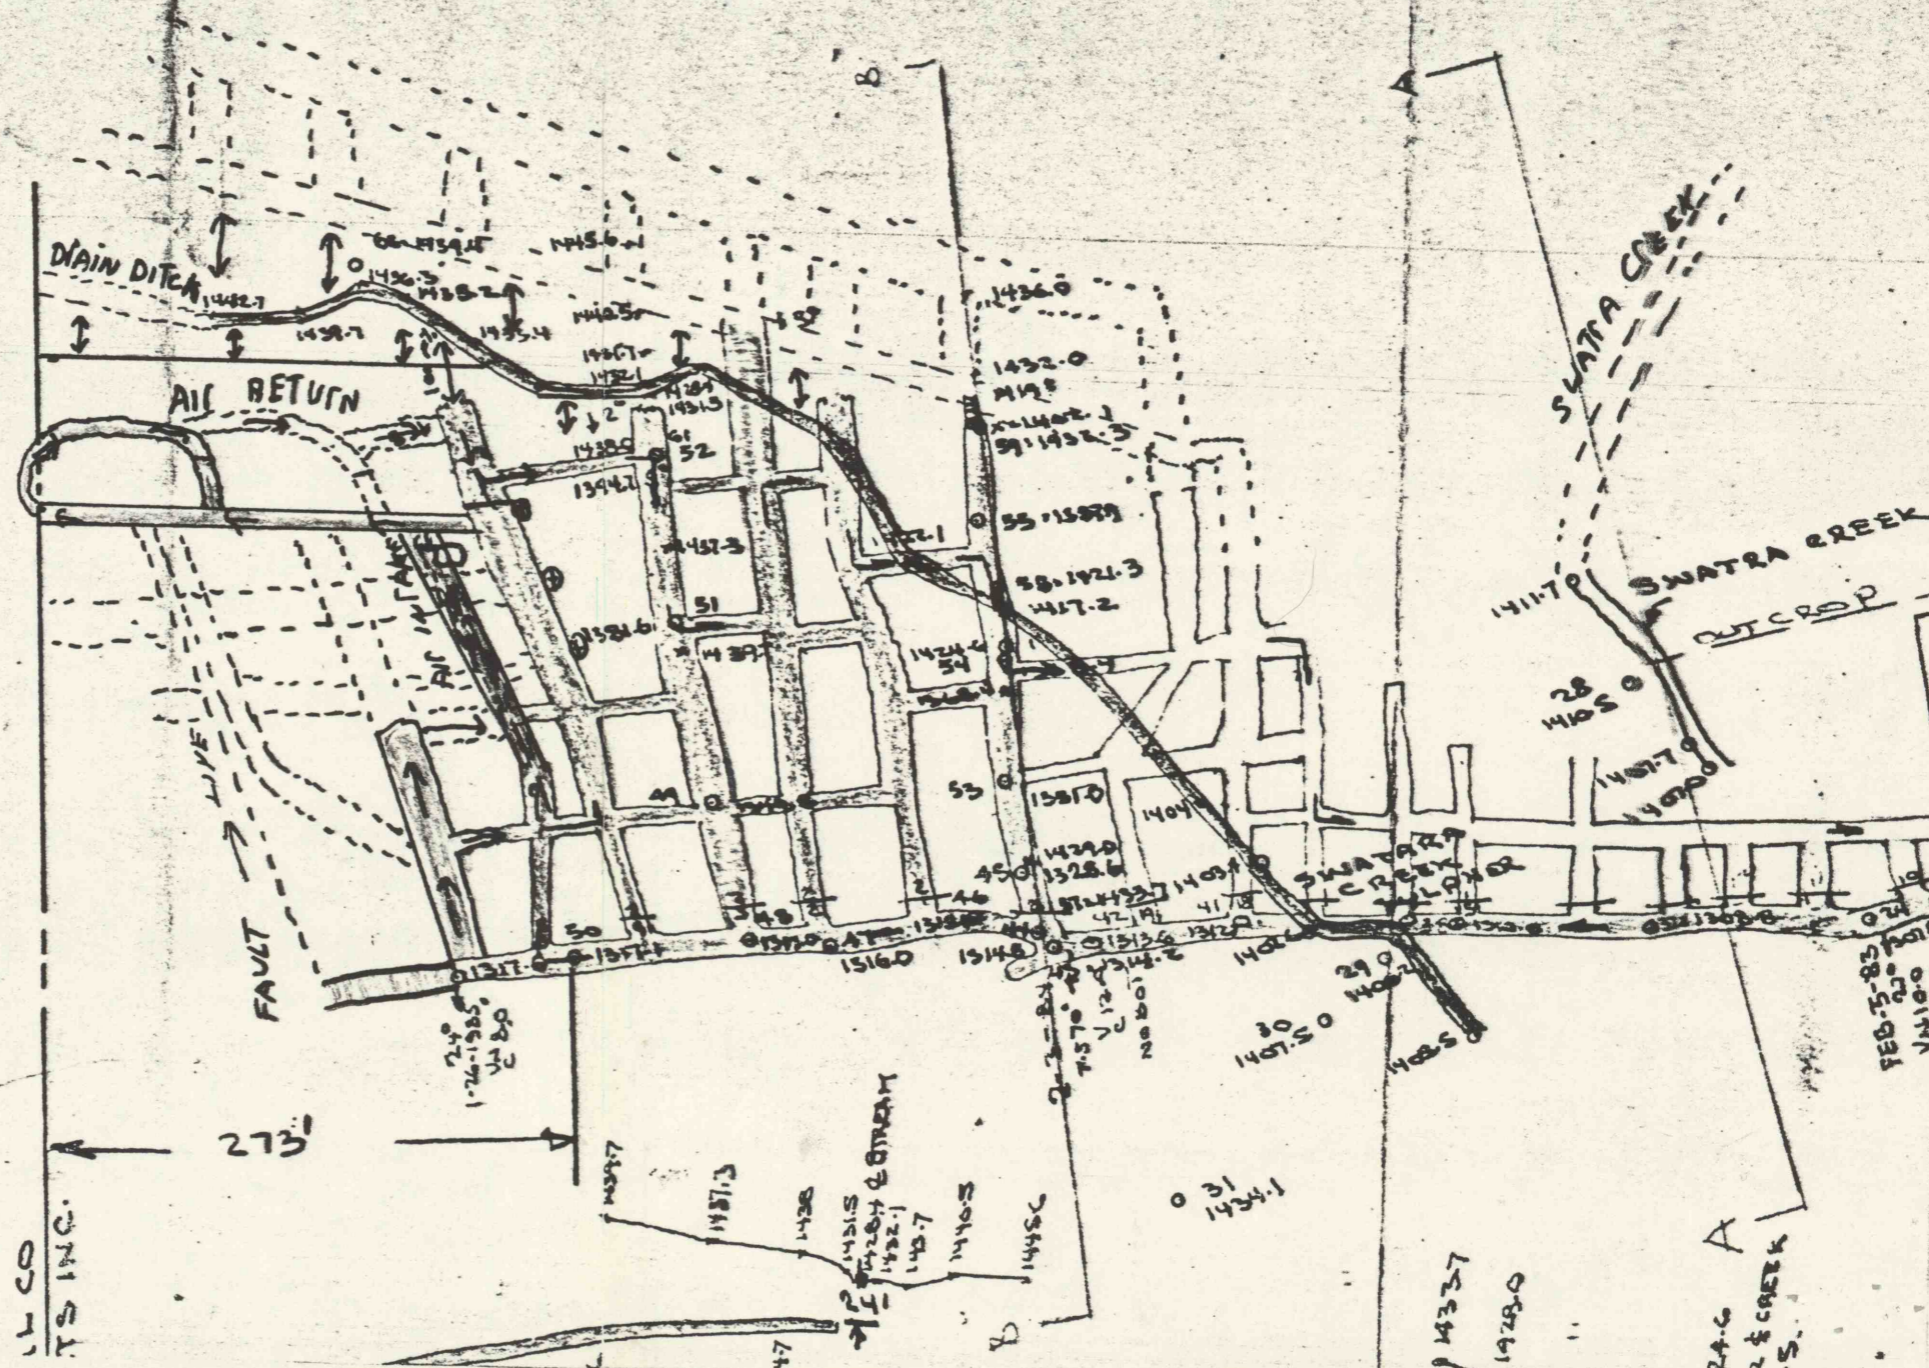

 J. W. CO.

24.6
 2.5 CREEK
 .5

14337
 1928.0