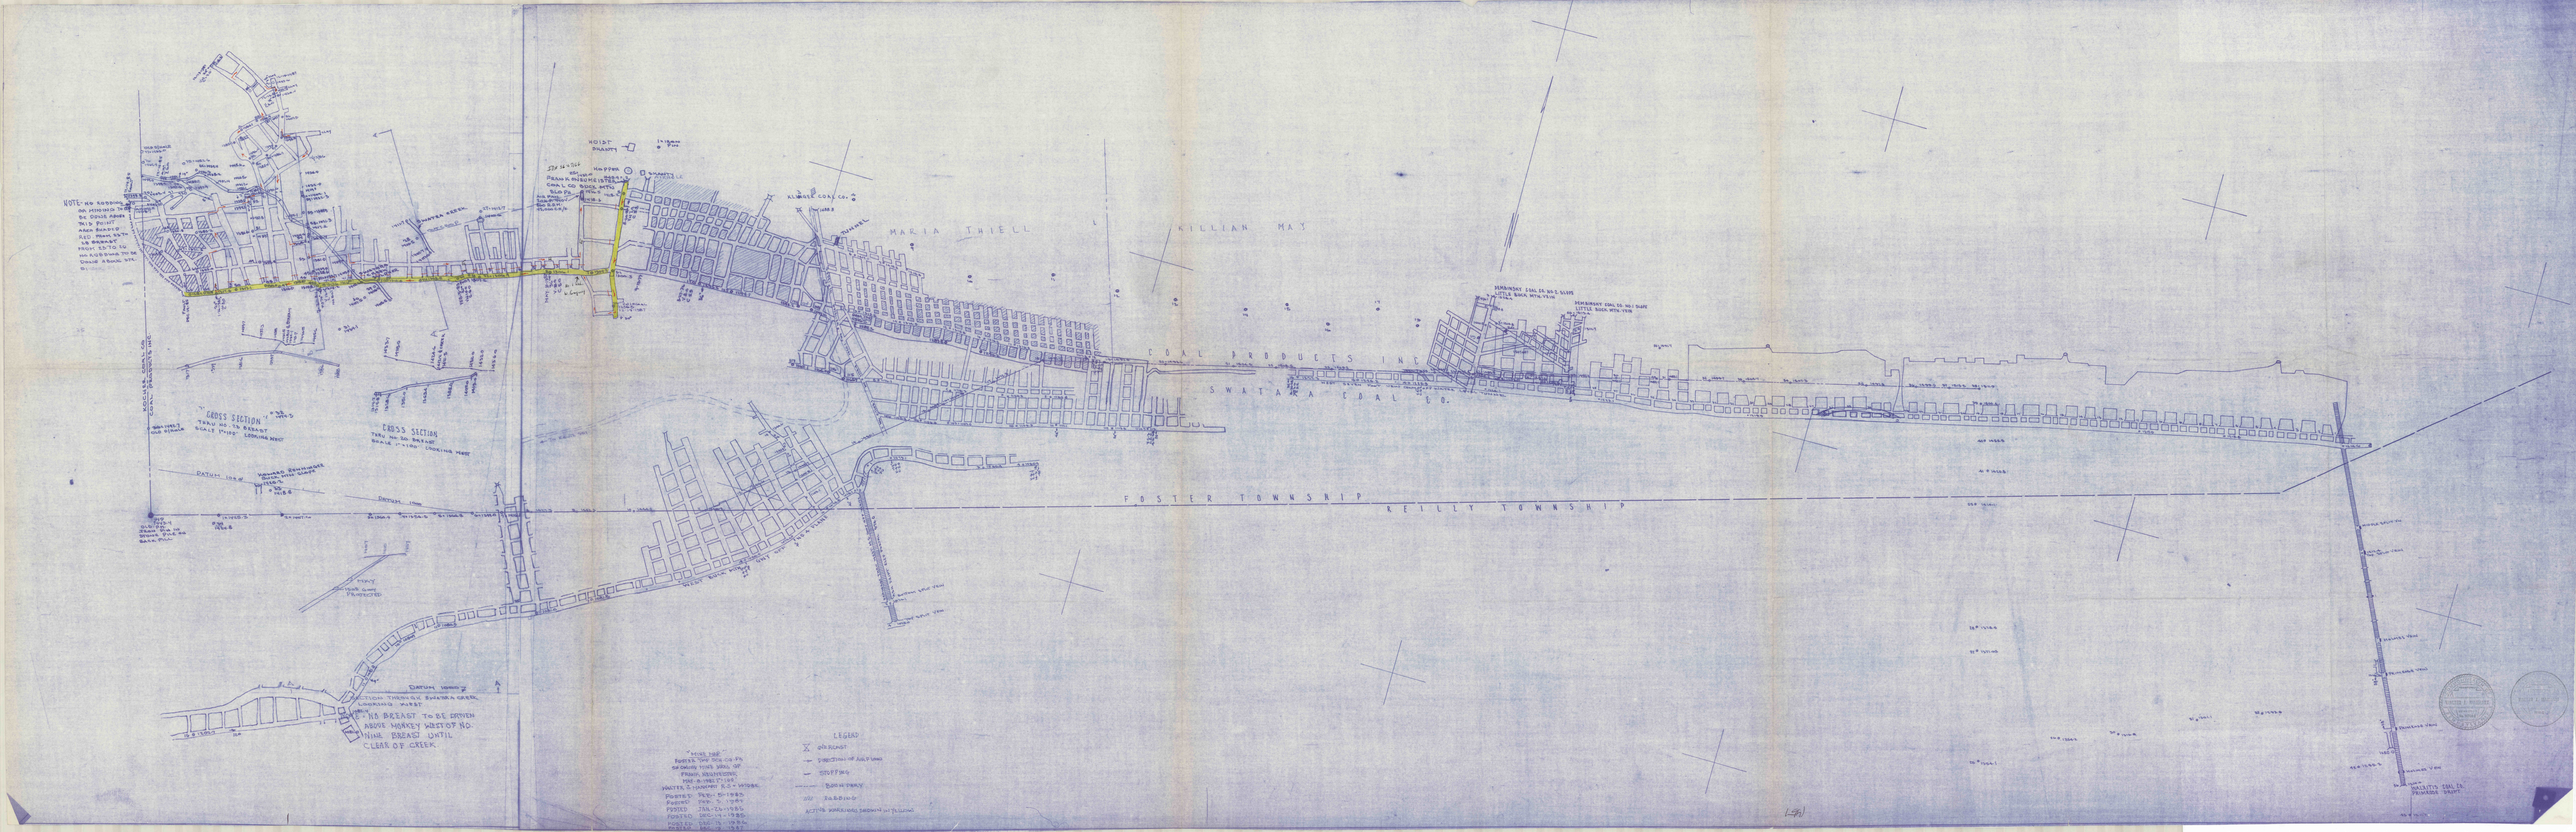

MARIA THIELL
KILLIAN MAY
COAL PRODUCTS INC.
SWATARA COAL CO.
FOSTER TOWNSHIP
REILLY TOWNSHIP
CROSS SECTION
THRU NO. 19 BREAST
LOOKING WEST
CROSS SECTION
THRU NO. 20 BREAST
LOOKING WEST
DATUM 1000
DATUM 1000
DATUM 1000
NOTE- NO ROBBING OR MINING TO BE DONE IN POINT AND BREAST NO. 19 BREAST FROM 10 TO 16 IN ROBBING TO BE DONE ABOVE 1st COAL
LEGEND
OR RIBS
DIRECTION OF AIR FLOW
STOPPING
BOREHOLE
ACTUAL WORKINGS SHOWN IN YELLOW
HOIST
SCALE 1" = 100'