


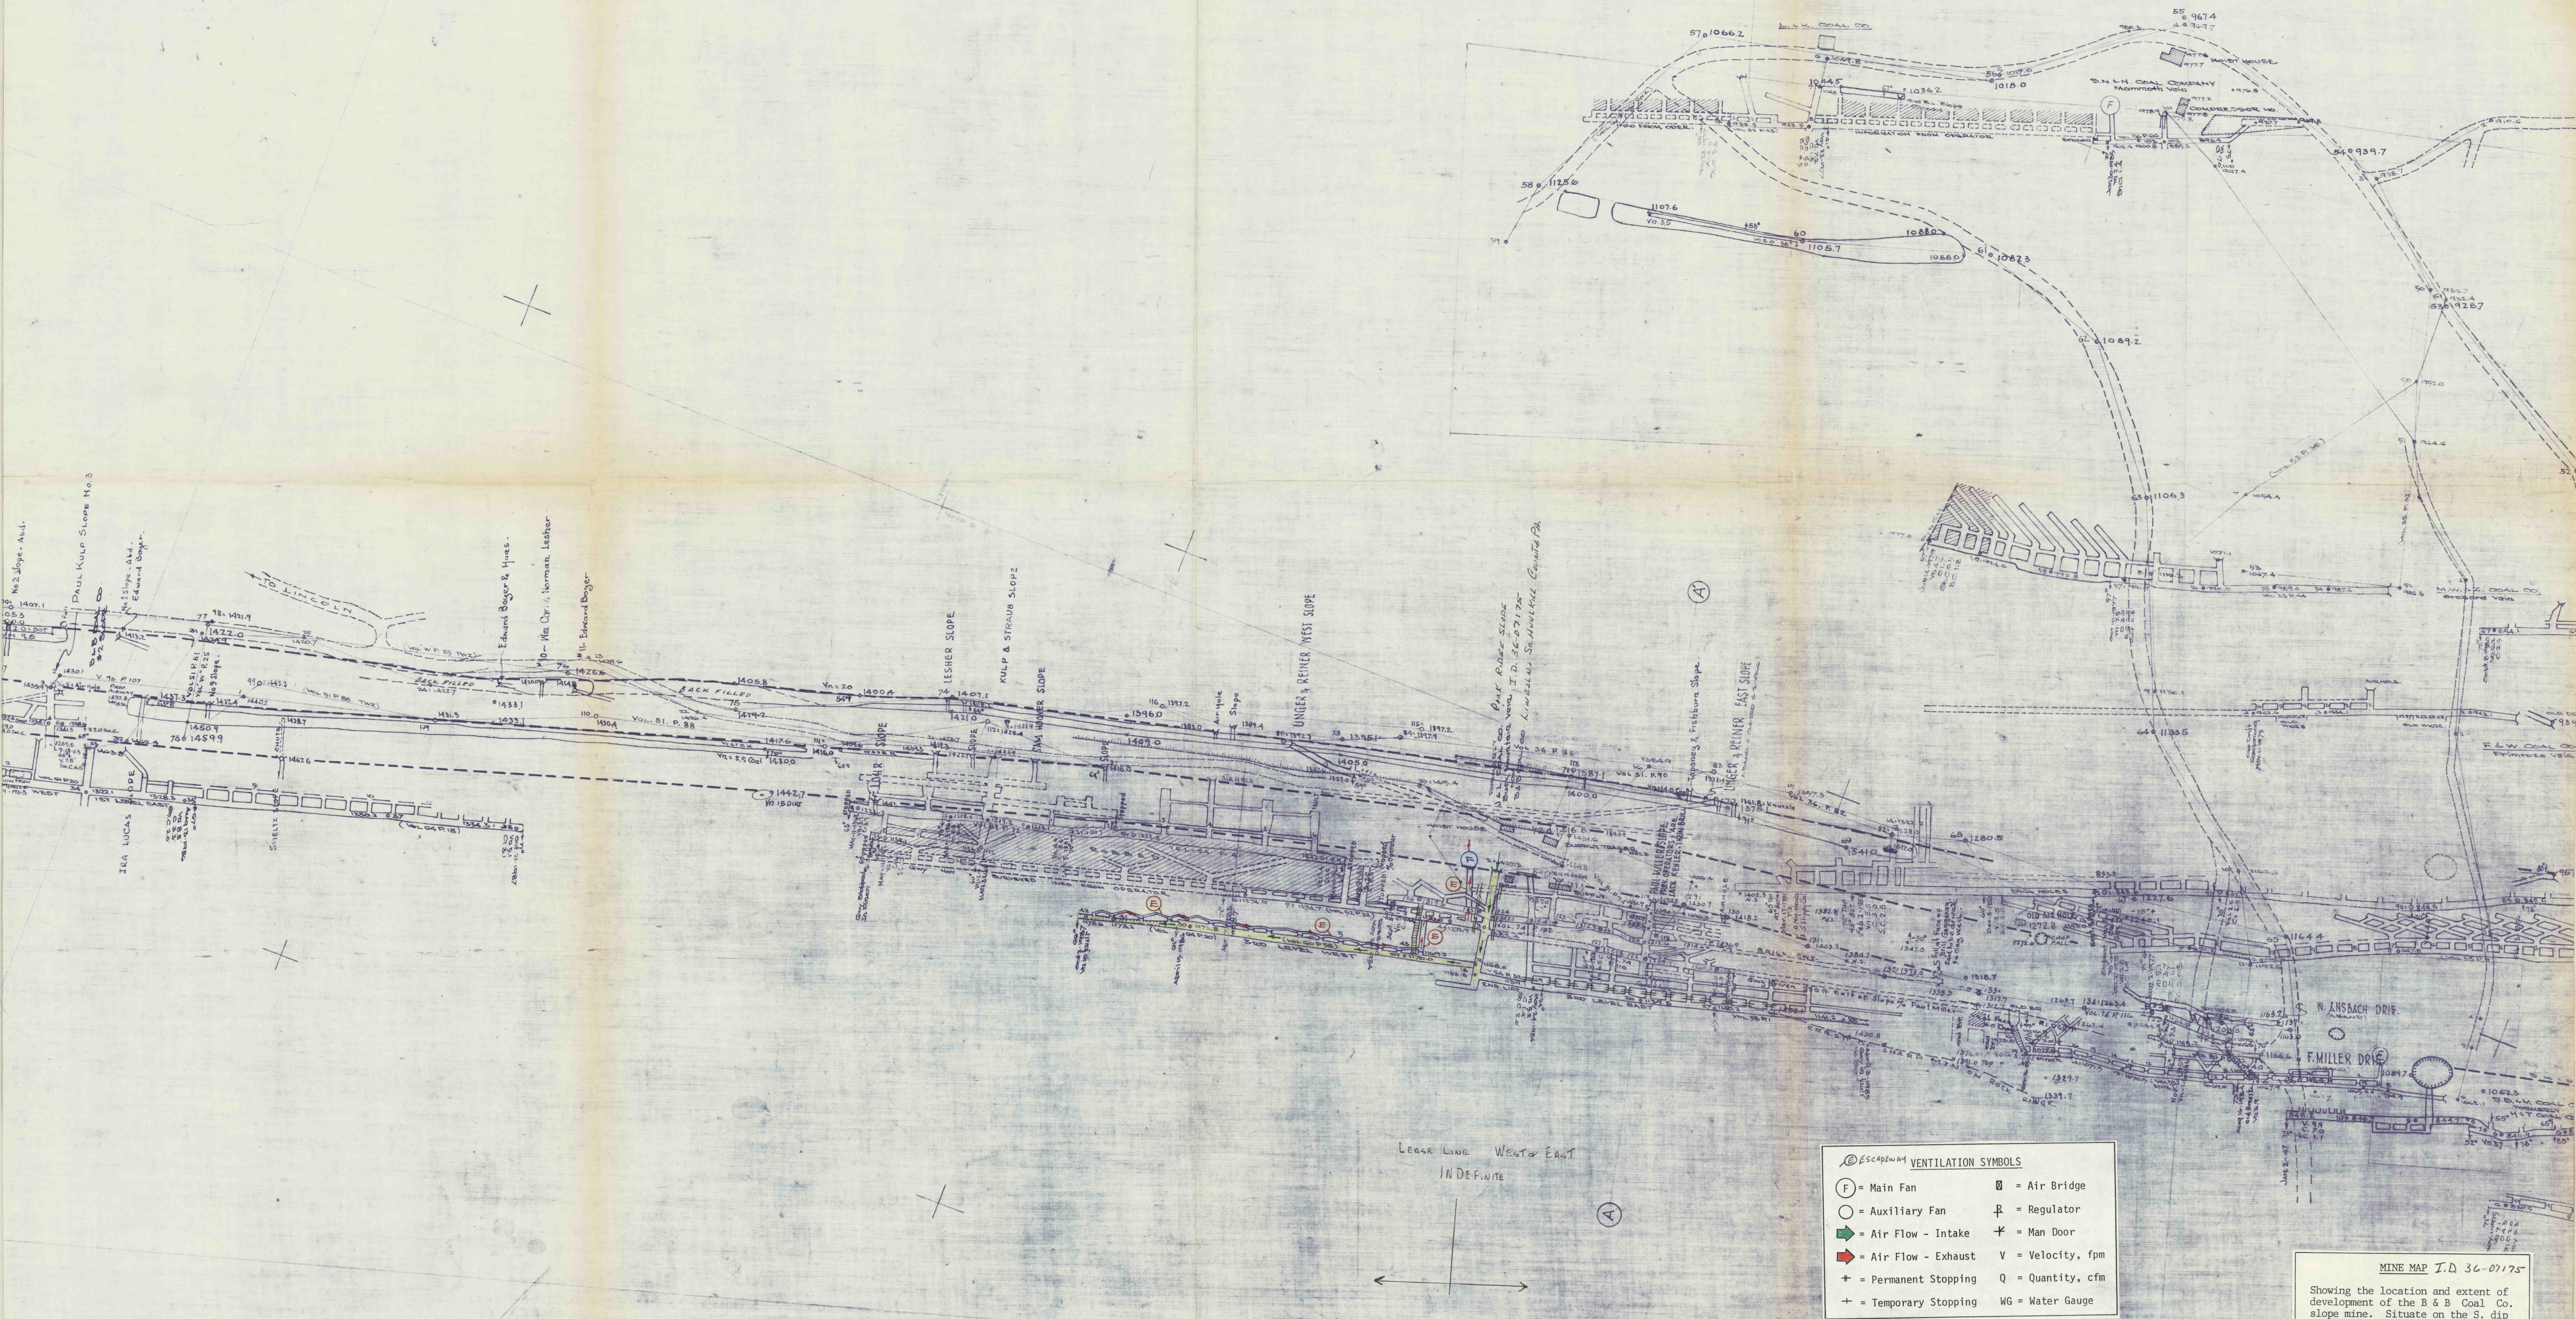

ESCAPEWAY VENTILATION SYMBOLS

(F) = Main Fan	⊠ = Air Bridge
(O) = Auxiliary Fan	⊥ = Regulator
→ = Air Flow - Intake	⊥ = Man Door
↘ = Air Flow - Exhaust	V = Velocity, fpm
⊕ = Permanent Stopping	Q = Quantity, cfm
⊕ = Temporary Stopping	WG = Water Gauge

MINE MAP I.D. 36-07175

Showing the location and extent of development of the B & B Coal Co. slope mine. Situate on the S. dip (inverted) Buck Mtn. vein, Tremont Twp., Schuylkill County, Pa.

A.B. Riedel, P.E. Oct. 21, 1987
Scale 1" = 100'