


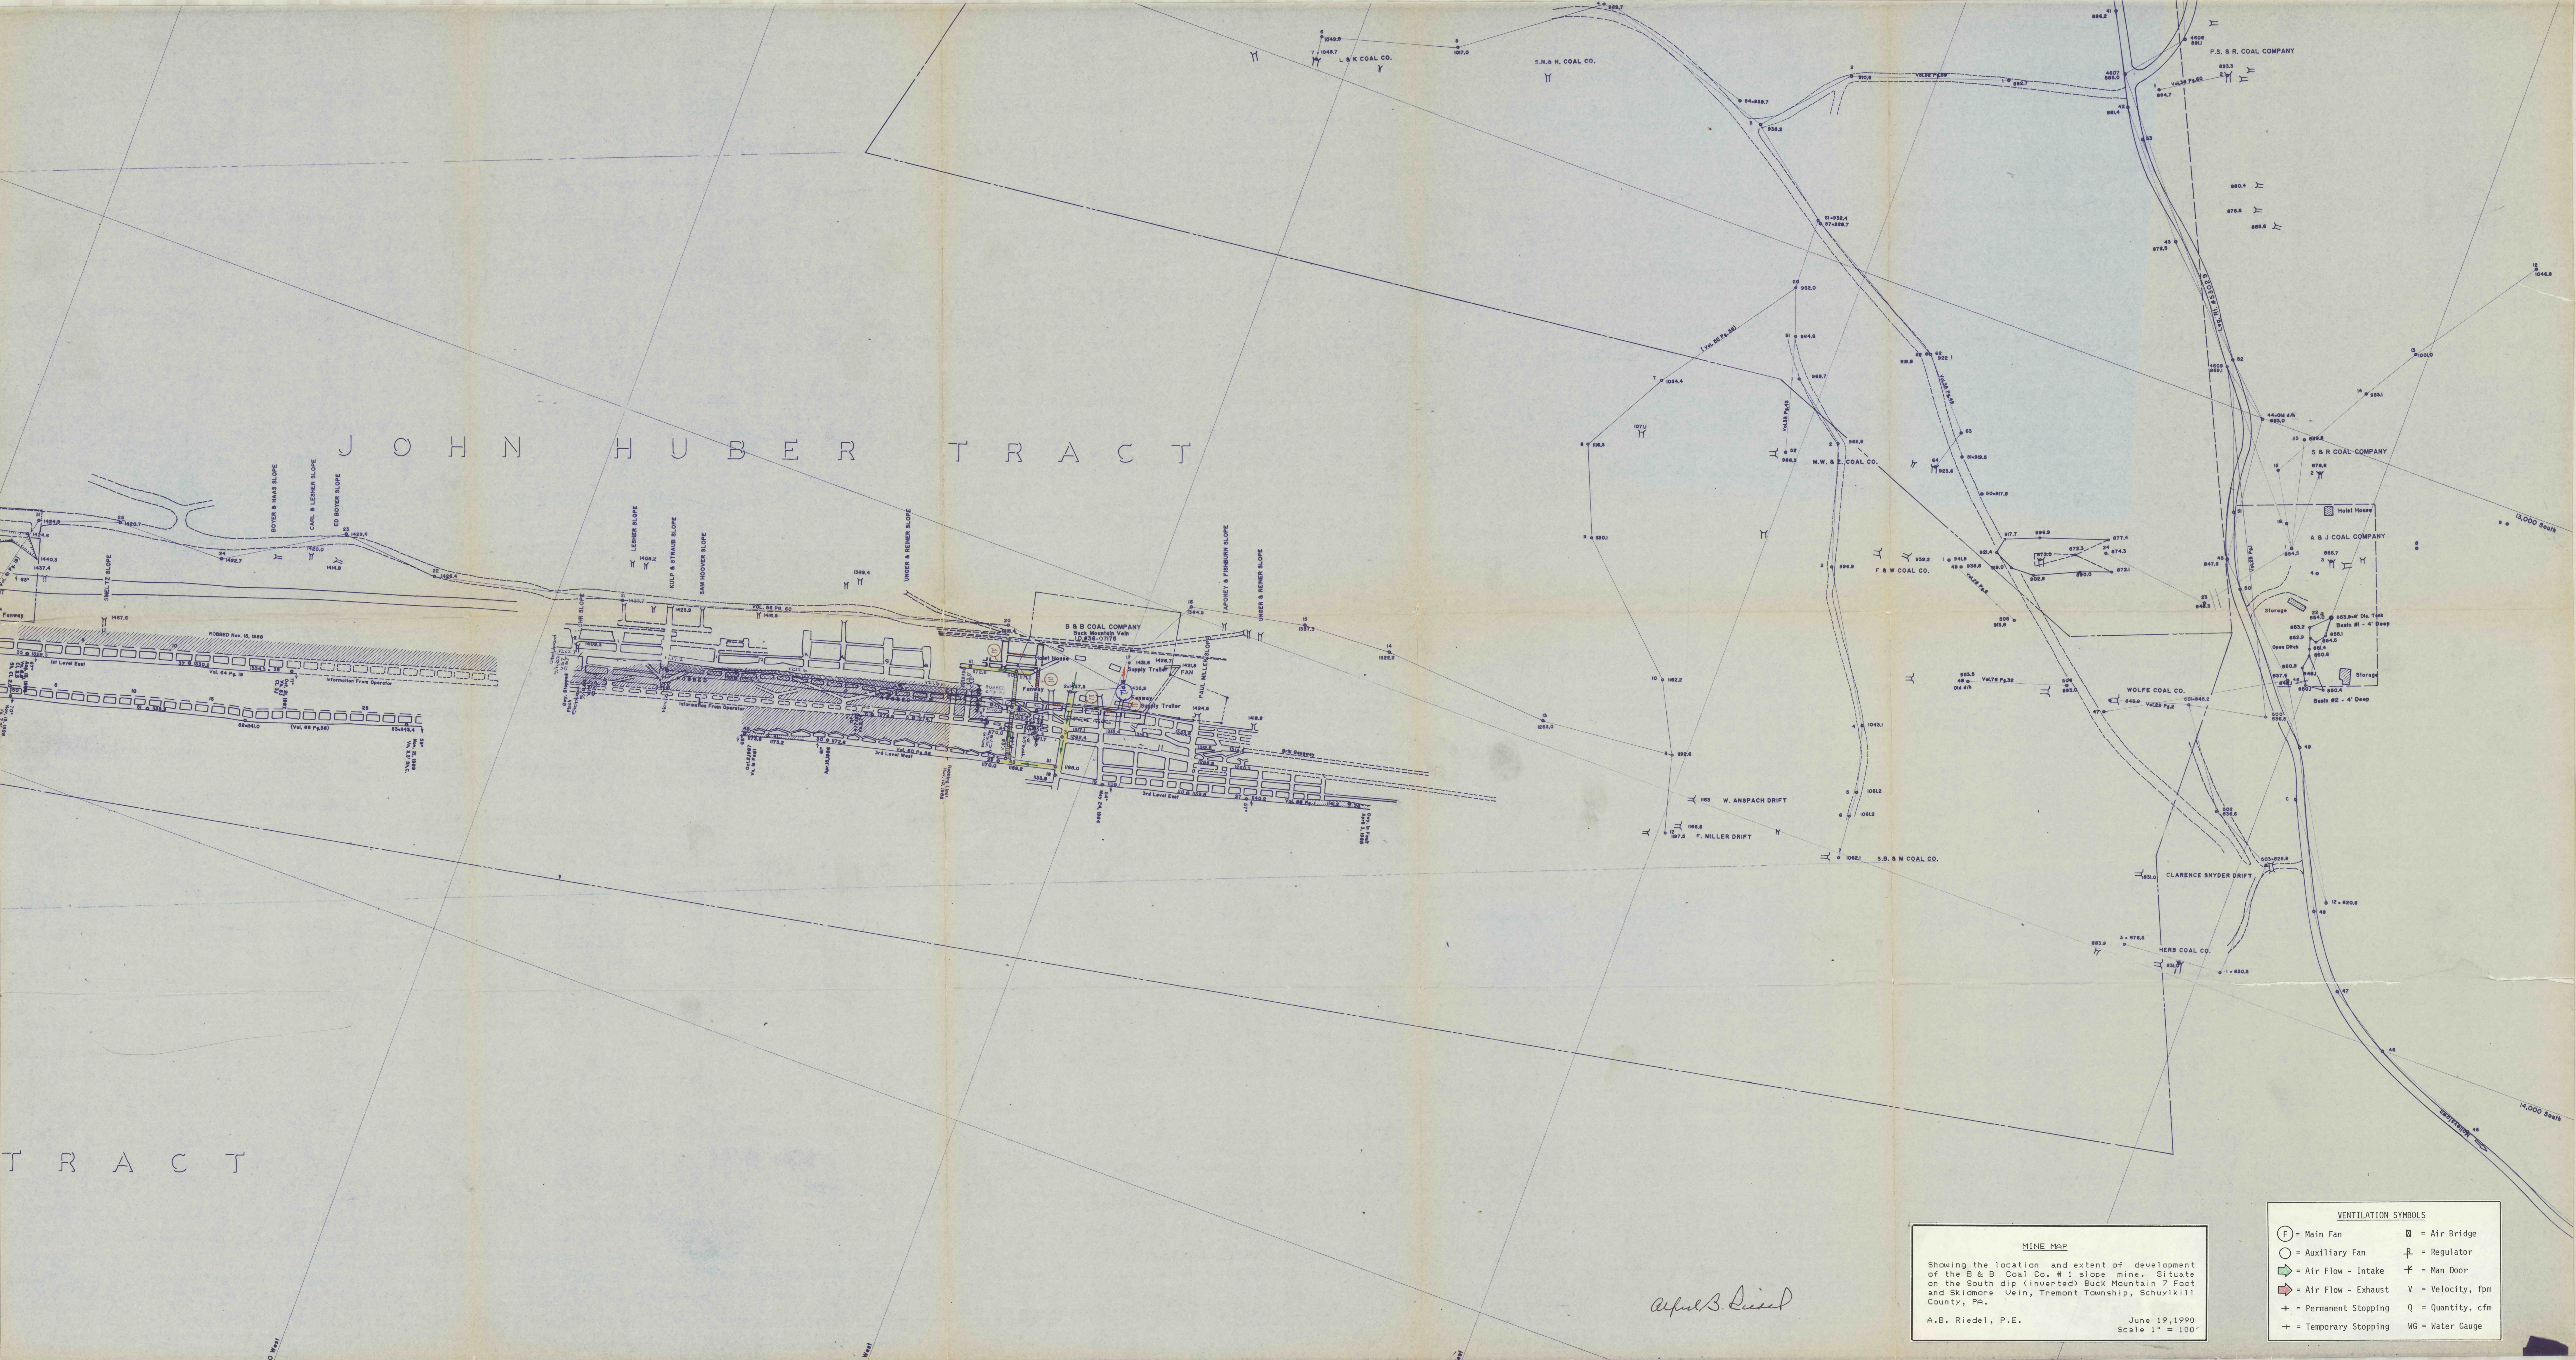

JOHN HUBER TRACT

**MINE MAP**

Showing the location and extent of development of the B & B Coal Co. #1 slope mine. Situate on the South dip (inverted) Buck Mountain 7 Foot and Skidmore Vein, Tremont Township, Schuylkill County, PA.

A.B. Riedel, P.E.

June 19, 1990  
Scale 1" = 100'

**VENTILATION SYMBOLS**

|                          |                   |
|--------------------------|-------------------|
| (F) = Main Fan           | (A) = Air Bridge  |
| (O) = Auxiliary Fan      | (R) = Regulator   |
| (I) = Air Flow - Intake  | (M) = Man Door    |
| (E) = Air Flow - Exhaust | V = Velocity, fpm |
| + = Permanent Stopping   | Q = Quantity, cfm |
| + = Temporary Stopping   | WG = Water Gauge  |