



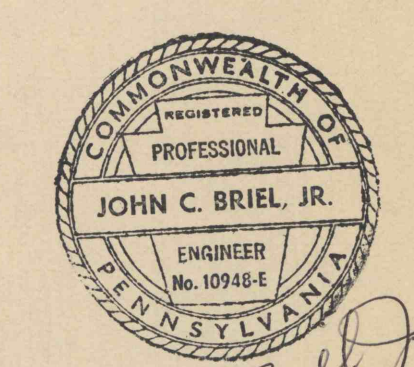

John C. Briel, Jr.
Robert A. Lehr

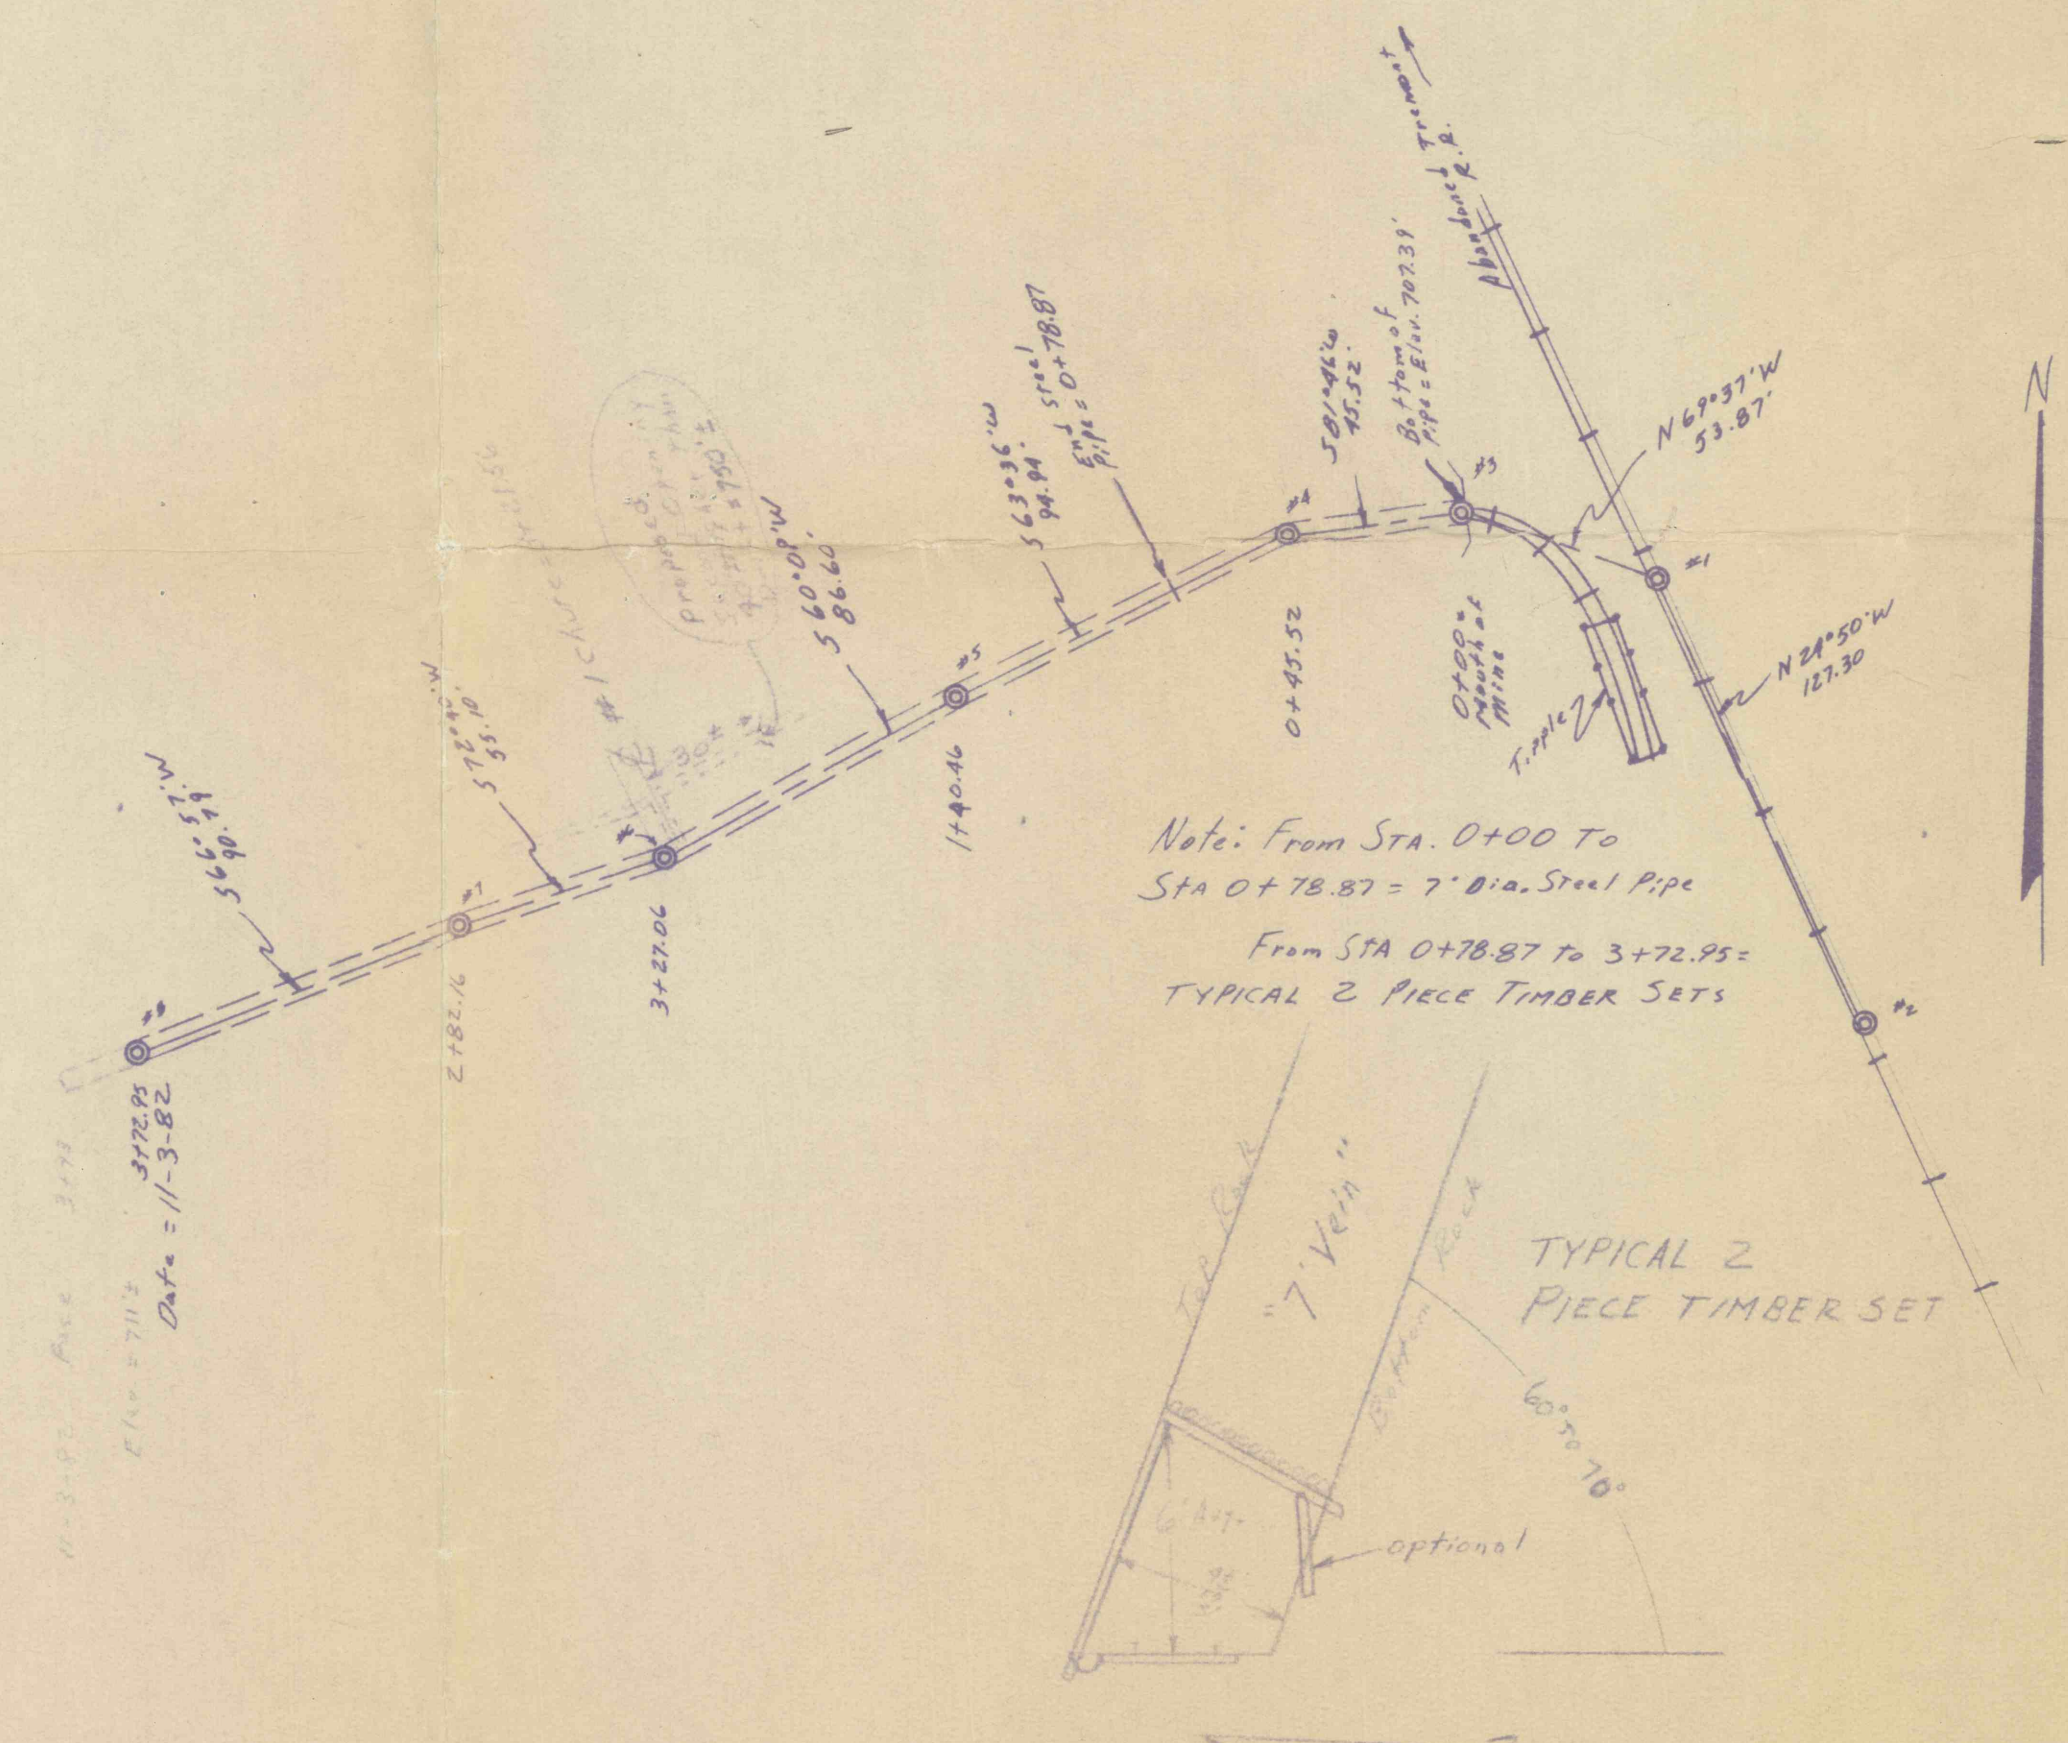

SURVEY OF POTTS CONTRACTING DRIFT MINE: "7' VEIN"
 Tremont Twp. - Schuylkill Co. - Penna.
 Scale: 1" = 50' Date: 11-3-1982
 Surveyed by: Robert A. Lehr R.S. Revision Dates
 Dwg # M-50-44
 No 7 foot Vein DRIFT mine
 Potts Co CONTRACTING CO INC
 36-07269