


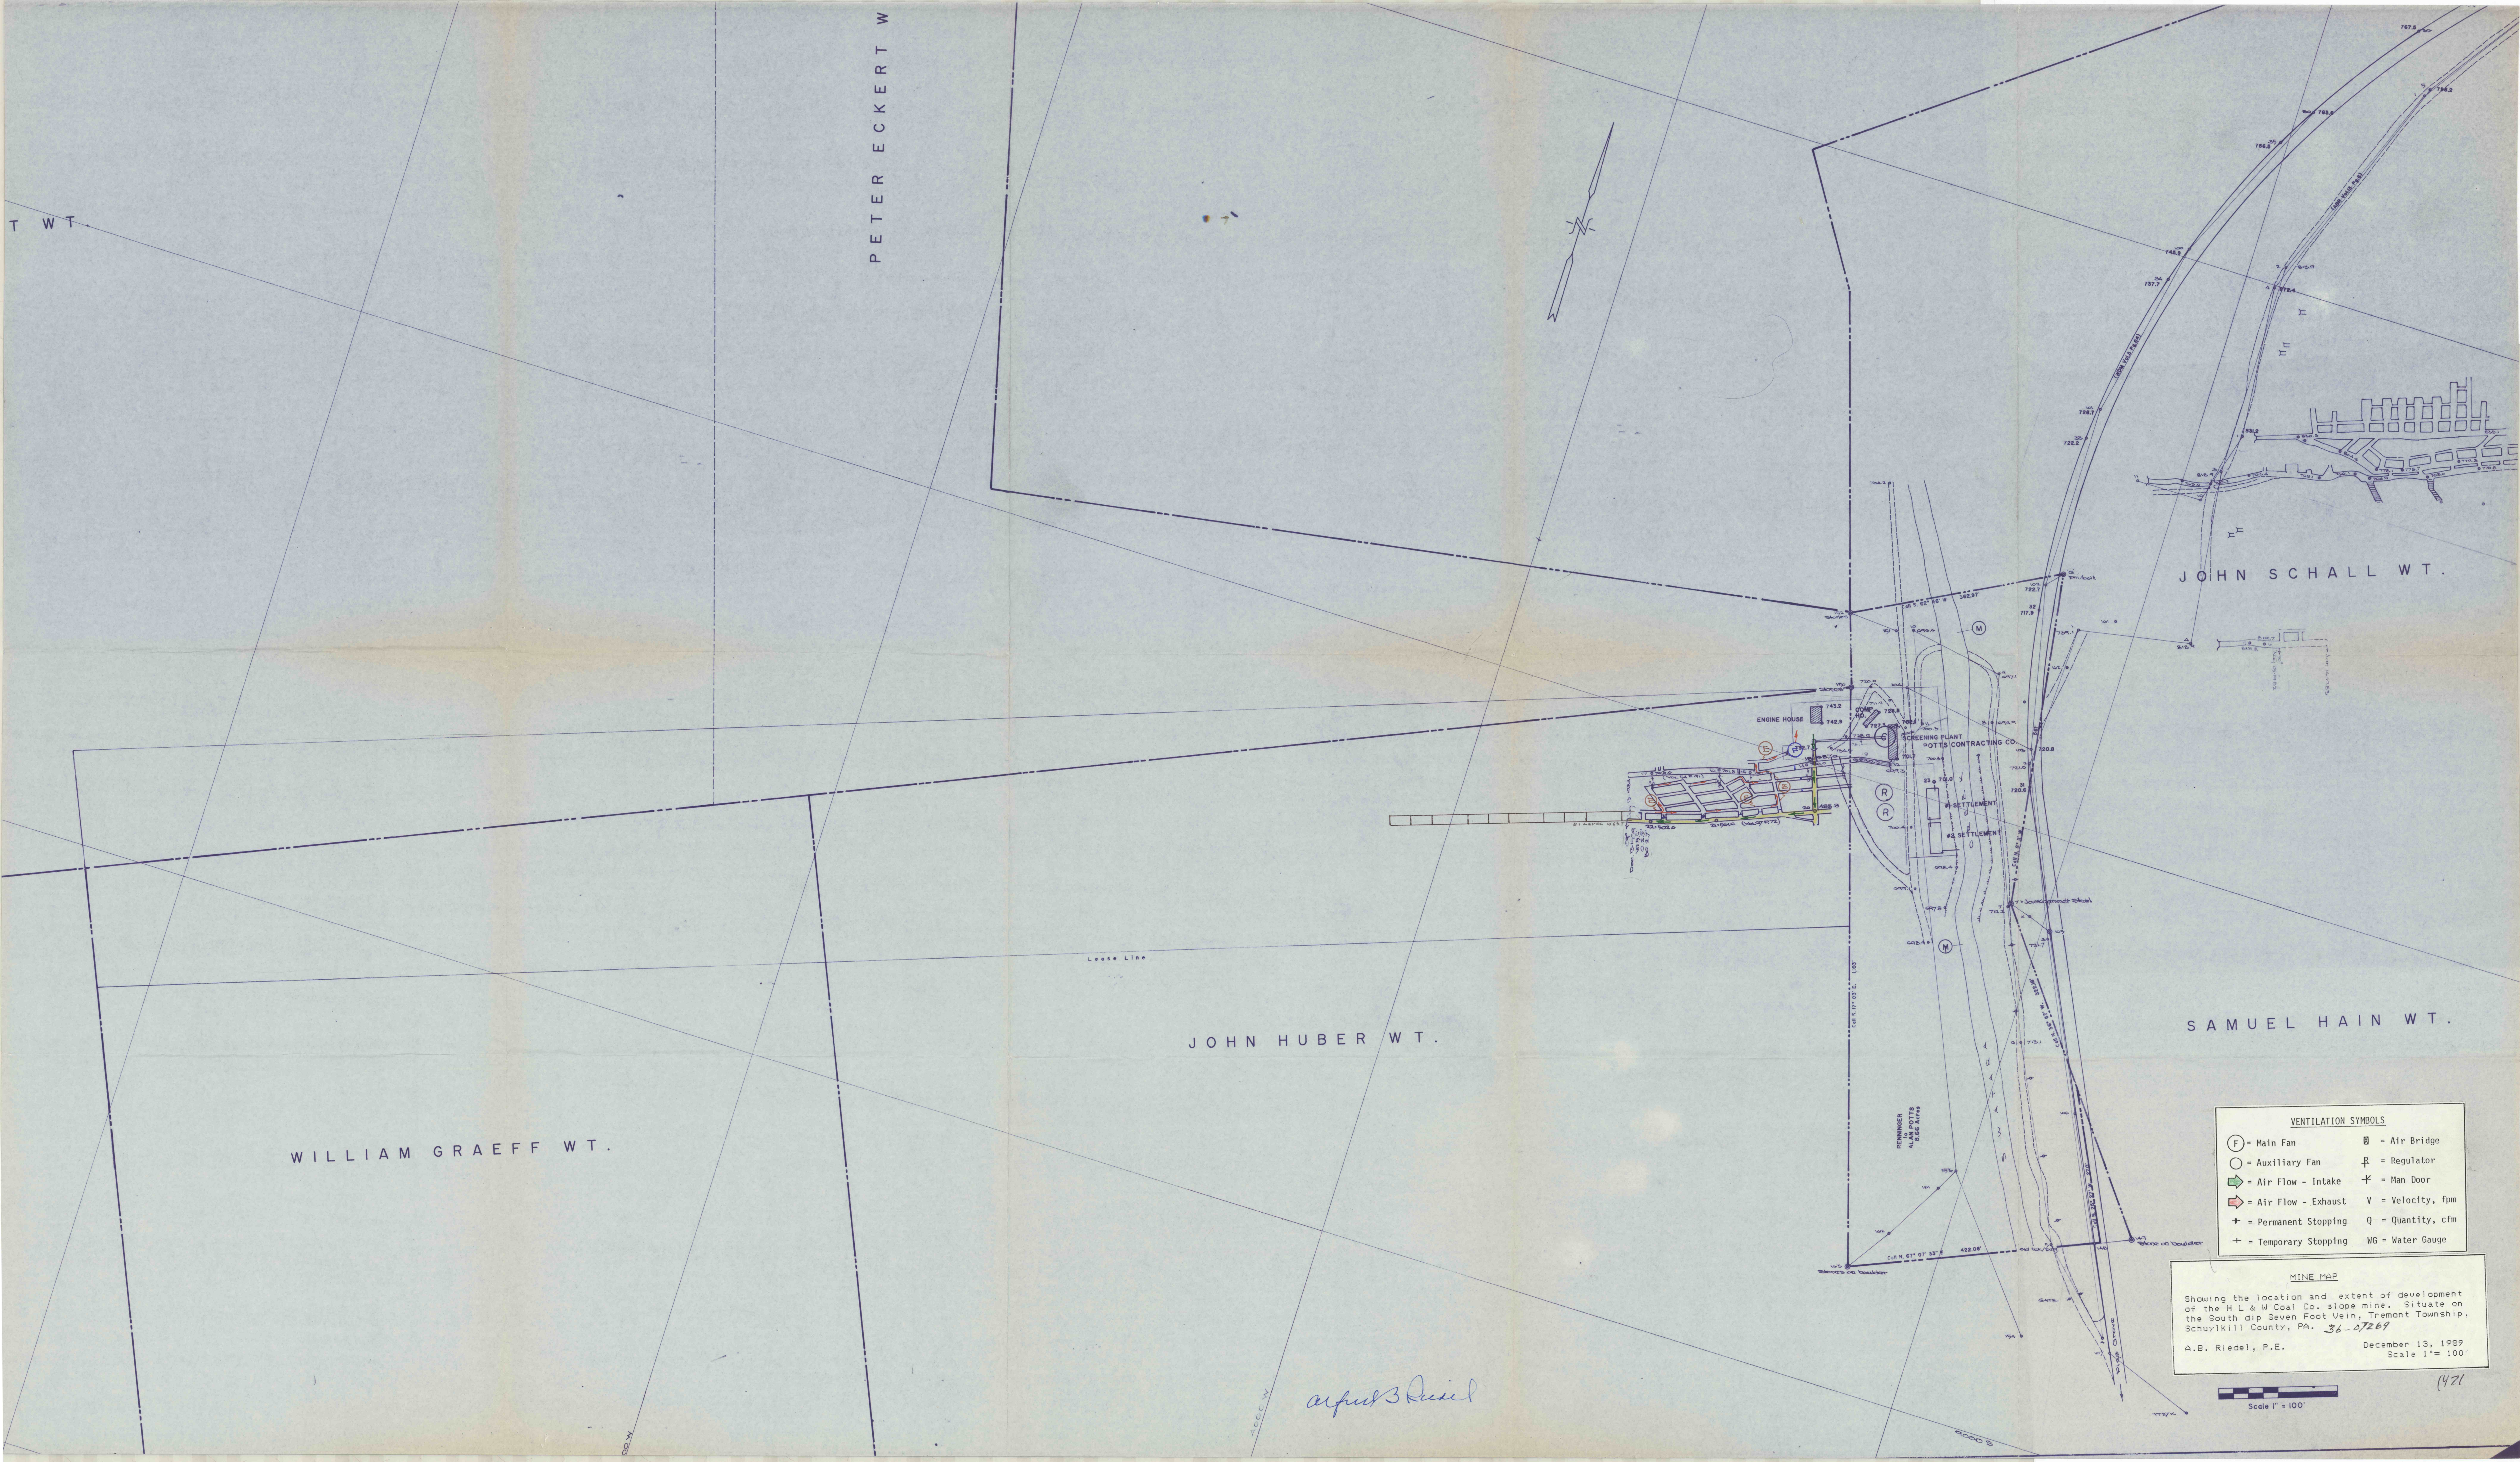

WILLIAM GRAEFF WT.

PETER ECKERT W


JOHN HUBER WT.

JOHN SCHALL WT.

SAMUEL HAIN WT.

VENTILATION SYMBOLS	
(F) = Main Fan	⌘ = Air Bridge
(O) = Auxiliary Fan	⌘ = Regulator
→ = Air Flow - Intake	⌘ = Man Door
→ = Air Flow - Exhaust	V = Velocity, fpm
+ = Permanent Stopping	Q = Quantity, cfm
+ = Temporary Stopping	WG = Water Gauge

MINE MAP
Showing the location and extent of development of the H. L. & W. Coal Co. slope mine. Situate on the South dip Seven Foot Vein, Tremont Township, Schuylkill County, PA. 36-07269
A.B. Riedel, P.E. December 13, 1989
Scale 1" = 100'

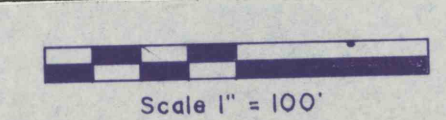

A.B. Riedel