
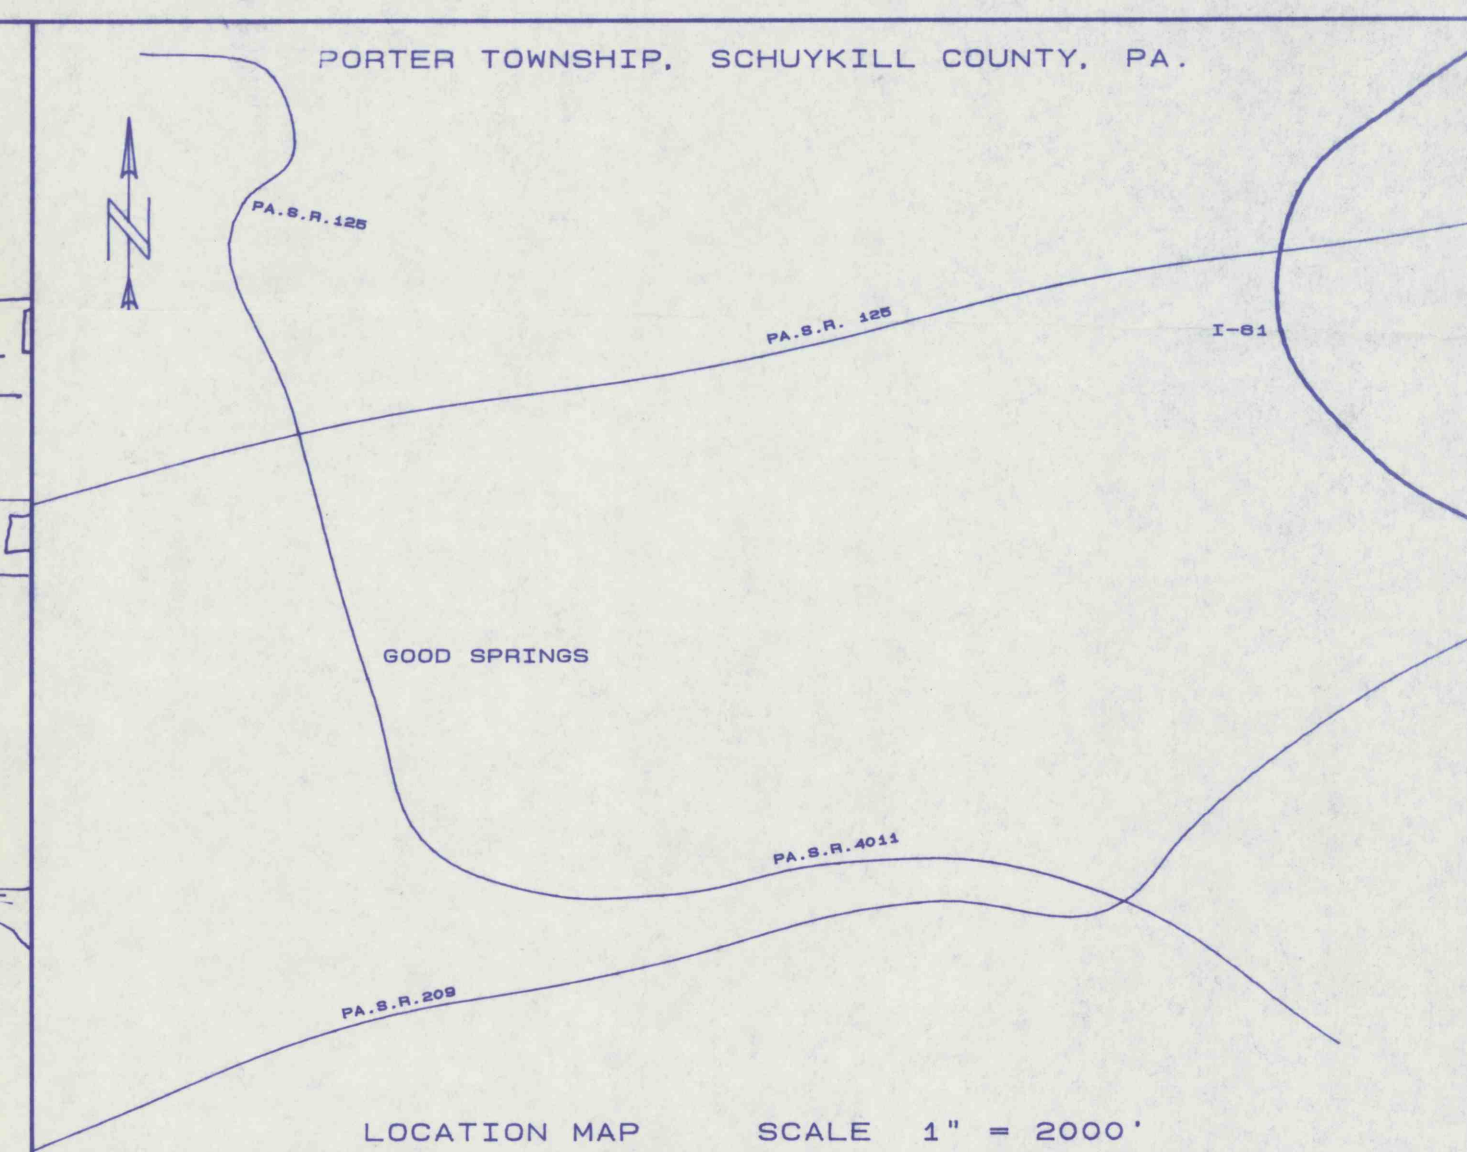


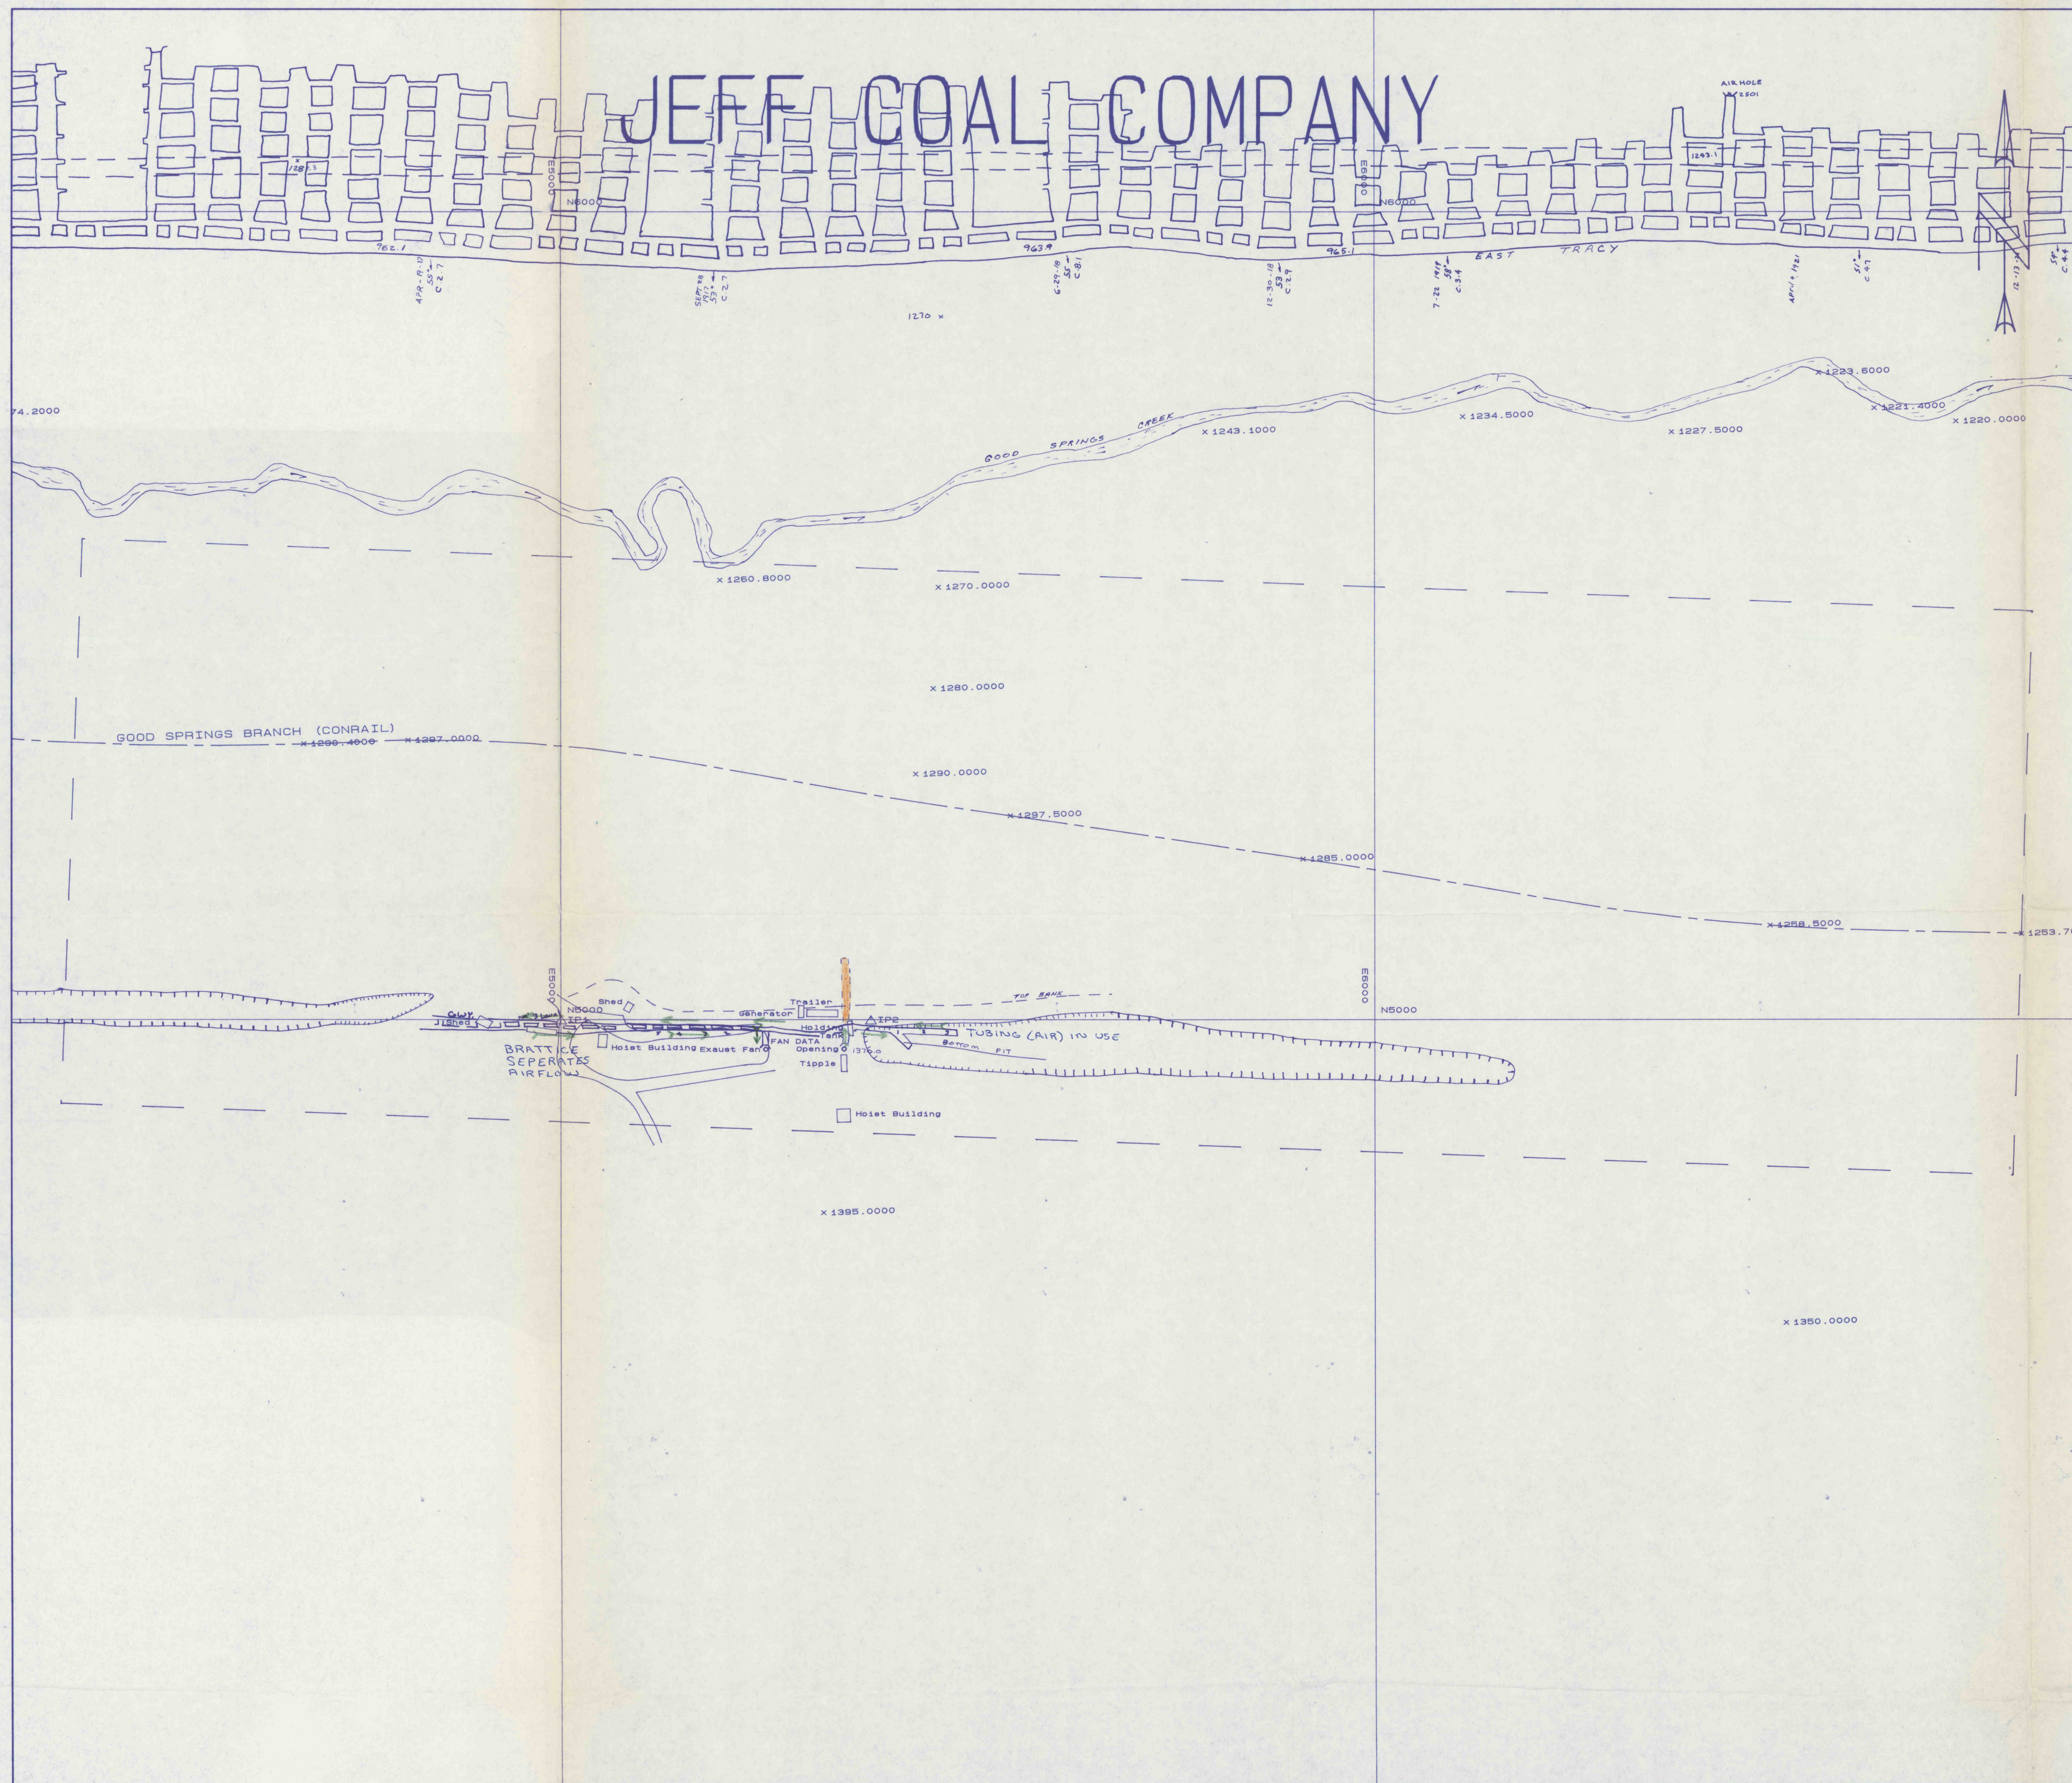


MAP LEGEND	
AIR INTAKE	→
RETURN AIR	→
ESCAPEWAY	E →
ACTIVE WORKINGS	▭
PROPOSED WORK	▭
SURFACE TRAVERSE POINT	△
PROPERTY LINE	---
LEASE LINE	---
UNDERGROUND POINT	o

IP1 - NORTH 5000.00 EAST 5000.00 ELEV. 1365.28
IP2 - NORTH 5000.00 EAST 5380.77 ELEV. 1371.35

I, the undersigned, hereby certify that this map is correct and shows all the information, to the best of my knowledge and belief, required by the mining laws of this state, and covers the period ending:

March 10, 1987
Steven E. Dziuban
Steven E. Dziuban, P.E. No. 26985-E

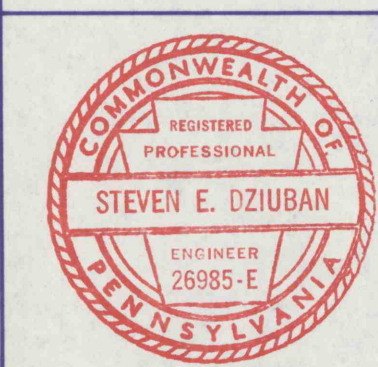

DZIUBAN, HUMENANSKY & ASSOCIATES
ENGINEERS & SURVEYORS
ROUTE 61 ORWIGSBURG, PA.
717 - 366 - 1654
MAP OF LANDS
SITUATED IN
PORTER TOWNSHIP, SCHUYKILL COUNTY, PA.
JEFF COAL COMPANY
R.D. NO. 1 BOX 104
WILLIAMSTOWN, PA. 17098

ISSUE DATE:	DATE: 02/14/89	ORDER NO. JN00128
SCALE: 1" = 100'	CHKD. BY: SED SCB	DWG. NO. 00128-1
DWG BY: MTP		
SHEET 1 OF 1		