
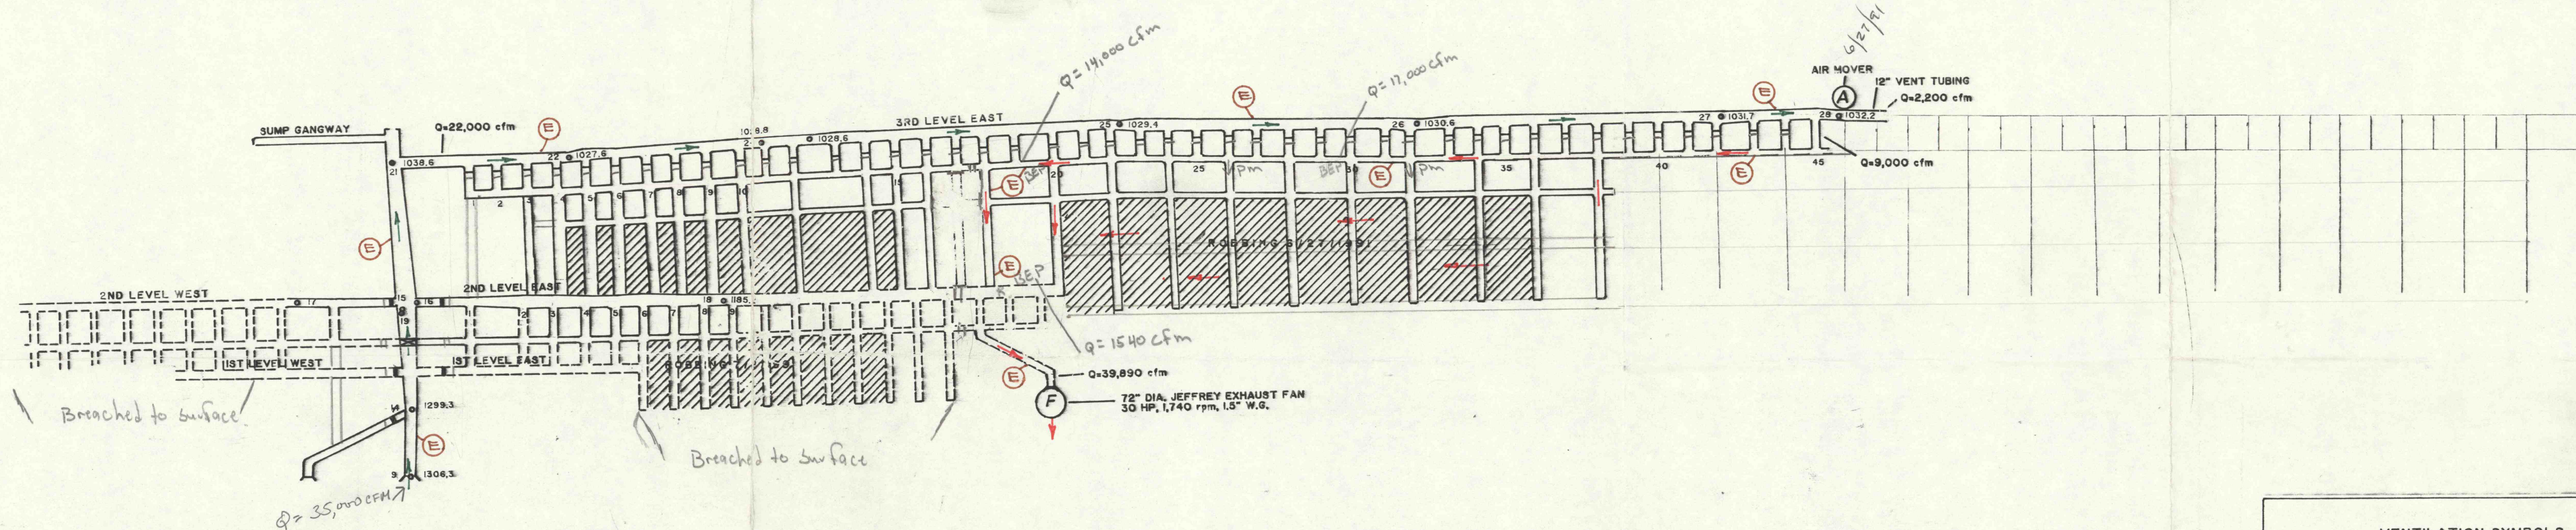


24,000' West

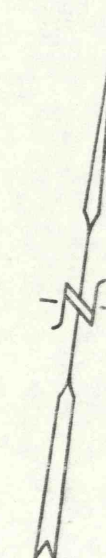

LONGITUDINAL SECTION
thru
Mine Workings
of the
Jeff Coal Company - 36-07328
Tracy Vein Slope

Scale 1 Inch = 100 feet

VENTILATION SYMBOLS	
(F)	= Main Fan
(A)	= Auxiliary Fan
→	= Air Flow - Intake
←	= Air Flow - Exhaust
— —	= Permanent Stopping
— — —	= Temporary Stopping
⊠	= Air Bridge
R	= Regulator
∇	= Man Door
V	= Velocity, fpm
Q	= Quantity, cfm
WG	= Water Gauge
(E)	= Escapeway
BEP	= Bleeder Evaluation Point
pm	= Perceptible movement