


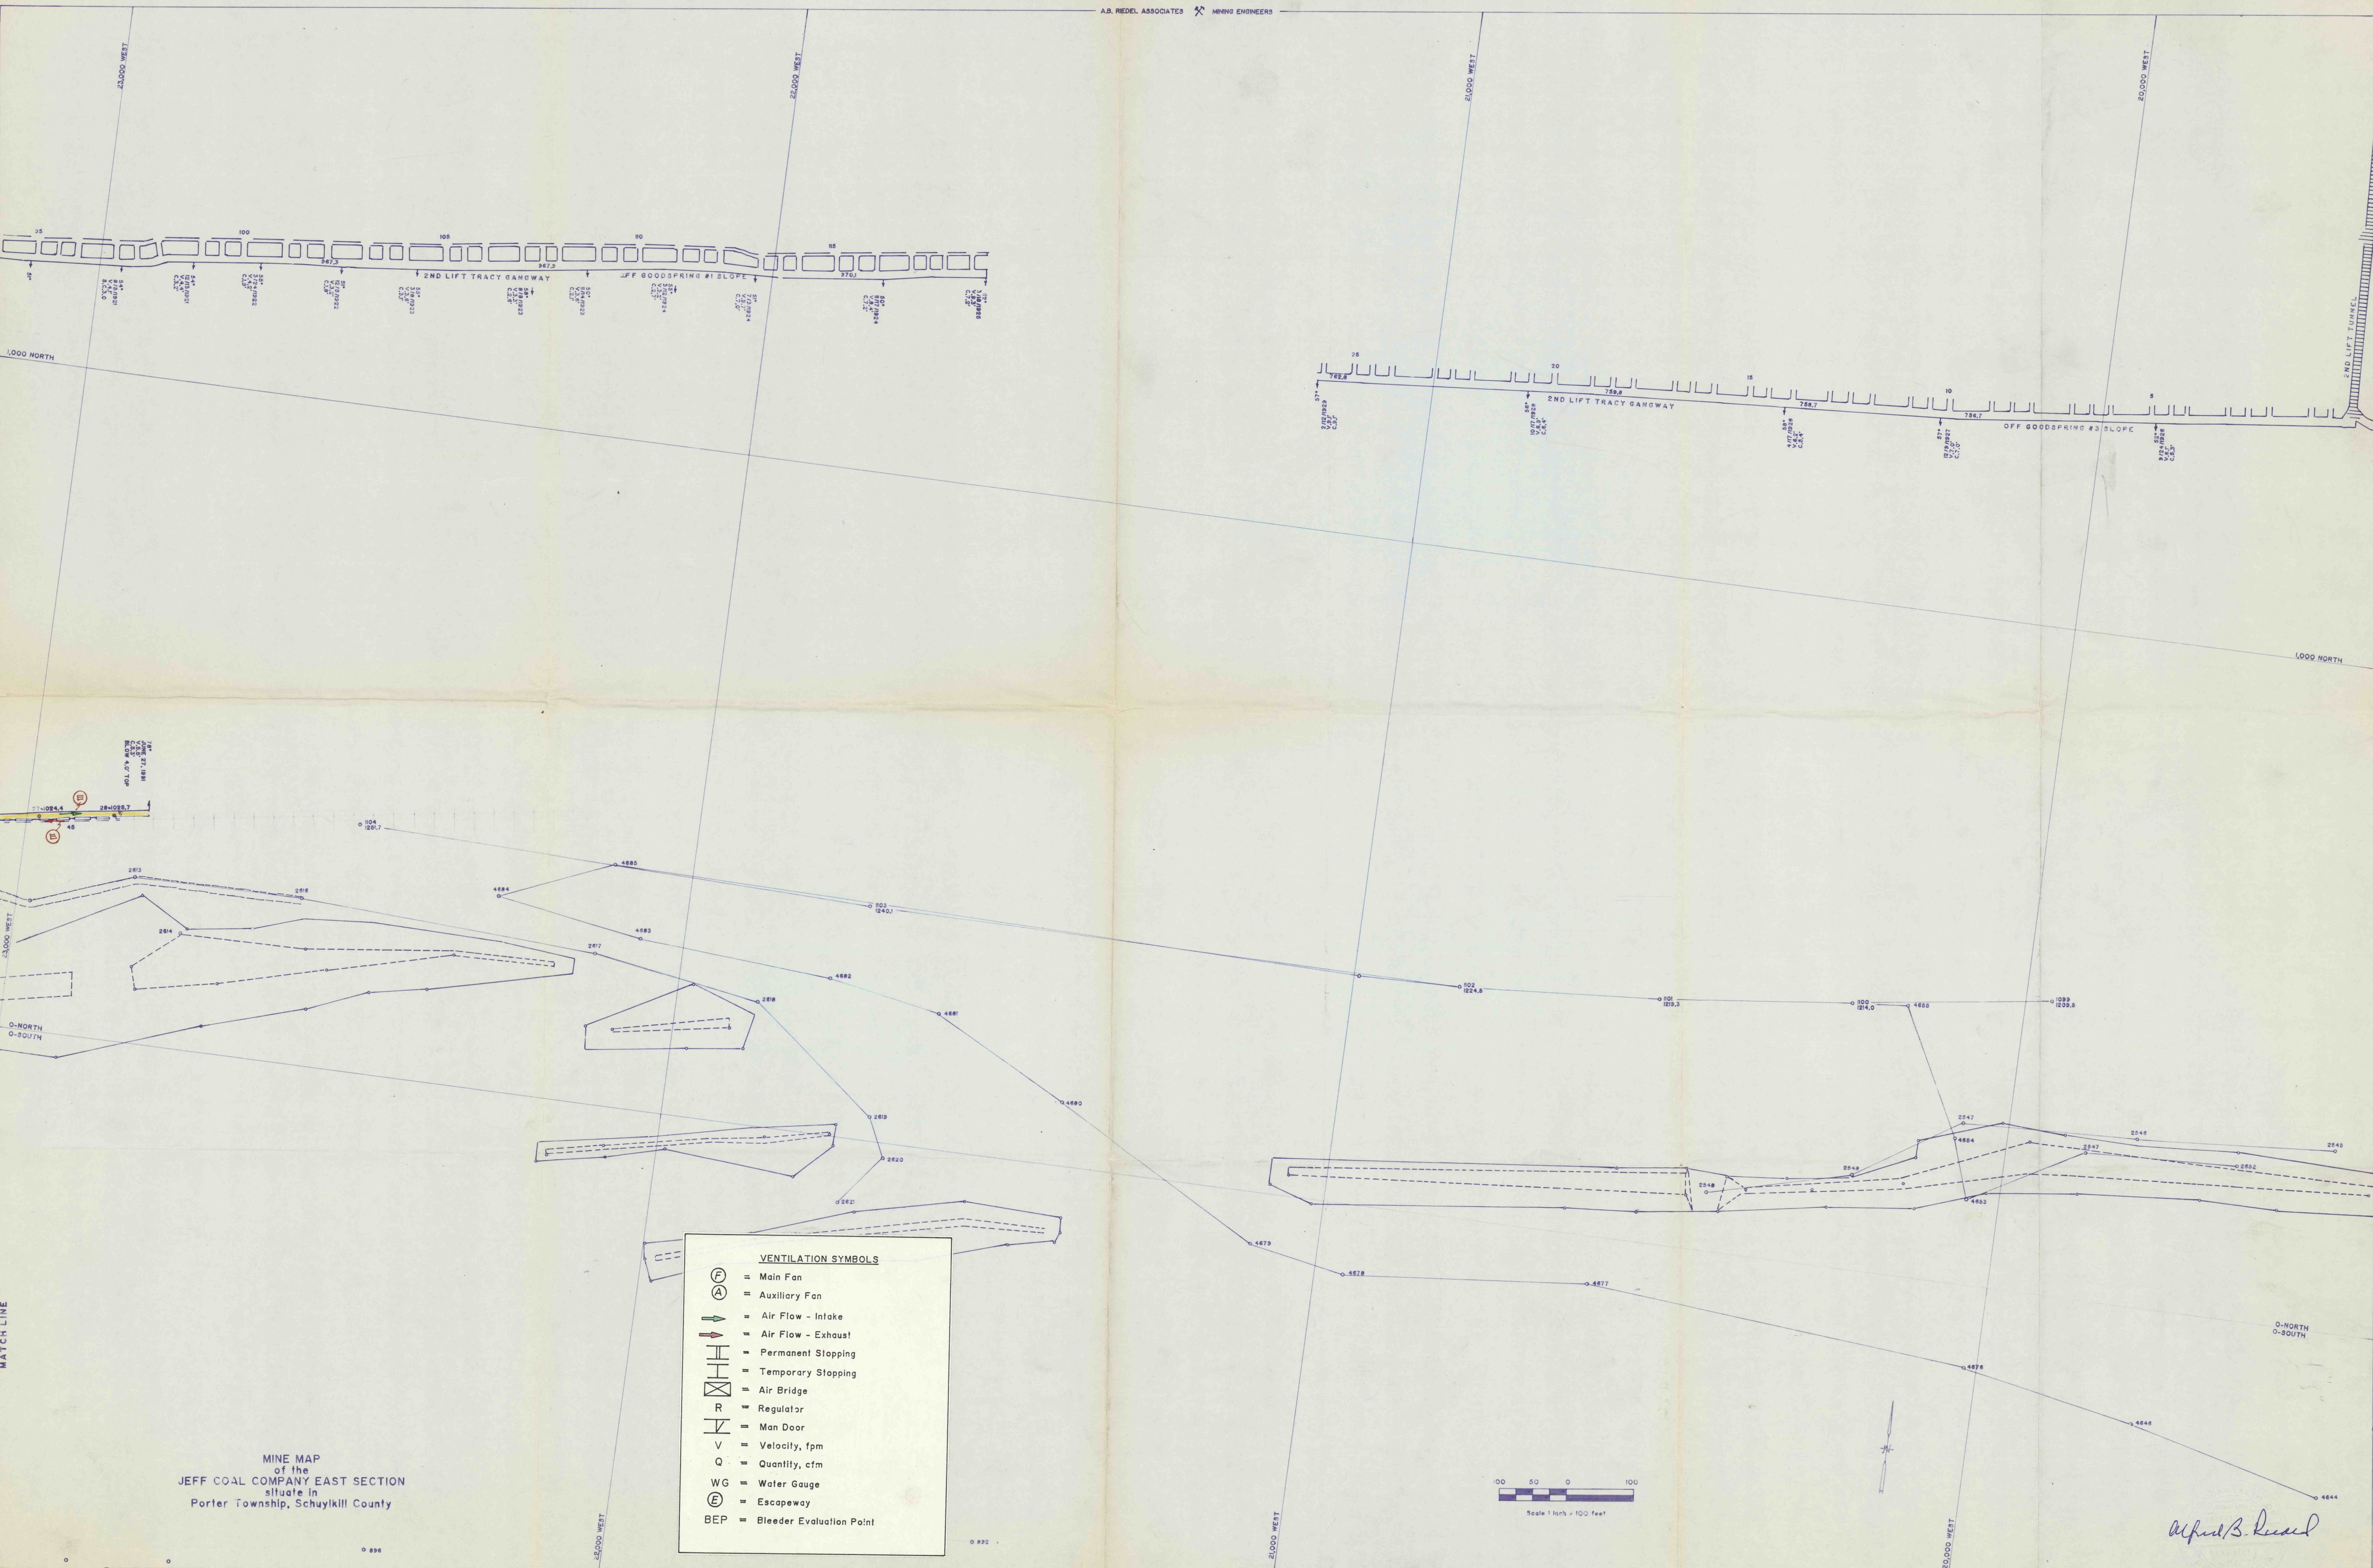

MINE MAP
of the
JEFF COAL COMPANY EAST SECTION
situate in
Porter Township, Schuylkill County

- VENTILATION SYMBOLS**
- (F) = Main Fan
 - (A) = Auxiliary Fan
 - = Air Flow - Intake
 - ← = Air Flow - Exhaust
 - |—|—| = Permanent Stopping
 - - - - - = Temporary Stopping
 - ⊗ = Air Bridge
 - R = Regulator
 - ⌋ = Man Door
 - V = Velocity, fpm
 - Q = Quantity, cfm
 - WG = Water Gauge
 - (E) = Escapeway
 - BEP = Bleeder Evaluation Point

100 50 0 100
Scale 1 inch = 100 feet

A. B. Redel