


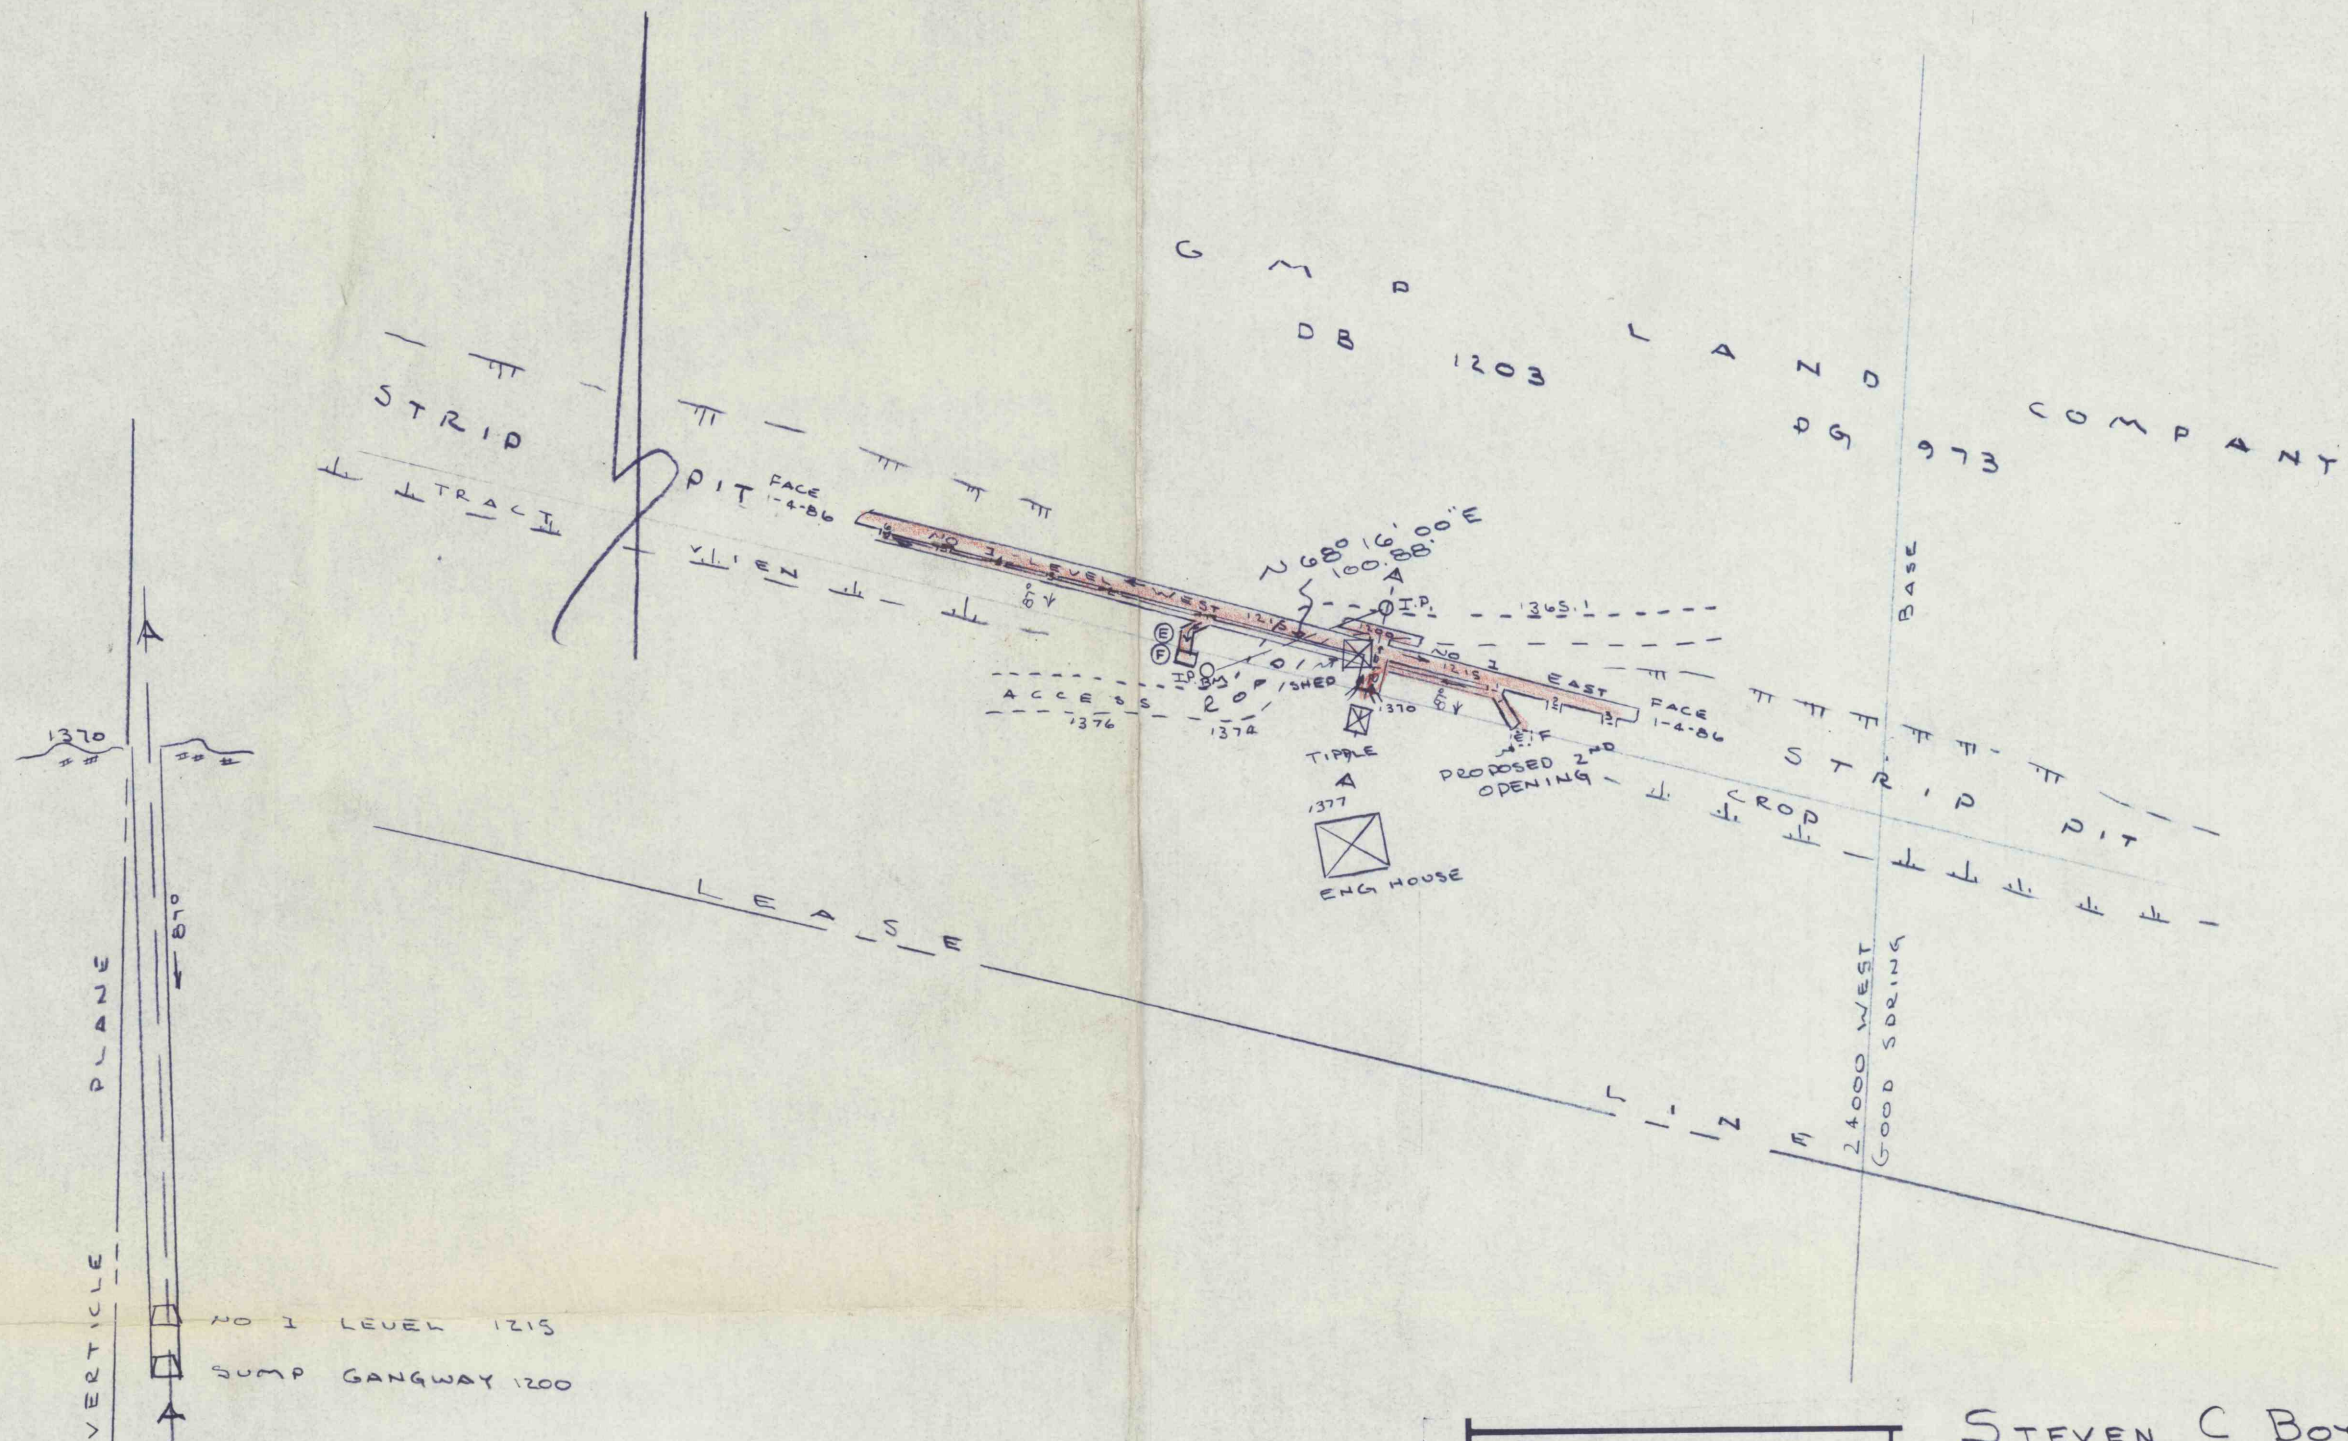

CROSS SECTION
THRU SLOPE
A-A

- LEGEND
- ⊙ ESCAPEWAY
 - ⊙ FAN
 - AIR
 - ↔ AIR RETURN
 - I TEMP STOPPING
 - II PERM STOPPING
 - TOP STRIPPING

- NOTES
- 1- BASE FROM USGS & EXISTING MAPPING
 - 2- GANGWAY & CHUTE NOTED BY OPERATORS RECORDS
 - 3- PROPOSED WORKINGS SHOWN ON DRG. 8-85 W. WORTH
 - 4- NEAREST RECORDED WORKING IN TRACY VEIN - 950' WEST OF SLOPE
 - 5- BM E - 1373.15



1481

ISSUE DATE : 1-6-86	
SCALE : 1"=100	DATE : 1-4-86
DWG. BY : SCB	CHKD. BY : GP.
PROJ. MGR :	DEPT. HD :

STEVEN C BOYER & ASSOCIATES
HEGINS PA.
682-3756

SITUATE
PORTER TOWNSHIP, SCHUYLKILL CO
PENNSYLVANIA

JEFF COAL Co.
ID 36-07328
TRACY VEIN

ORDER NO : 0192SC
DWG. NO : 0192SC