


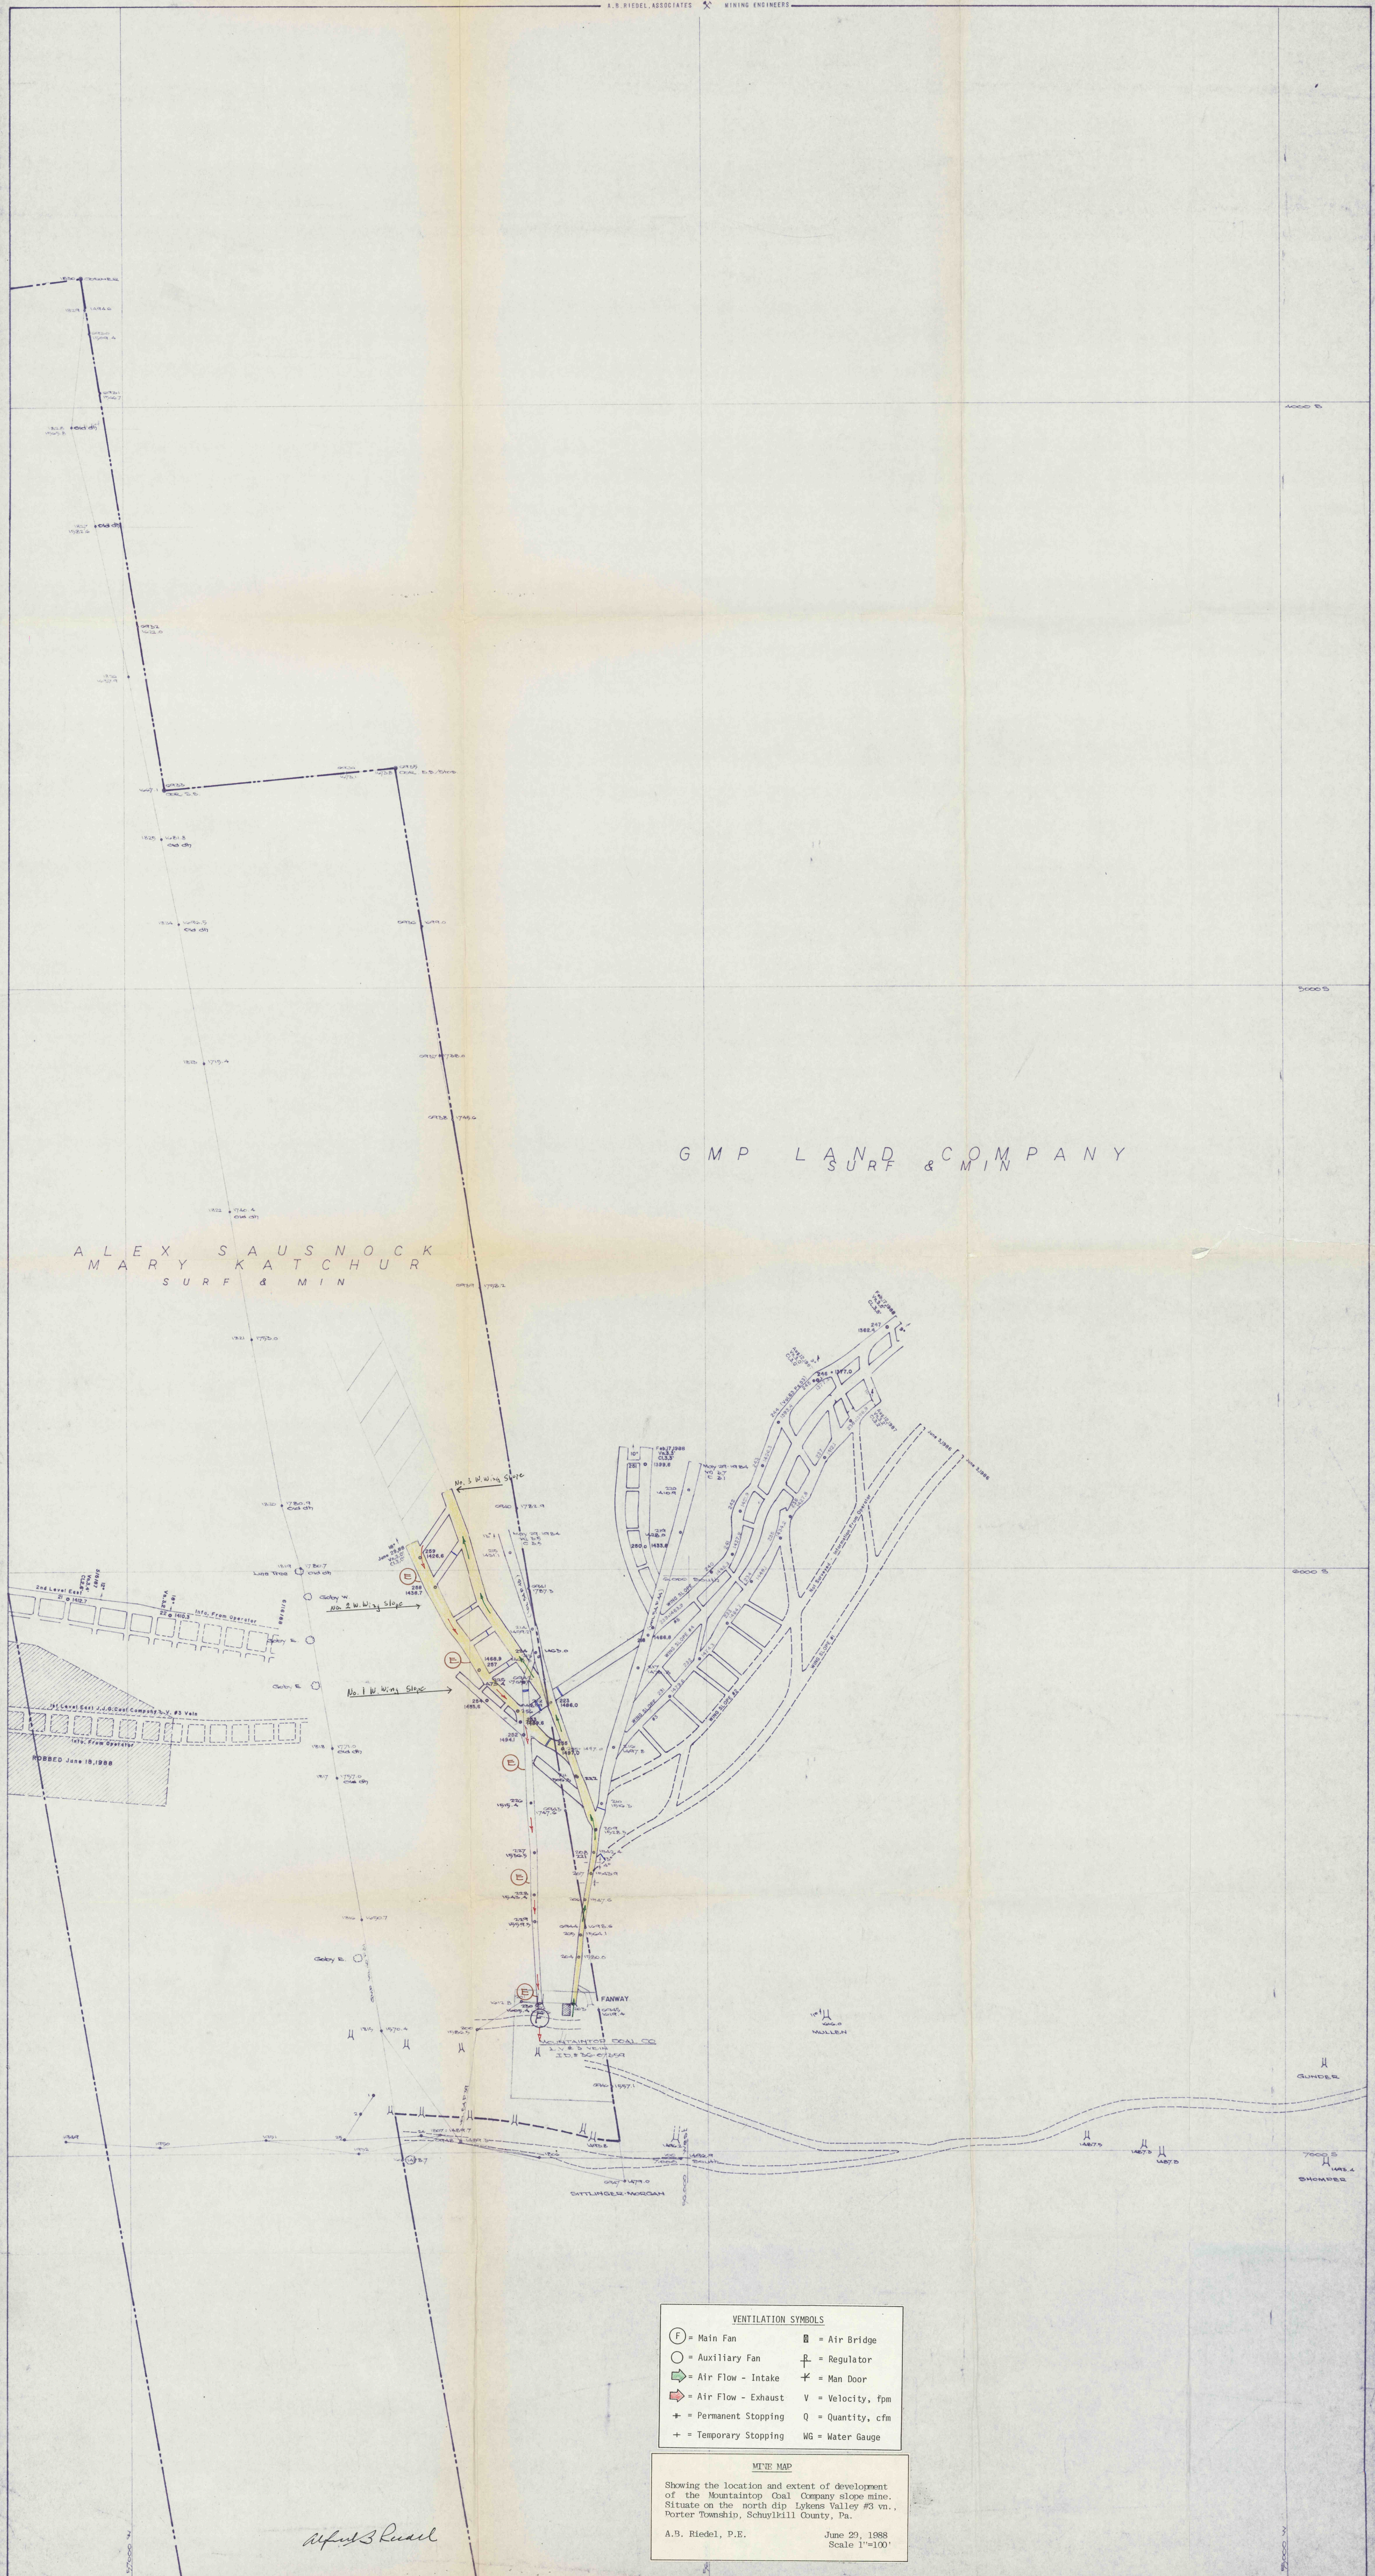

G M P L A N D & C O M P A N Y
S U R F & M I N

A L E X S A U S N O C K
M A R Y K A T C H U R
S U R F & M I N

VENTILATION SYMBOLS	
(F) = Main Fan	[Symbol] = Air Bridge
(O) = Auxiliary Fan	[Symbol] = Regulator
[Green Arrow] = Air Flow - Intake	[Symbol] = Man Door
[Red Arrow] = Air Flow - Exhaust	V = Velocity, fpm
+ = Permanent Stopping	Q = Quantity, cfm
+ = Temporary Stopping	WG = Water Gauge

MINE MAP
Showing the location and extent of development of the Mountaintop Coal Company slope mine. Situate on the north dip Lyles Valley #3 vein, Porter Township, Schuylkill County, Pa.
A.B. Riedel, P.E. June 29, 1988
Scale 1"=100'

A. B. Riedel