


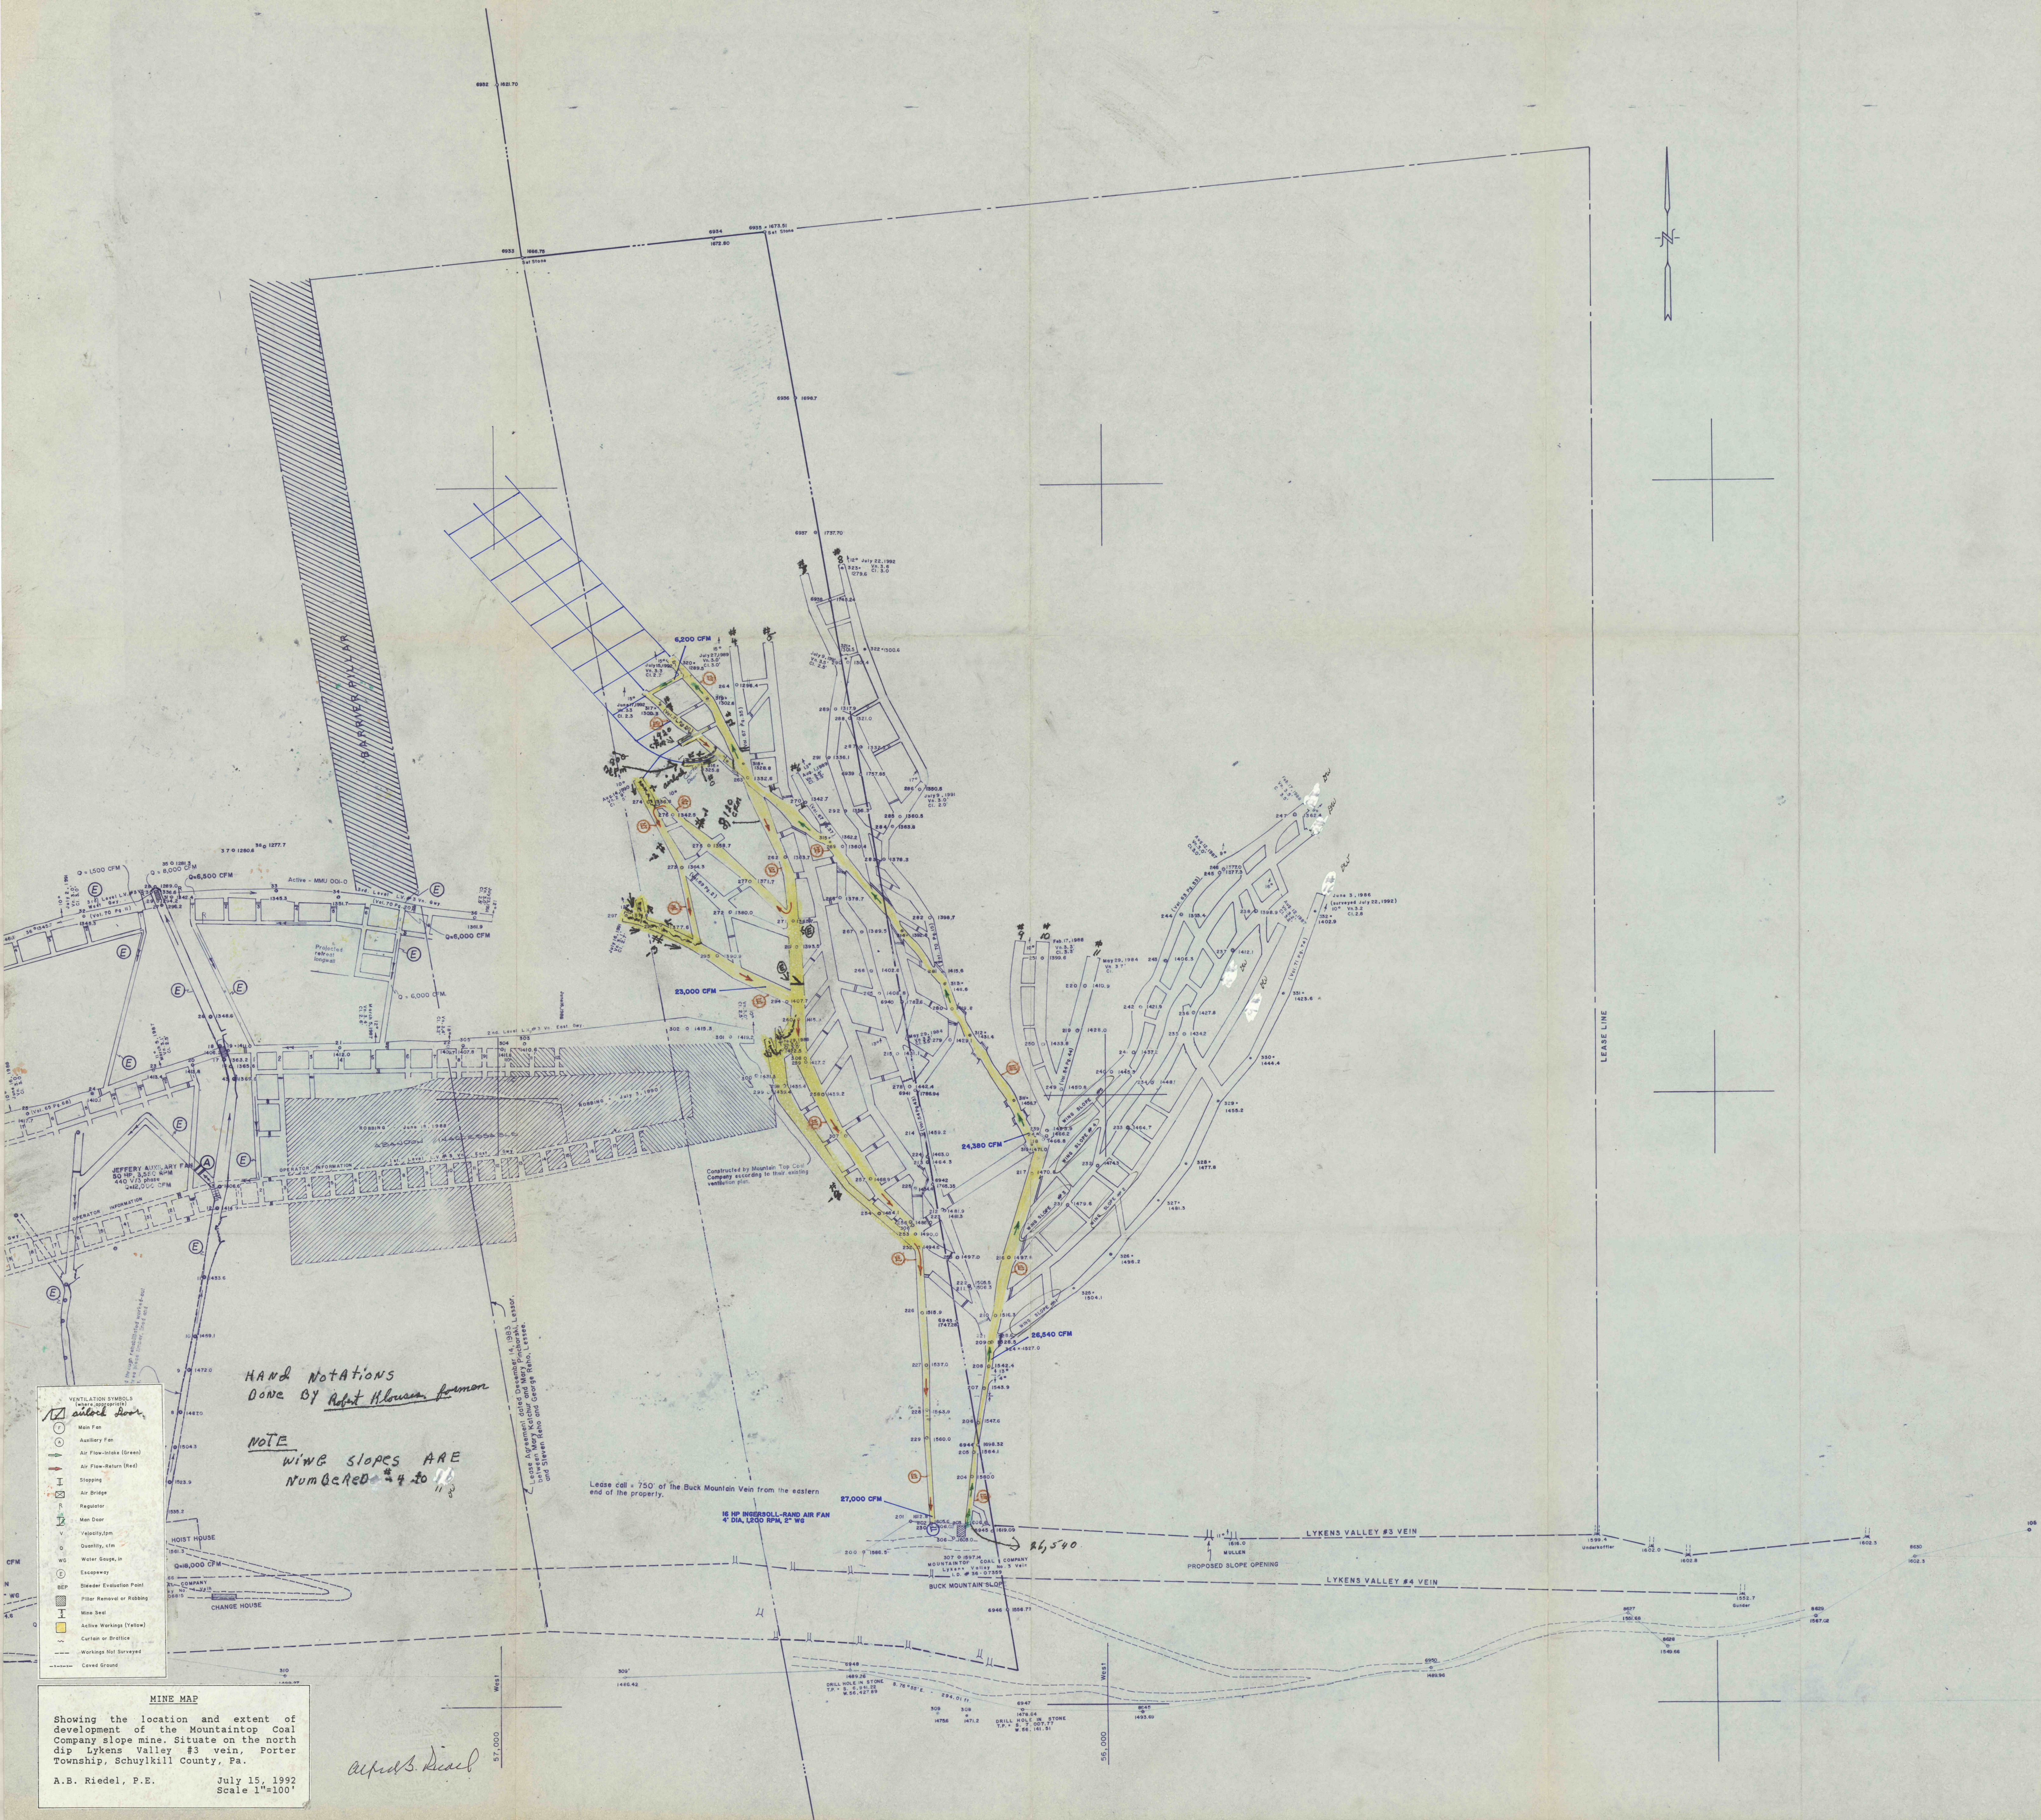

HAND NOTATIONS
Done By Robert H. House, Jr.

NOTE
WING SLOPES ARE
NUMBERED 4 to 11

Lease Agreement dated December 14, 1983
between Mary Katherine Pendergast, Lessee,
and Steven Keno and Company, Lessor.

Lease cell = 750' of the Buck Mountain Vein from the eastern
end of the property.

18 HP INTERMEDIATE-RAND AIR FAN
4 DIA. 1200 RPM, 2" WG

26,540

LYKENS VALLEY #3 VEIN

LYKENS VALLEY #4 VEIN

PROPOSED SLOPE OPENING

MINE MAP

Showing the location and extent of
development of the Mountain Top Coal
Company slope mine. Situated on the north
dip Lykens Valley #3 vein, Porter
Township, Schuylkill County, Pa.

A.B. Riedel, P.E. July 15, 1992
Scale 1"=100'