


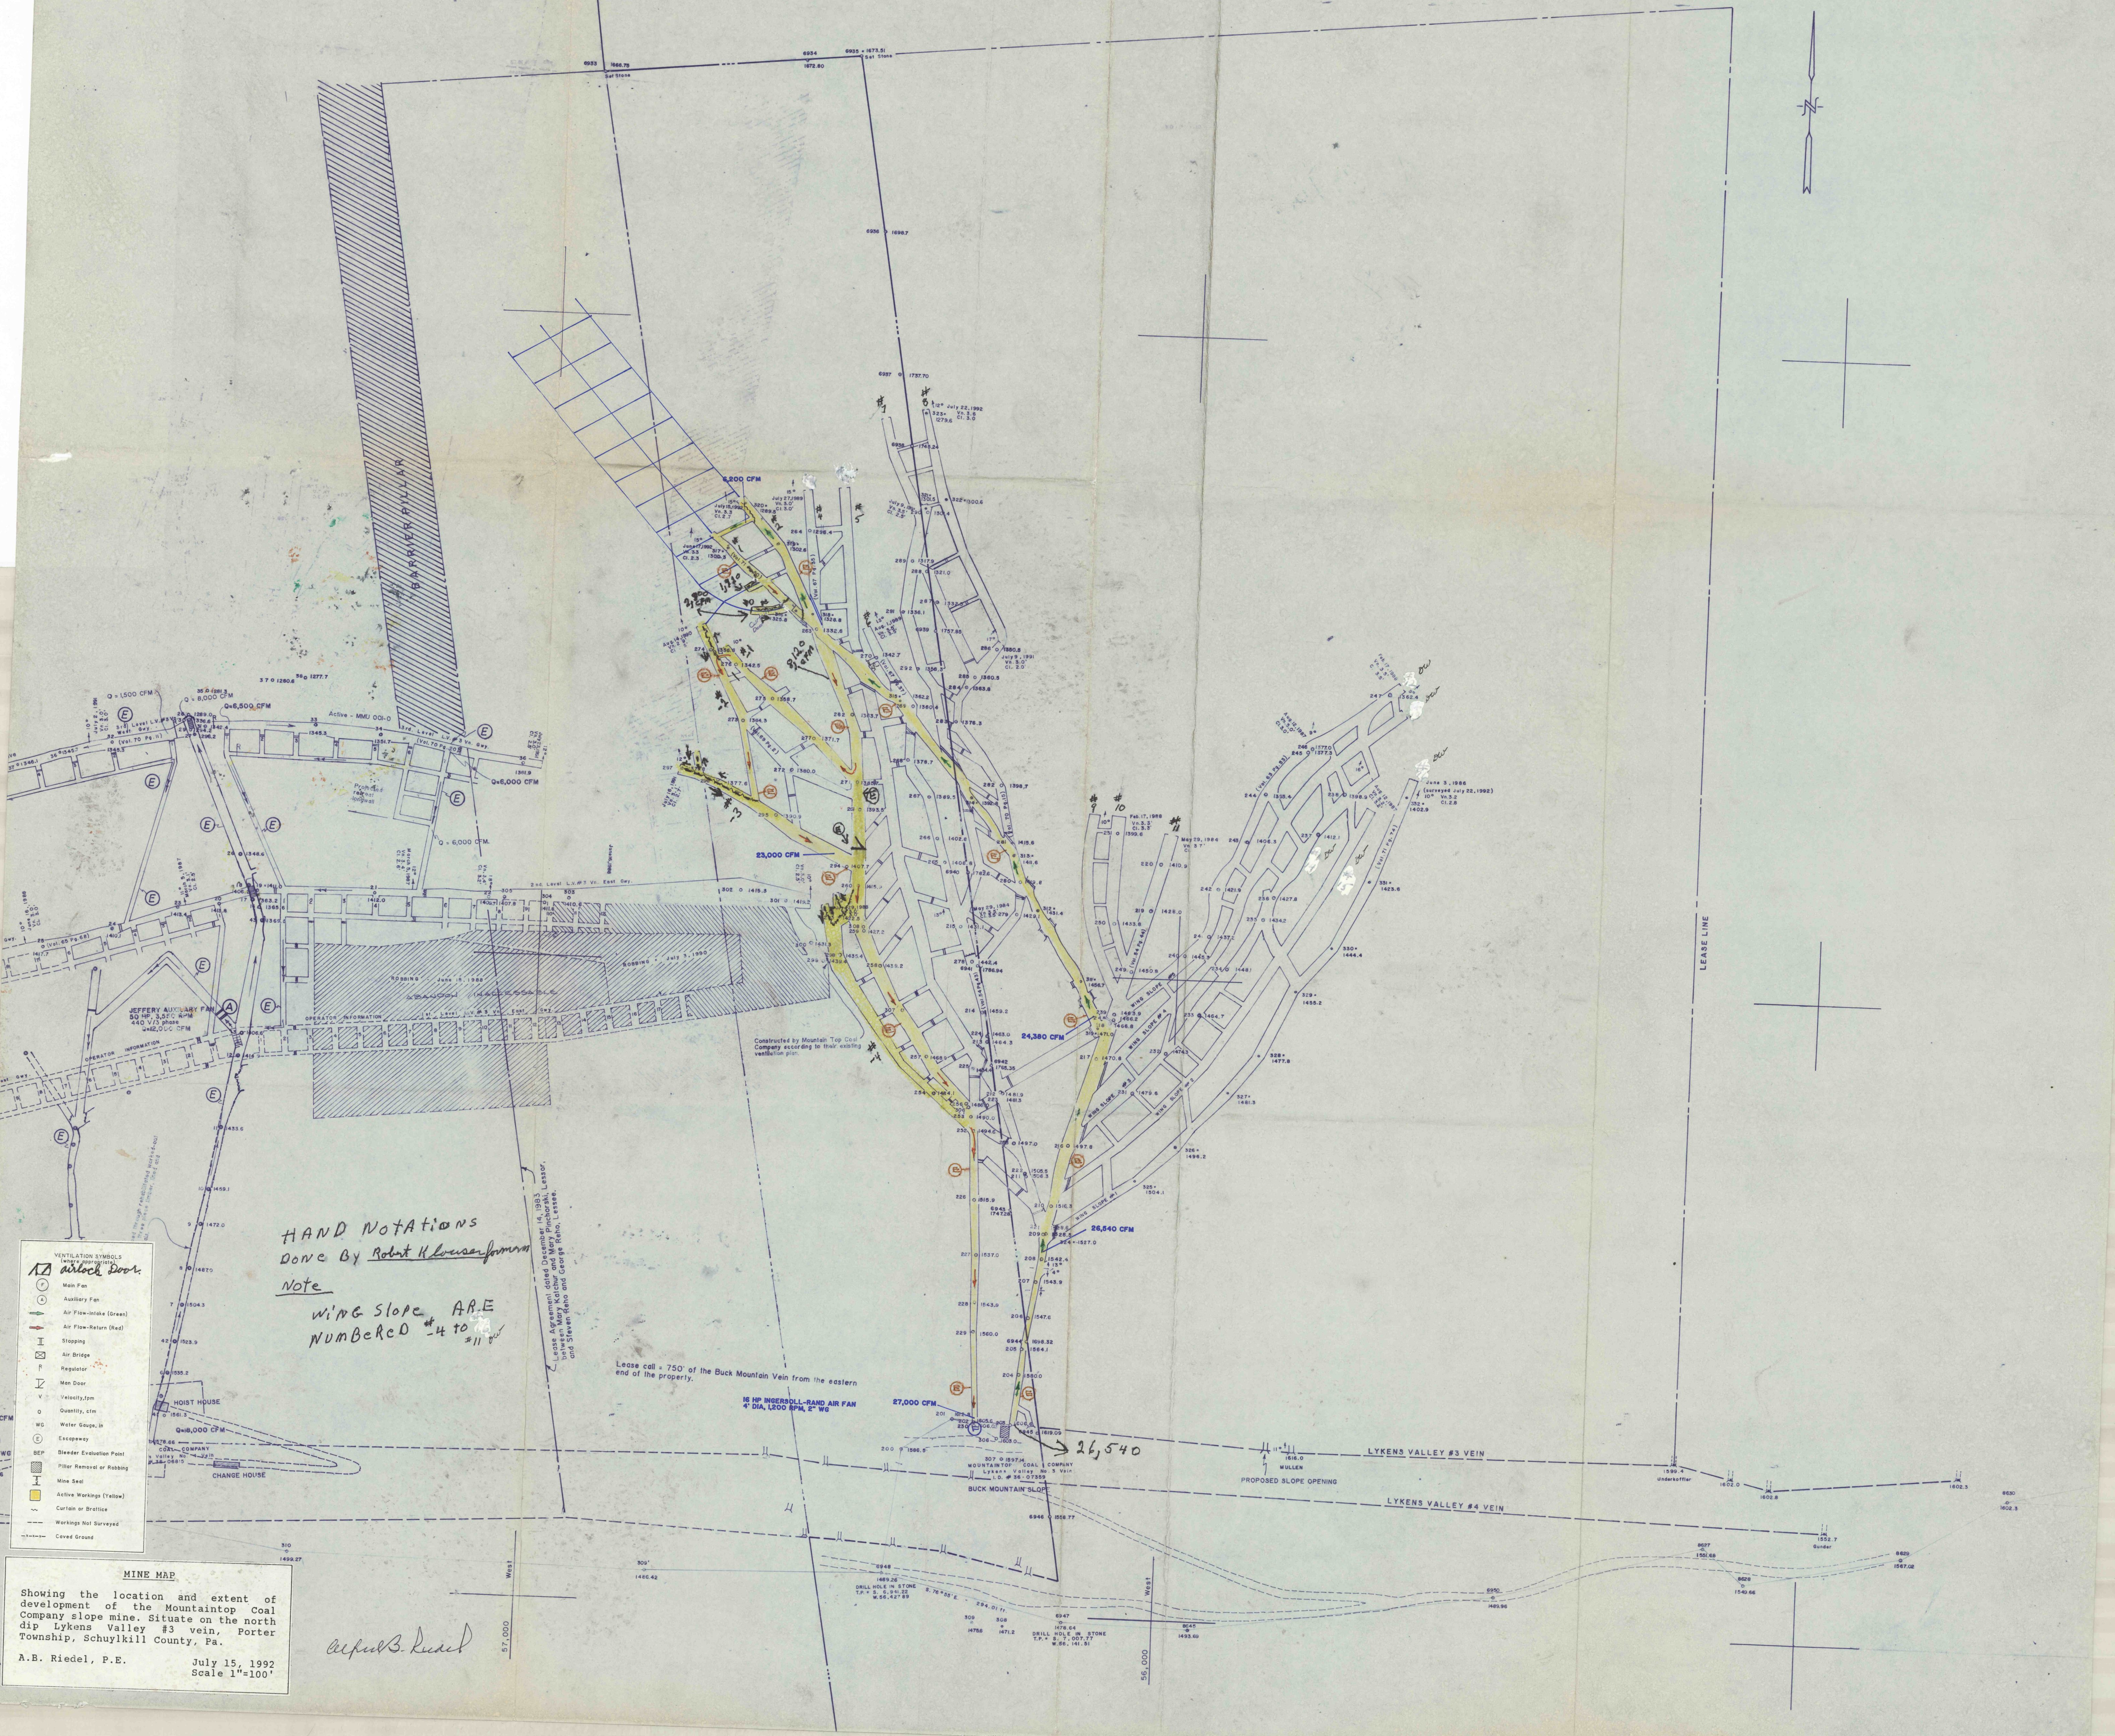

HAND NOTATIONS
DONE BY Robert K. House, Jr.
Note
WING SLOPE ARE
NUMBERED #4 TO #11

Lease Agreement dated December 14, 1993
between Mountaintop Coal Company and Mary Ann
and Steven Reno and George Reno, Lessee.

Lease call 750' of the Buck Mountain Vein from the eastern
end of the property.

16 HP INSERDOLL-RAND AIR FAN
4 DIA, 1500 RPM, 2" WG

27,000 CFM

26,540

PROPOSED SLOPE OPENING

LYKENS VALLEY #3 VEIN

LYKENS VALLEY #4 VEIN

- VENTILATION SYMBOLS
- Main Fan
 - Aspirator Fan
 - Air Flow-Intake (Green)
 - Air Flow-Return (Red)
 - Stopping
 - Air Bridge
 - Regulator
 - Man Door
 - Velocity Fan
 - Quantity, cfm
 - Water Gauge, in
 - Escapeway
 - Bladder Evaluation Point
 - Pillar Removal or Raising
 - Mine Seal
 - Active Workings (Yellow)
 - Curbs or Brattice
 - Workings Not Surveyed
 - Covered Ground

MINE MAP
Showing the location and extent of
development of the Mountaintop Coal
Company slope mine. Situated on the north
dip Lykens Valley #3 vein, Porter
Township, Schuylkill County, Pa.
A.B. Riedel, P.E. July 15, 1992
Scale 1"=100'

april 3, 1992