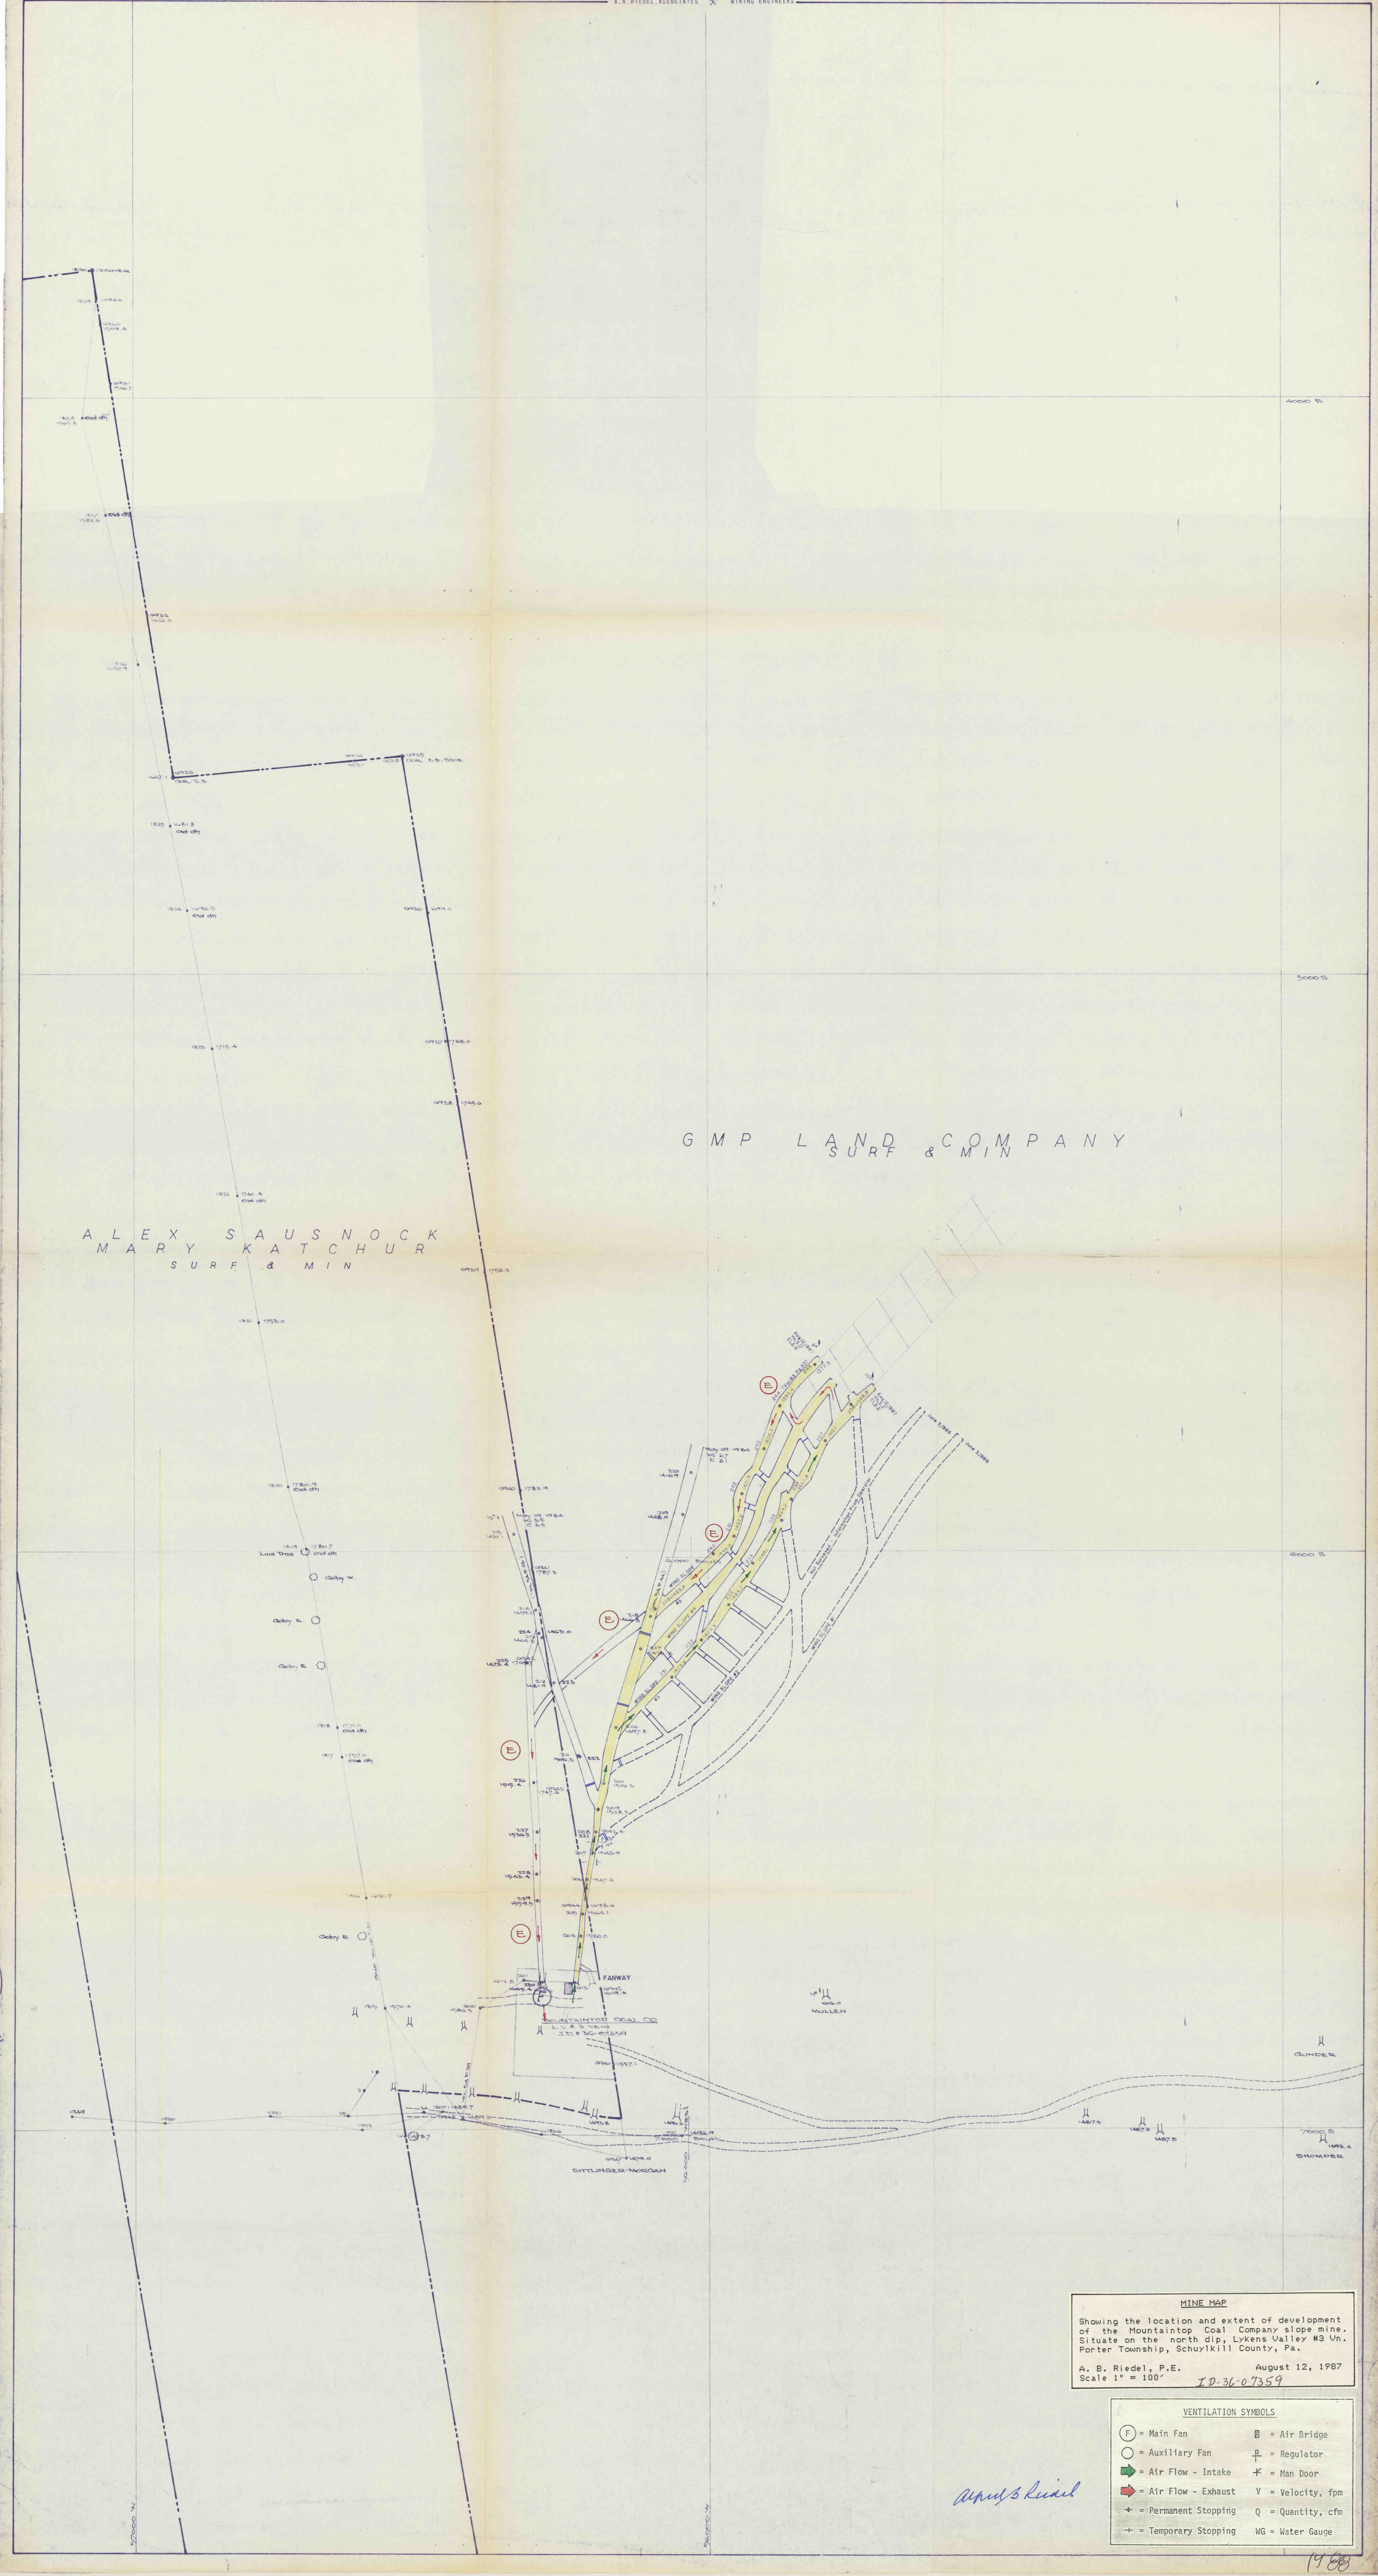
A. B. RIEDEL, ASSOCIATES X MINING ENGINEERS
GMP LAND COMPANY
SURF & MIN
ALEX SAUSNOCK
MARY KATCHUR
SURF & MIN
FANWAY
MOUNTAINTOP COAL CO
LYKENS VALLEY
ID 36-07359
MULLEN
GUNDER
SHOMPER
BATTLINGER-NORCAM
MINE MAP
Showing the location and extent of development of the Mountaintop Coal Company slope mine. Situate on the north dip, Lykens Valley #3 Vn. Porter Township, Schuylkill County, Pa.
A. B. Riedel, P.E.
August 12, 1987
Scale 1" = 100'
ID-36-07359
VENTILATION SYMBOLS
F = Main Fan
= Auxiliary Fan
= Air Flow - Intake
= Air Flow - Exhaust
= Permanent Stopping
= Temporary Stopping
B = Air Bridge
R = Regulator
= Man Door
V = Velocity, fpm
Q = Quantity, cfm
WG = Water Gauge
(1988)