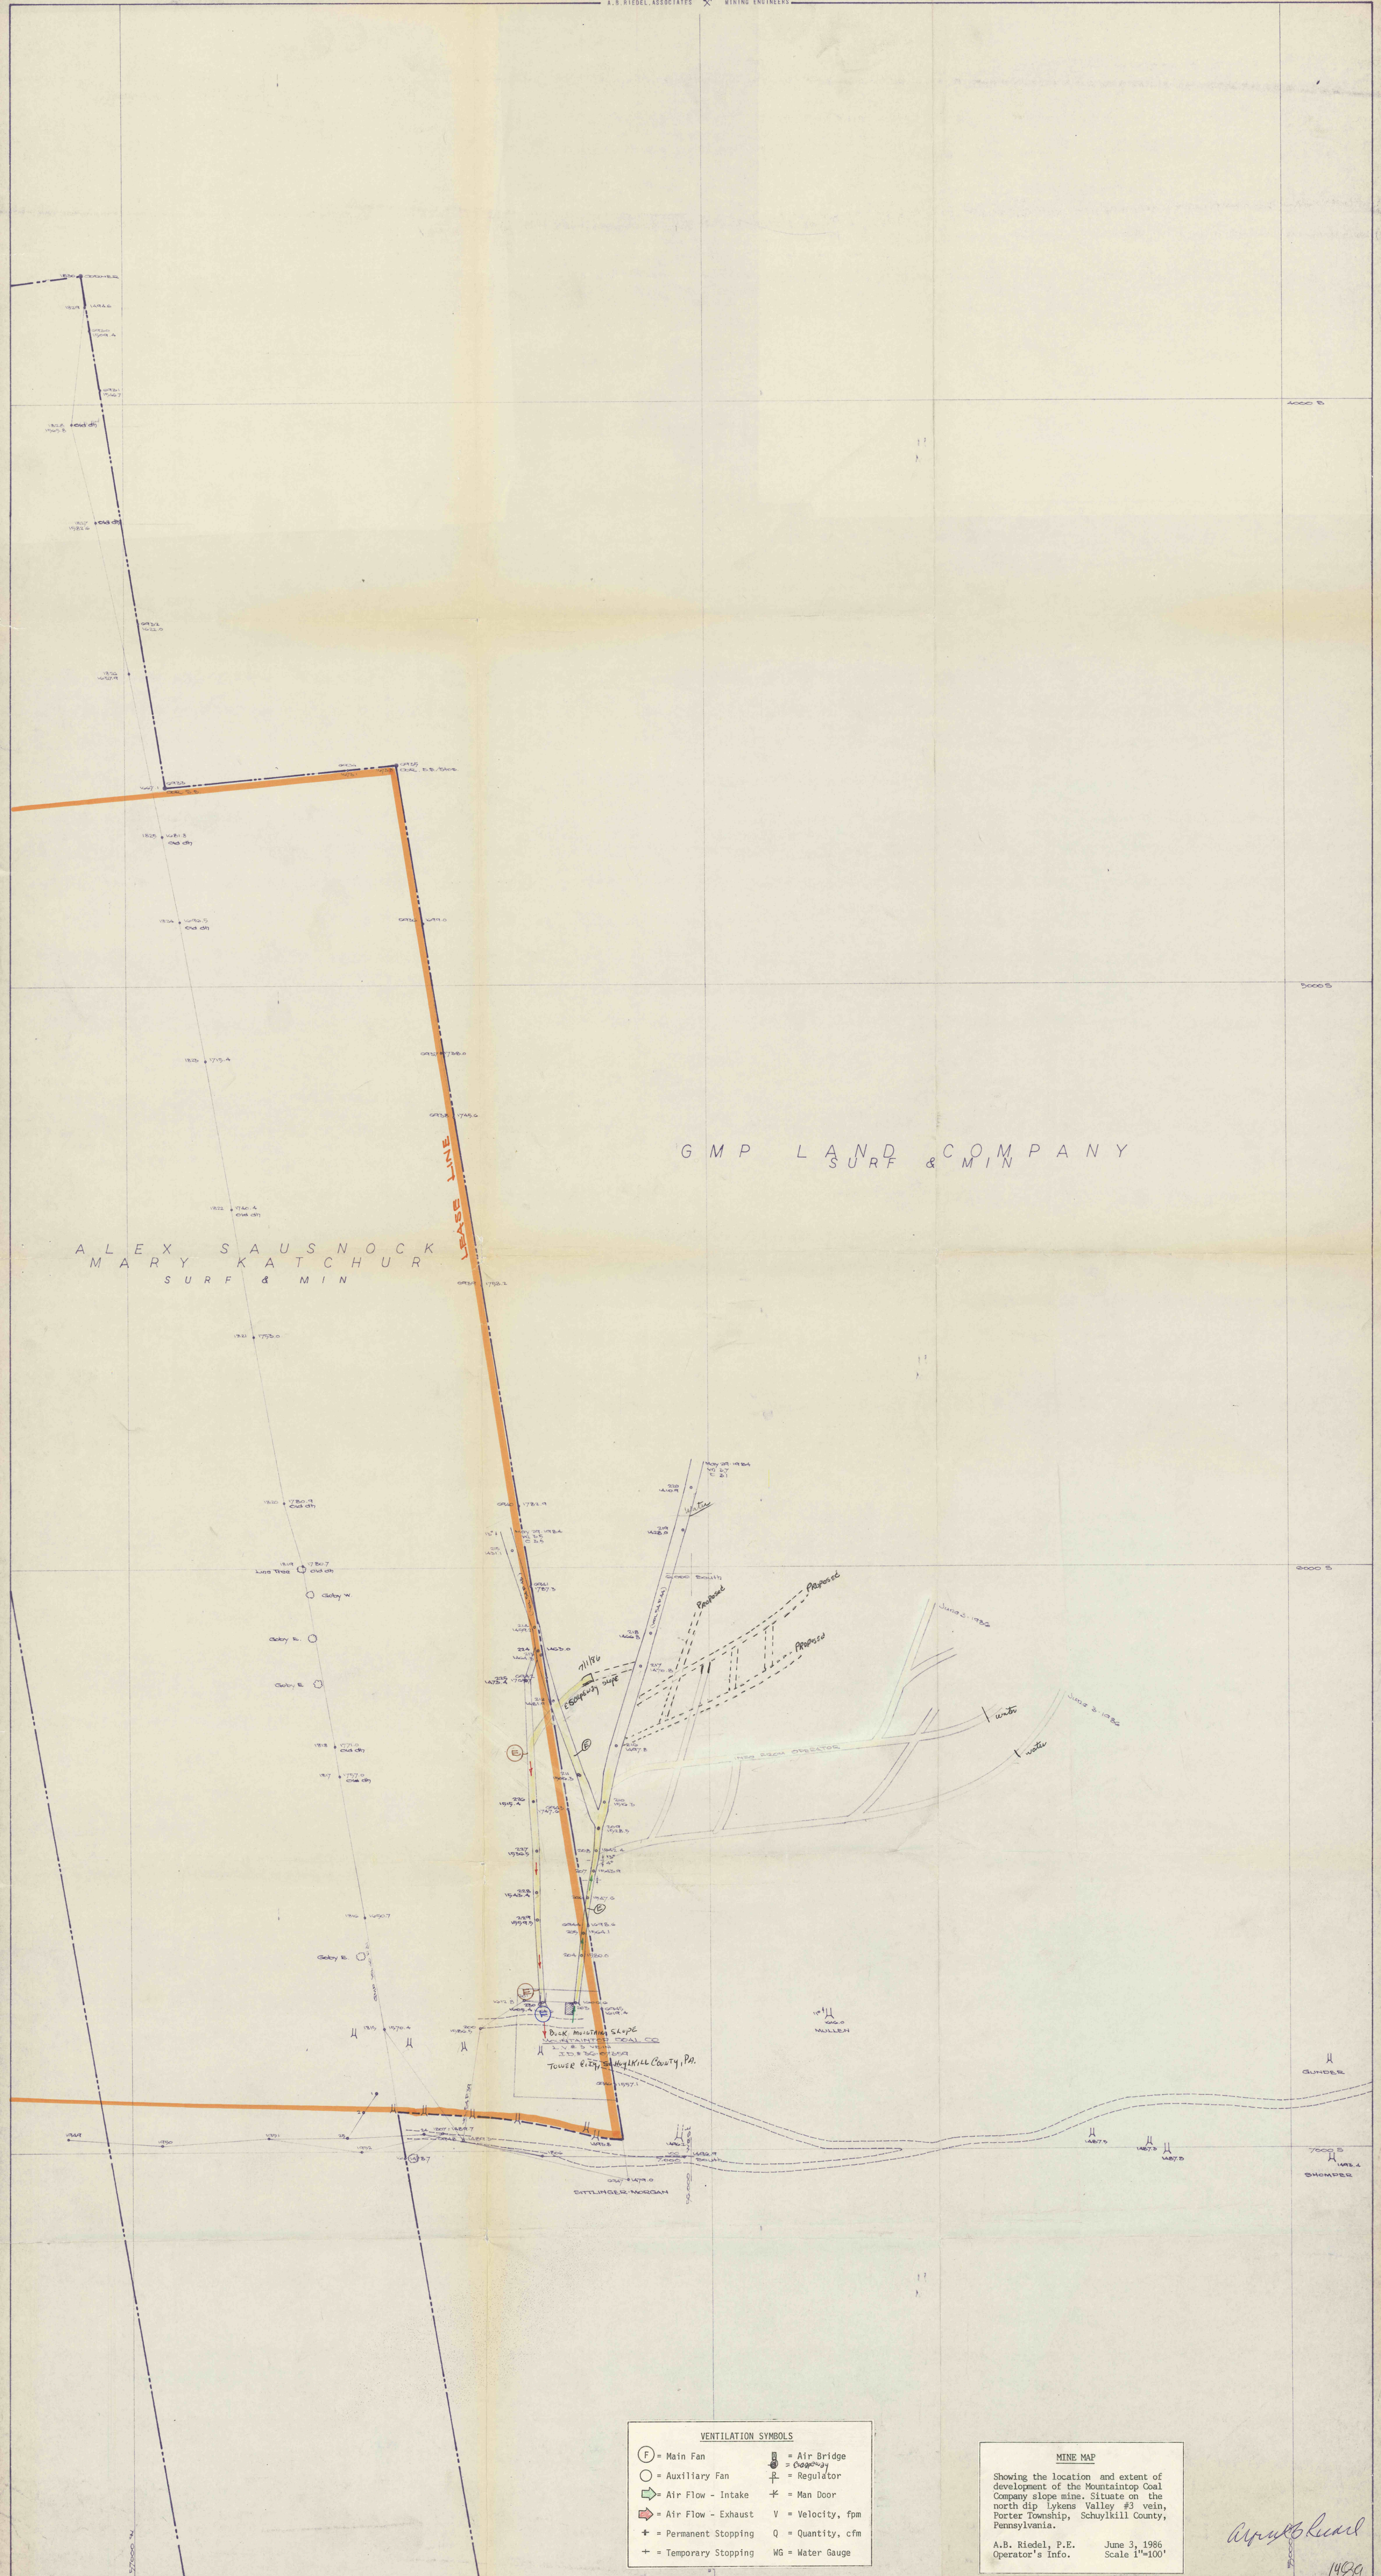

VENTILATION SYMBOLS

(F) = Main Fan	= Air Bridge or Overcast
○ = Auxiliary Fan	= Regulator
= Air Flow - Intake	= Man Door
= Air Flow - Exhaust	V = Velocity, fpm
+ = Permanent Stopping	Q = Quantity, cfm
+ = Temporary Stopping	WG = Water Gauge

MINE MAP

Showing the location and extent of development of the Mountaintop Coal Company slope mine. Situate on the north dip Lykens Valley #3 vein, Porter Township, Schuylkill County, Pennsylvania.

A.B. Riedel, P.E. June 3, 1986
Operator's Info. Scale 1"=100'

Arnold B. Riedel

1489