


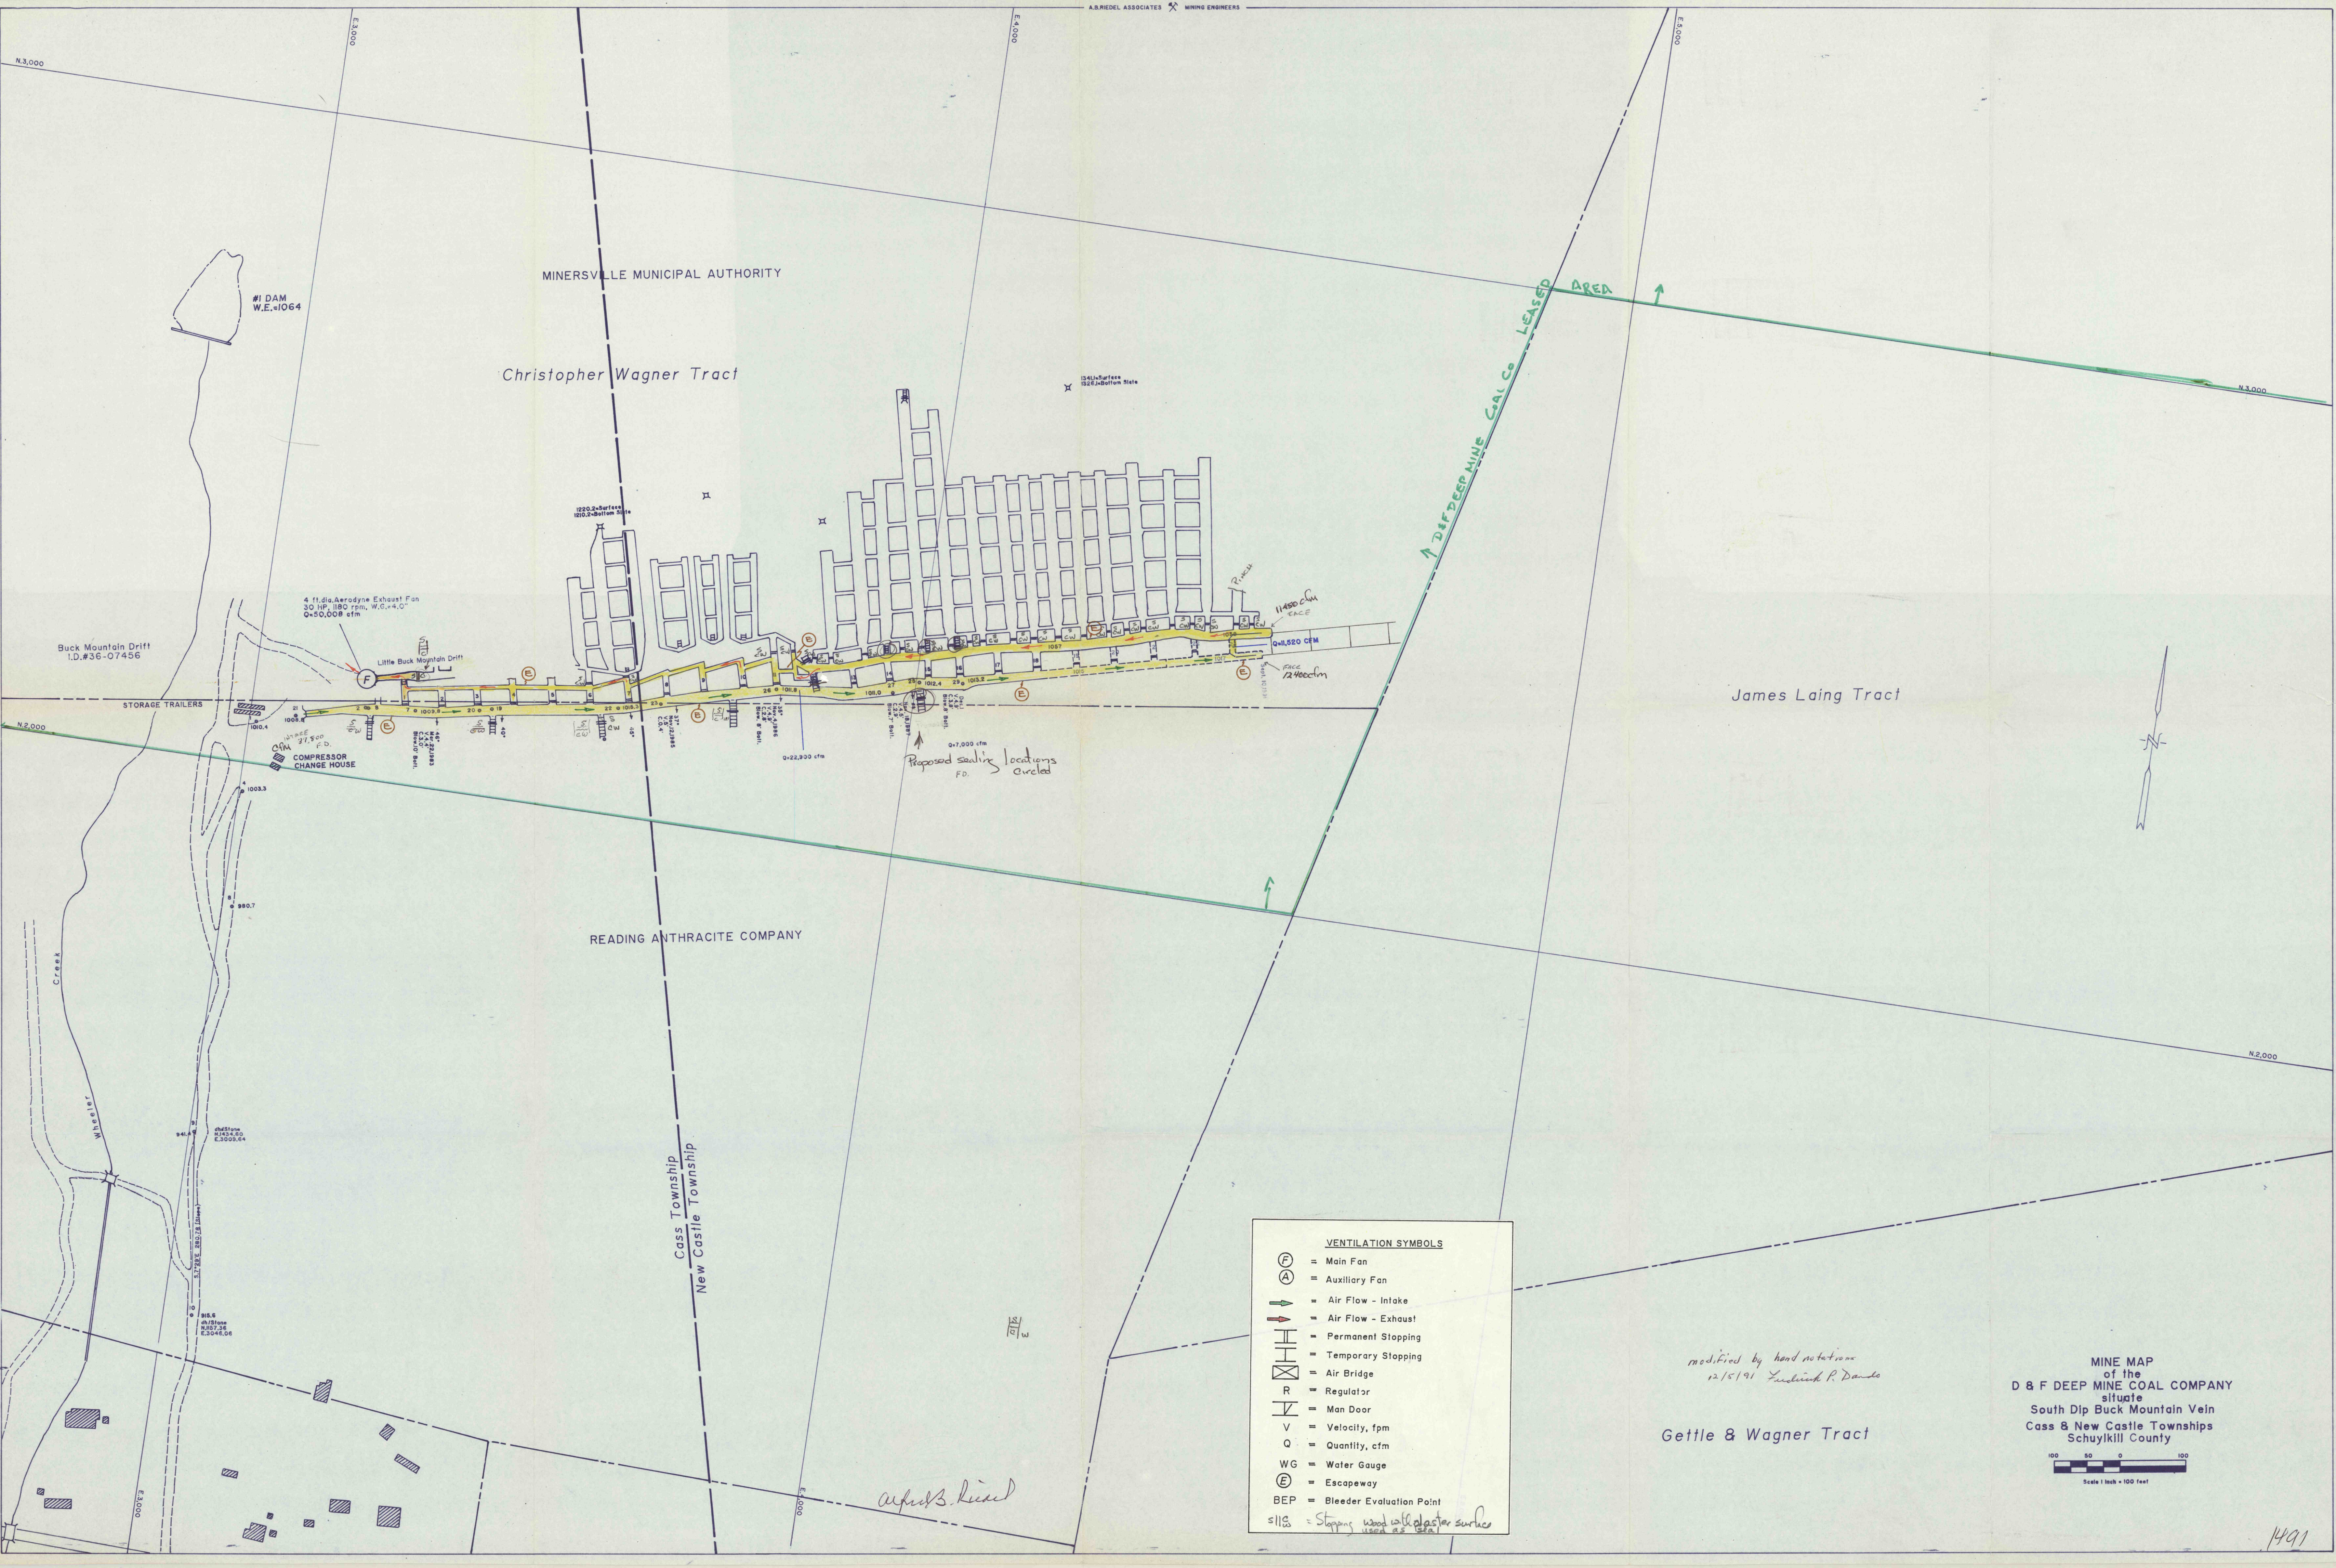

MINERSVILLE MUNICIPAL AUTHORITY

Christopher Wagner Tract

READING ANTHRACITE COMPANY


James Laing Tract

Gettle & Wagner Tract

VENTILATION SYMBOLS

- (F) = Main Fan
- (A) = Auxiliary Fan
- = Air Flow - Intake
- ← = Air Flow - Exhaust
- = Permanent Stopping
- - - = Temporary Stopping
- ⊠ = Air Bridge
- R = Regulator
- ∇ = Man Door
- V = Velocity, fpm
- Q = Quantity, cfm
- WG = Water Gauge
- (E) = Escapeway
- BEP = Bleeder Evaluation Point
- slip = Stopping wood with plaster surface

MINE MAP
of the
D & F DEEP MINE COAL COMPANY
situate
South Dip Buck Mountain Vein
Cass & New Castle Townships
Schuylkill County

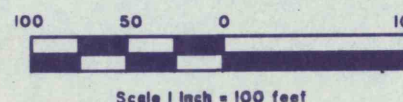

modified by hand notations
12/5/91 *Frederick R. Dando*