


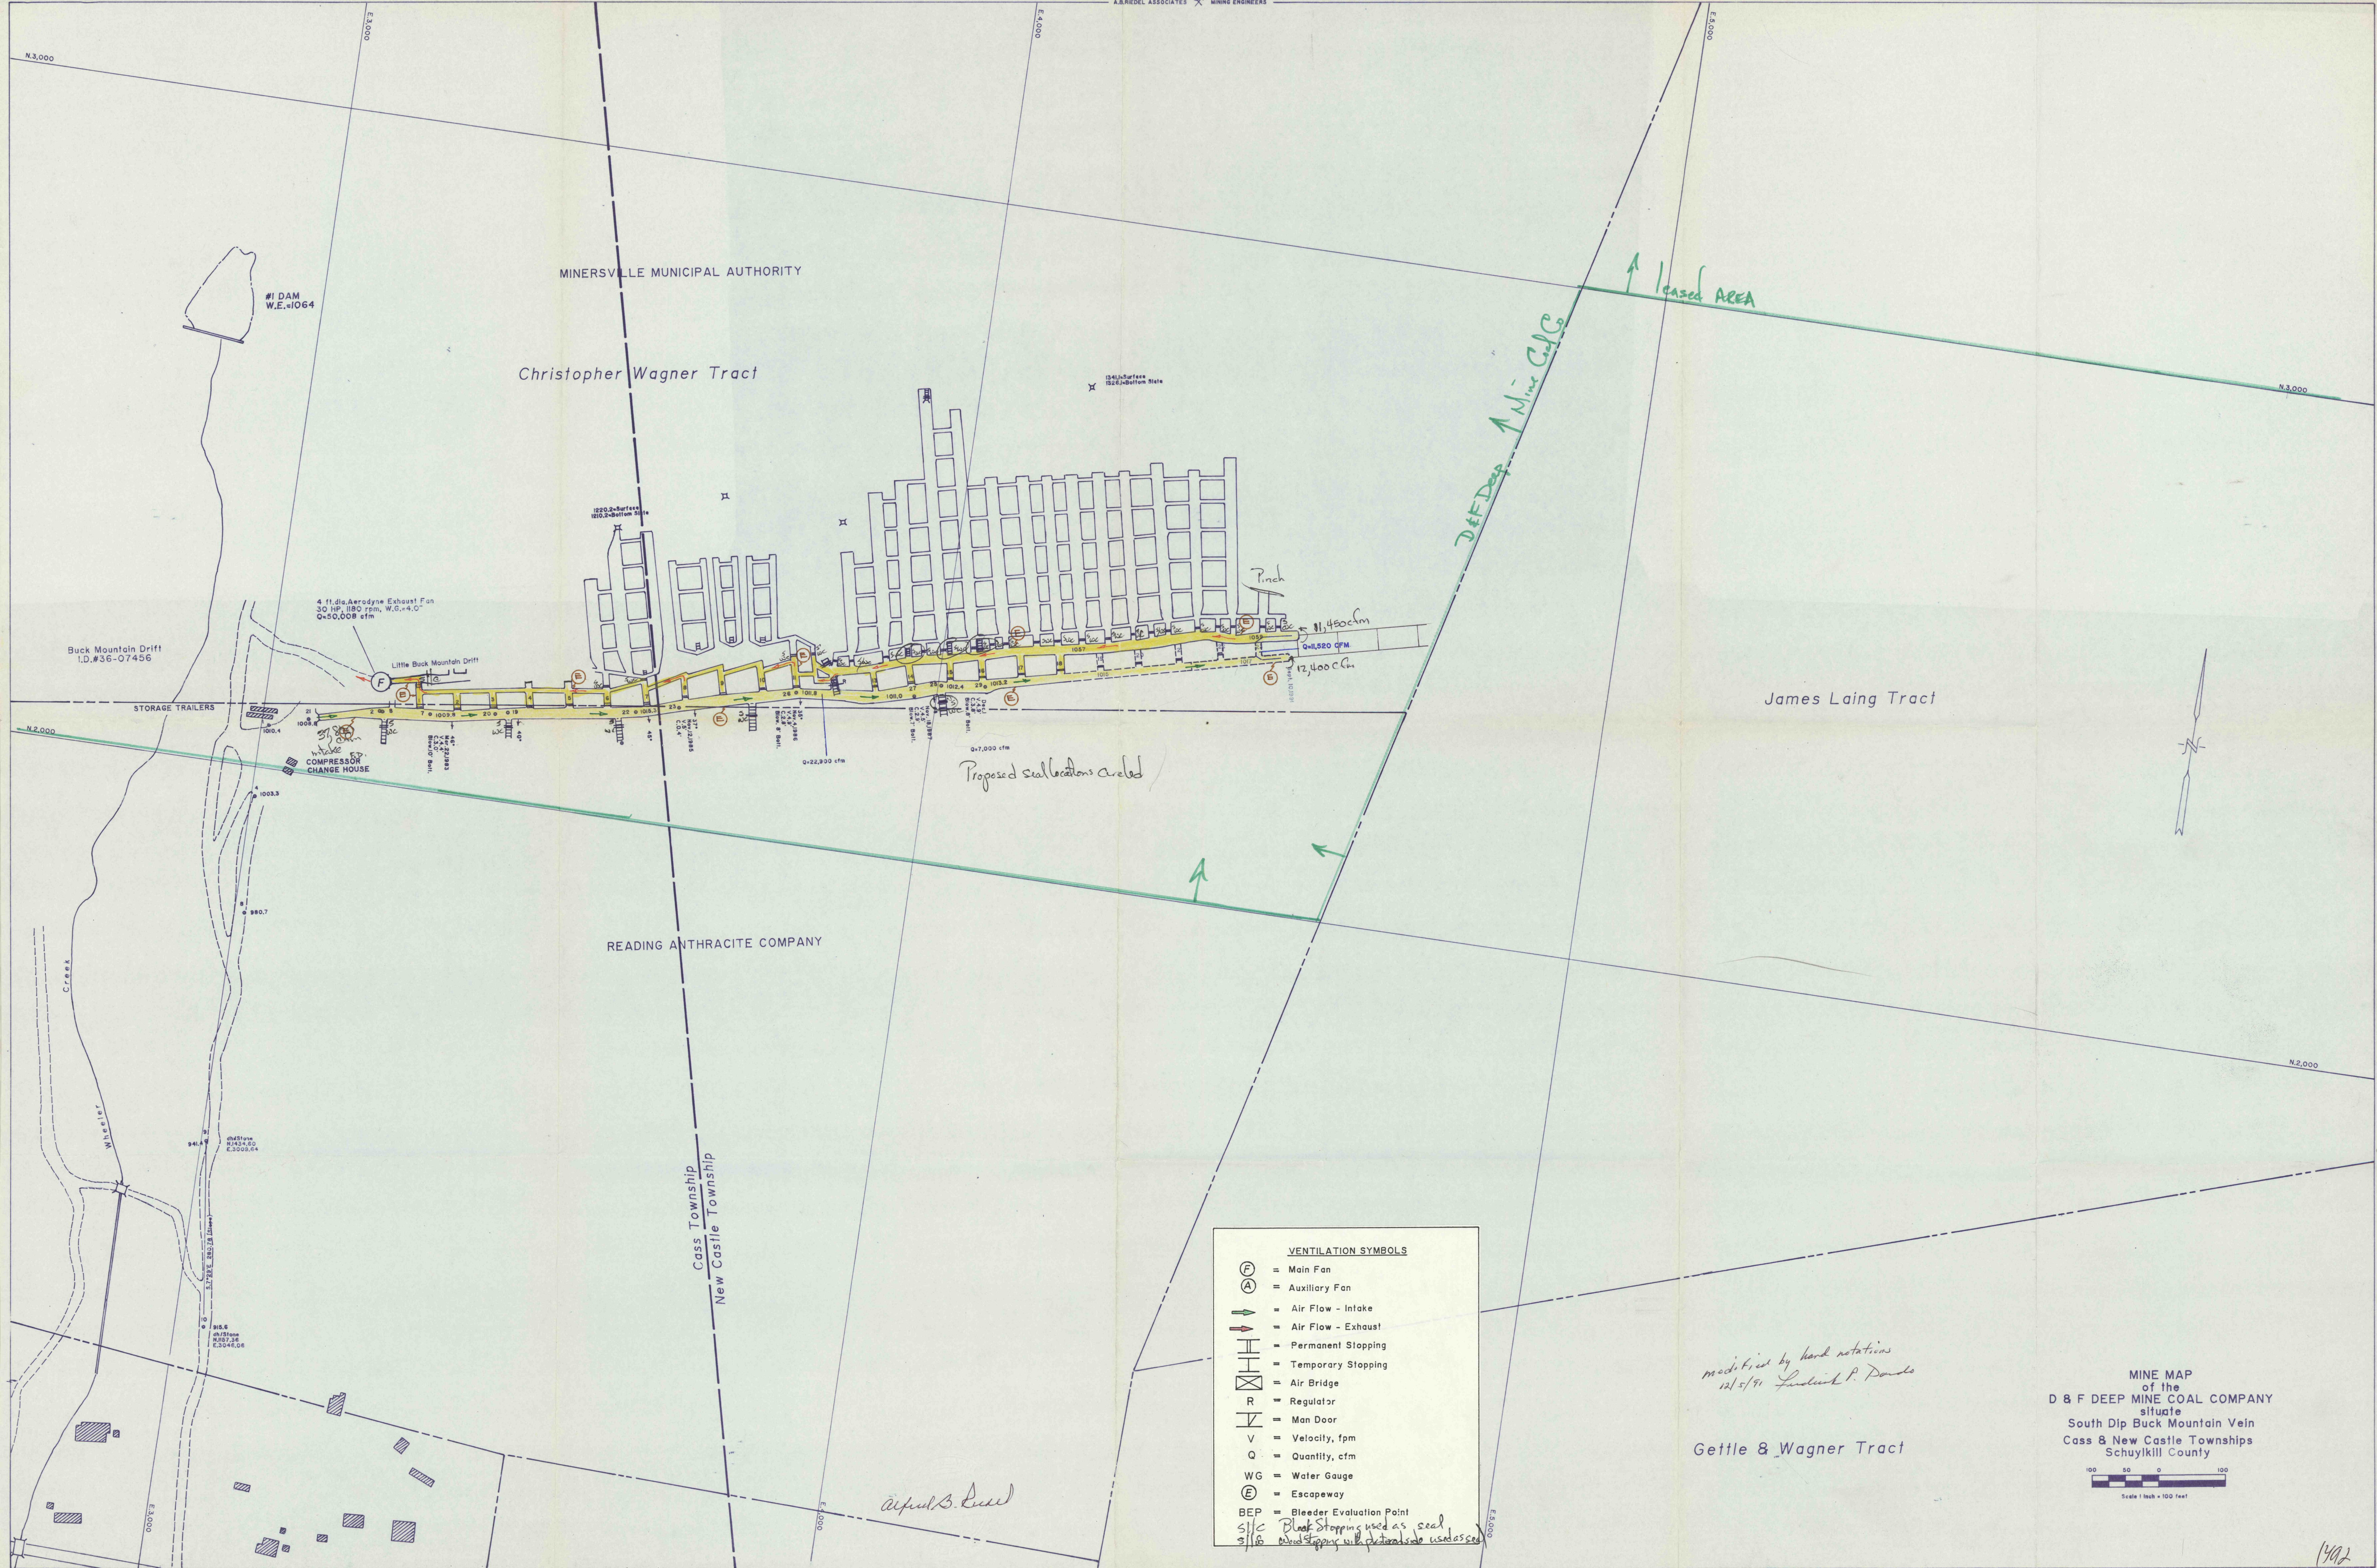

MINERSVILLE MUNICIPAL AUTHORITY

Christopher Wagner Tract

James Laing Tract

READING ANTHRACITE COMPANY

Cass Township
New Castle Township

Gettle & Wagner Tract

VENTILATION SYMBOLS	
(F)	= Main Fan
(A)	= Auxiliary Fan
→	= Air Flow - Intake
←	= Air Flow - Exhaust
— —	= Permanent Stopping
— — —	= Temporary Stopping
—X—	= Air Bridge
R	= Regulator
V	= Man Door
V	= Velocity, fpm
Q	= Quantity, cfm
WG	= Water Gauge
(E)	= Escapeway
BEP	= Bleeder Evaluation Point
S/C	= Black Stopping used as seal
S/B	= Wood Stopping with petroleum used as seal

MINE MAP
of the
D & F DEEP MINE COAL COMPANY
situate
South Dip Buck Mountain Vein
Cass & New Castle Townships
Schuylkill County

