


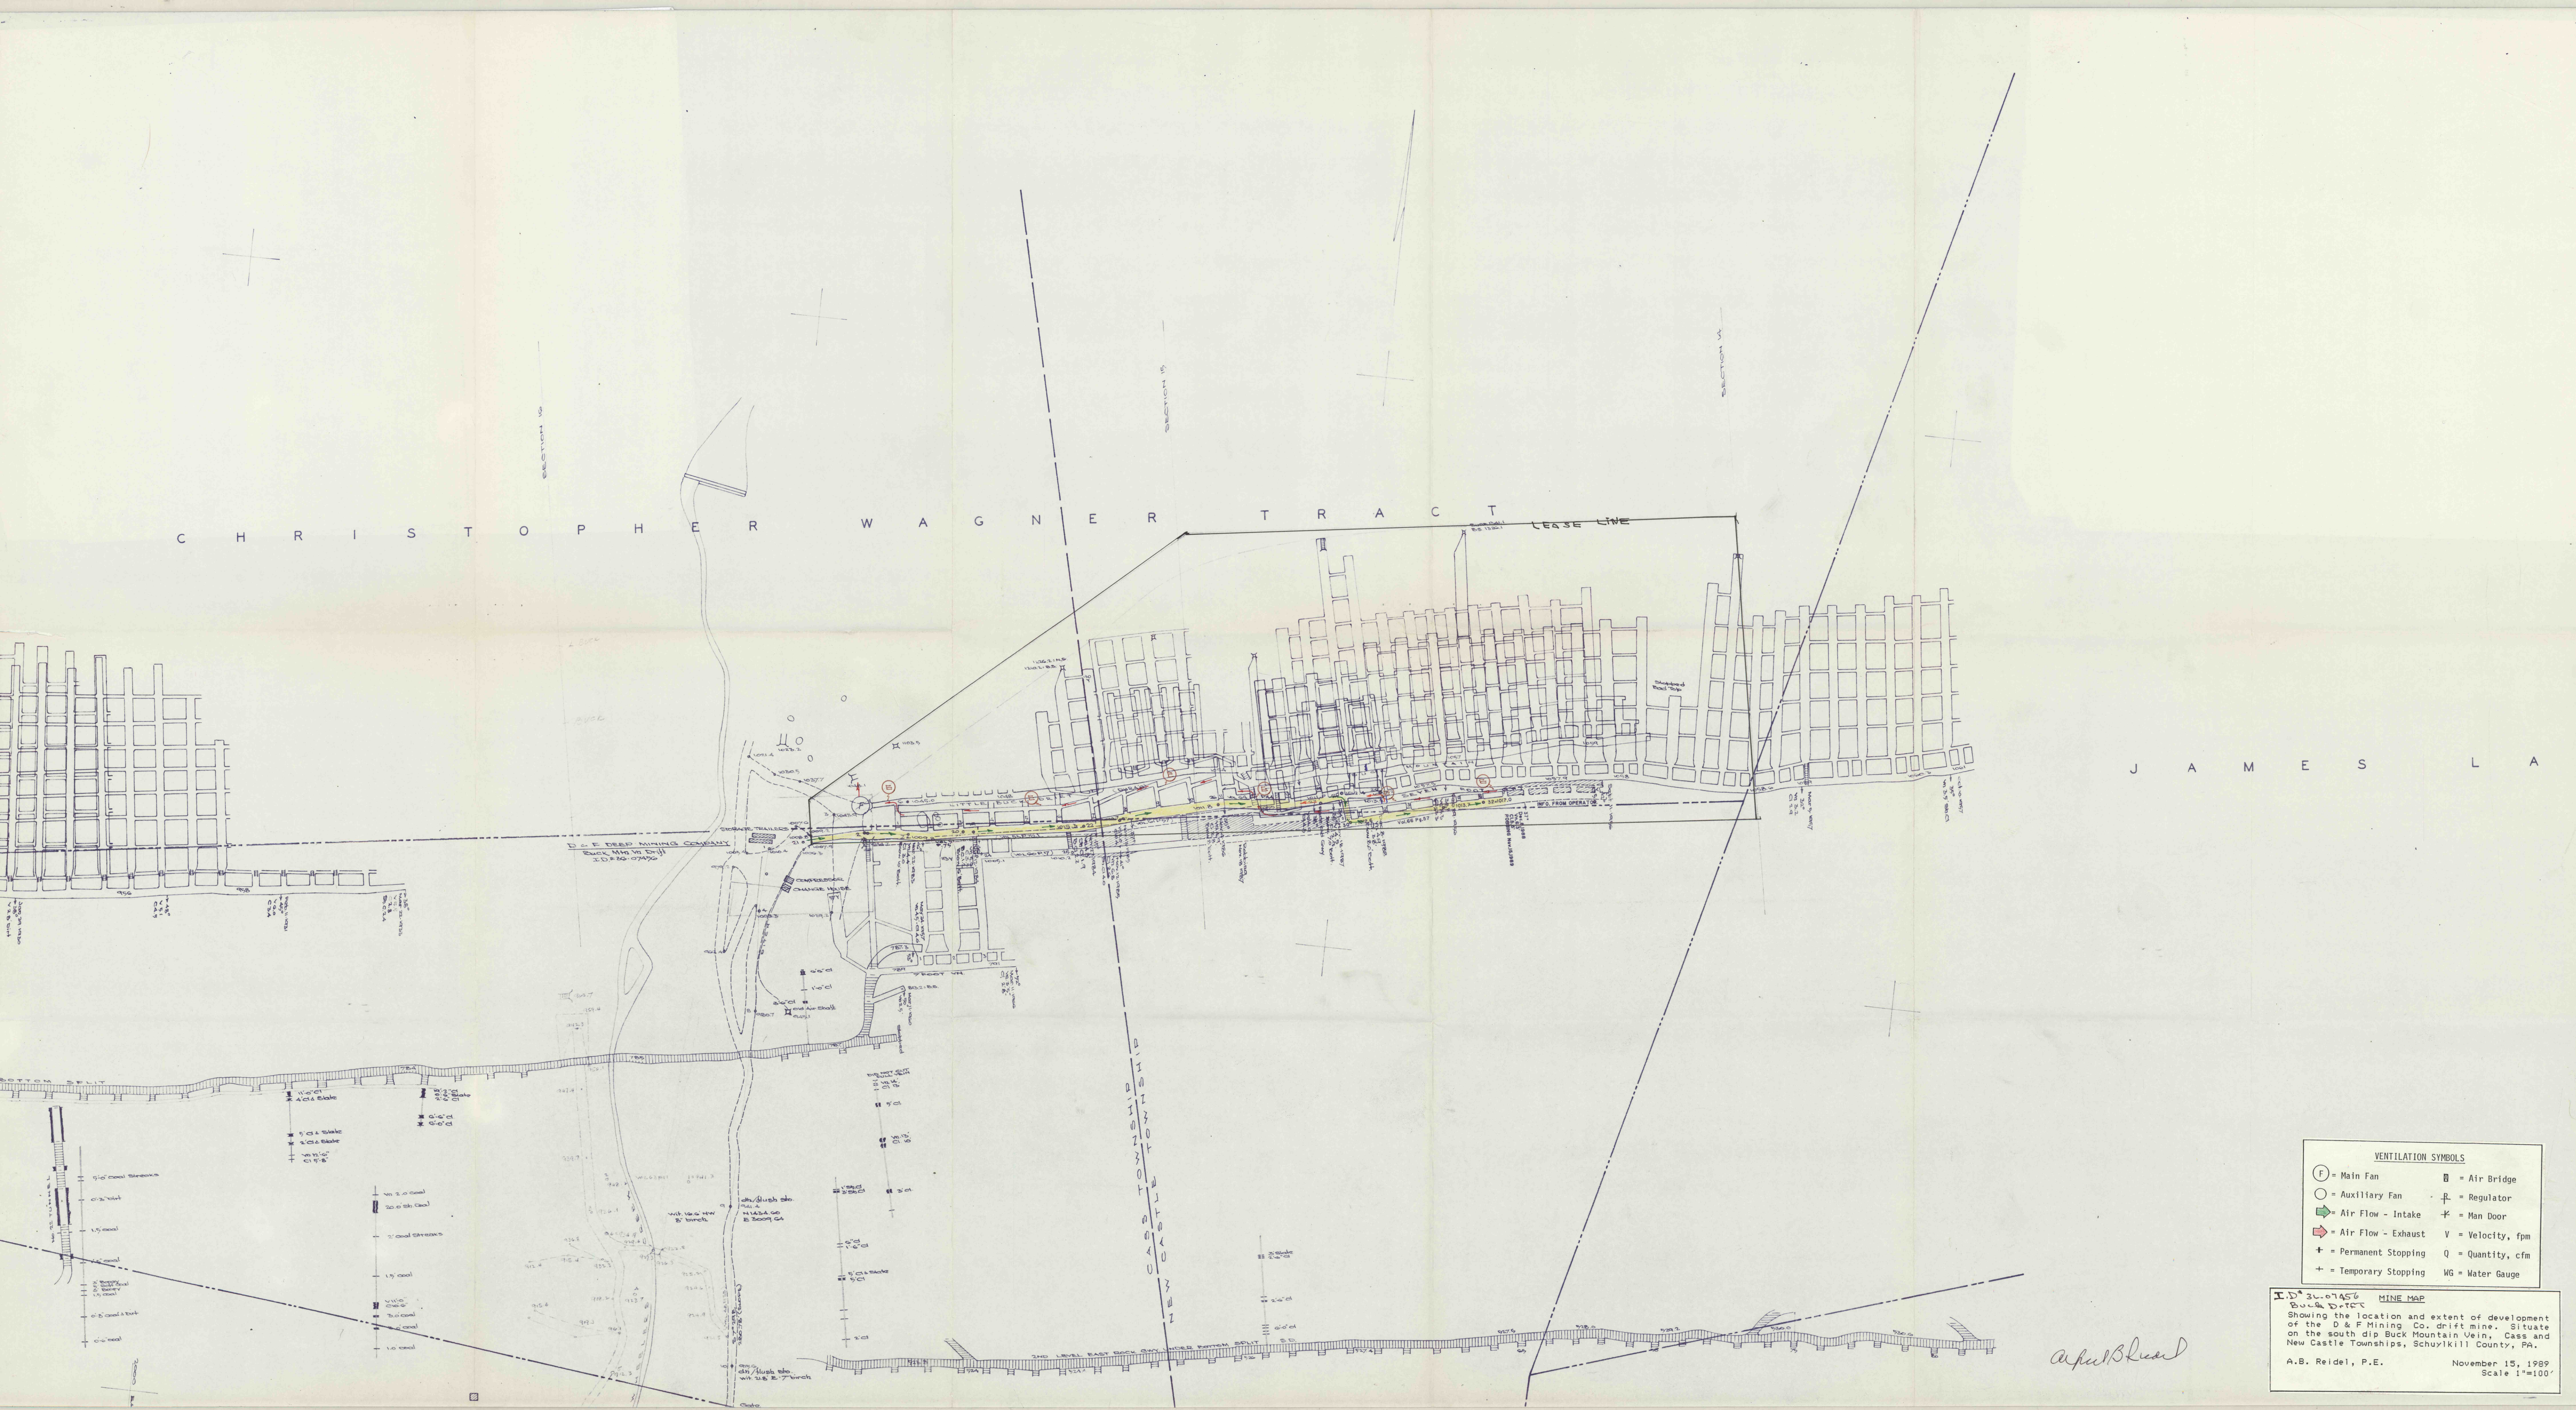

VENTILATION SYMBOLS	
(F) = Main Fan	▢ = Air Bridge
(A) = Auxiliary Fan	⌄ = Regulator
→ = Air Flow - Intake	⋈ = Man Door
↔ = Air Flow - Exhaust	V = Velocity, fpm
⊕ = Permanent Stopping	Q = Quantity, cfm
⊙ = Temporary Stopping	WG = Water Gauge

I.D. 20-07456 MINE MAP
Buck Drift
Showing the location and extent of development of the D & F Mining Co. drift mine. Situate on the south dip Buck Mountain Vein, Cass and New Castle Townships, Schuylkill County, PA.
A.B. Reidel, P.E. November 15, 1989
Scale 1"=100'

apfBread