

B O S L E G O

READING ANTHRACITE COMPANY

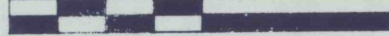
NORTHUMBERLAND
COUNTY COMMISSIONERS

LEONA BOSLEGIO

ALEXANDER HUNTER WARRANTEE TRACT

LAND SALES COLLIERY

R O S I N I C O A L C O M P A N Y

- MINE MAP
of the
OLAF COAL COMPANY, INC.
situate on the _____
North Dip #0 Vein
- West Cameron Twp., Northumberland County
No. 1 SEATE
36-07469
- 

Scale 1 inch = 100 feet
- MAY POSTING FEBRUARY 22, 1992**

Arthur B. Lucard