
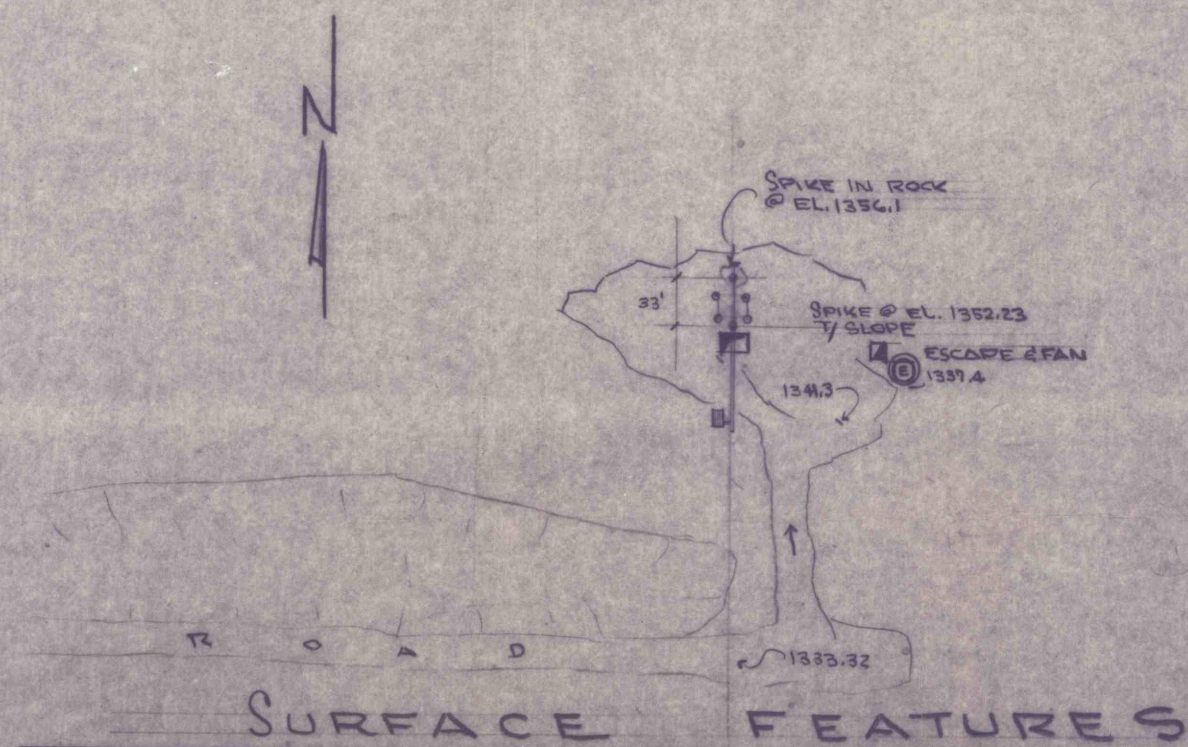
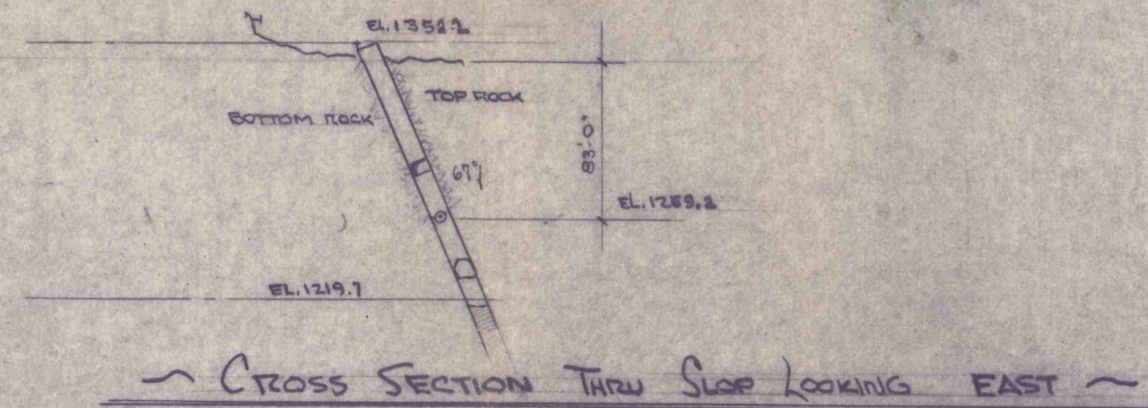


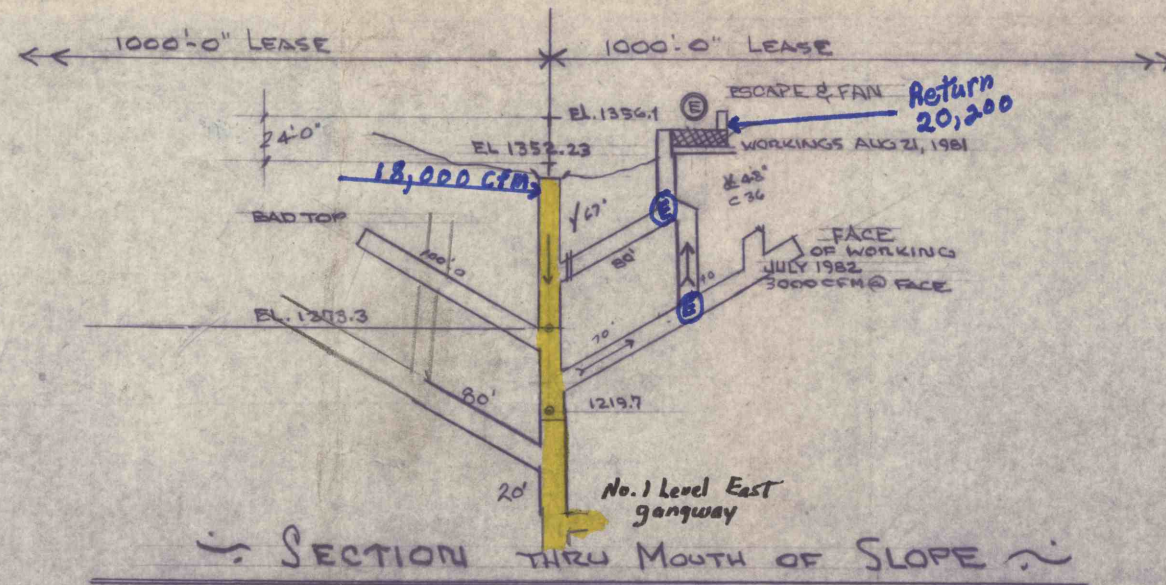

6-10-84

LEGEND

←→	AIR INTAKE
←→	AIR RETURN
—	PERMANENT STOPPING
- - -	TEMPORARY STOPPING
—	MAIN FAN
—	ESCAPE
—	PUMP

Skyline COAL CO. - No. 1 Slope

I.D. No. 36-07129

No. 3 VEIN SPLIT TREVERTON

ZERBE TWP. SCALE 1"=100'-0"