

READING ANTHRACITE CO.


West fan is a 45" dia barrel fan with no name plate, driven by a 15 hp, 440 volt, 875 r.p.m. motor, w.g. = 1.5

East fan is a 36" dia centrifugal fan American Blower Corp, driven by a 10 hp, 440 volt, 1160 r.p.m. motor, w.g. = 2.0

Note B.M. 8 = 8632
ch./boulder
1599.5
T.P. = S. 5,054.17
W. 31,105.22

B.M. = 8634
ch./boulder
1599.5
T.P. = S. 4,947.57
W. 31,110.40

MINE MAP
for the
L.V. Coal Company
situate
Porter Twp., Schuylkill County
MSHA I.D. # 36-08014

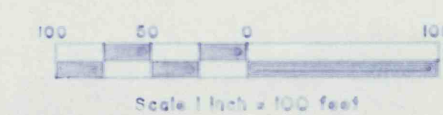

David L. Williams

MINE MAP

Showing the location and extent of development of the LV Coal Company's No. 4 Slope. Situate on the north dip Lykens Valley No. 4 Vein, Porter Township, Schuylkill County, PA

David L. Williams, P.E. January 27, 1993
I.D. #36-08014 Scale: 1" = 100'