


5/21/92

1515

FOUR STAGES OF MINING PROJECTED

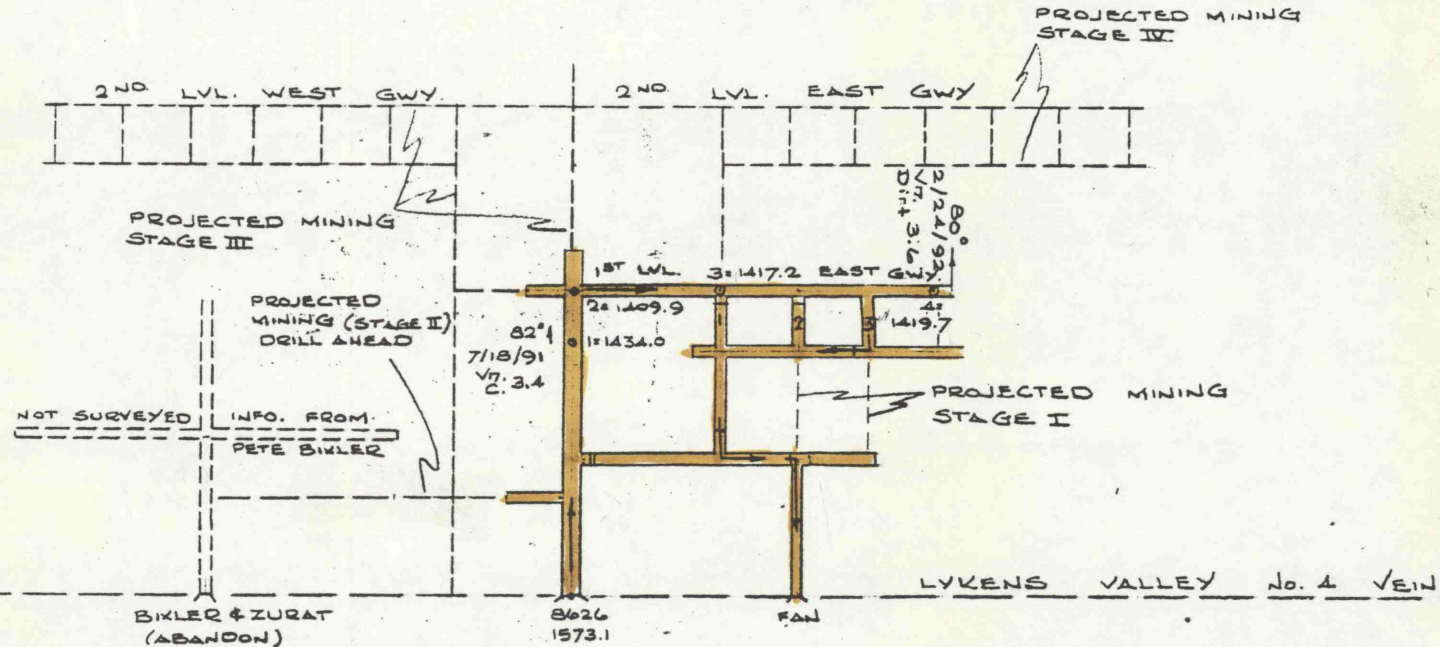

MSHA I.D.# 36-08014

SCALE: 1" = 100'

ON VEIN SECTION or VIEW OF THE
LV COAL COMPANY's No. 4 Slope

David L. Williams