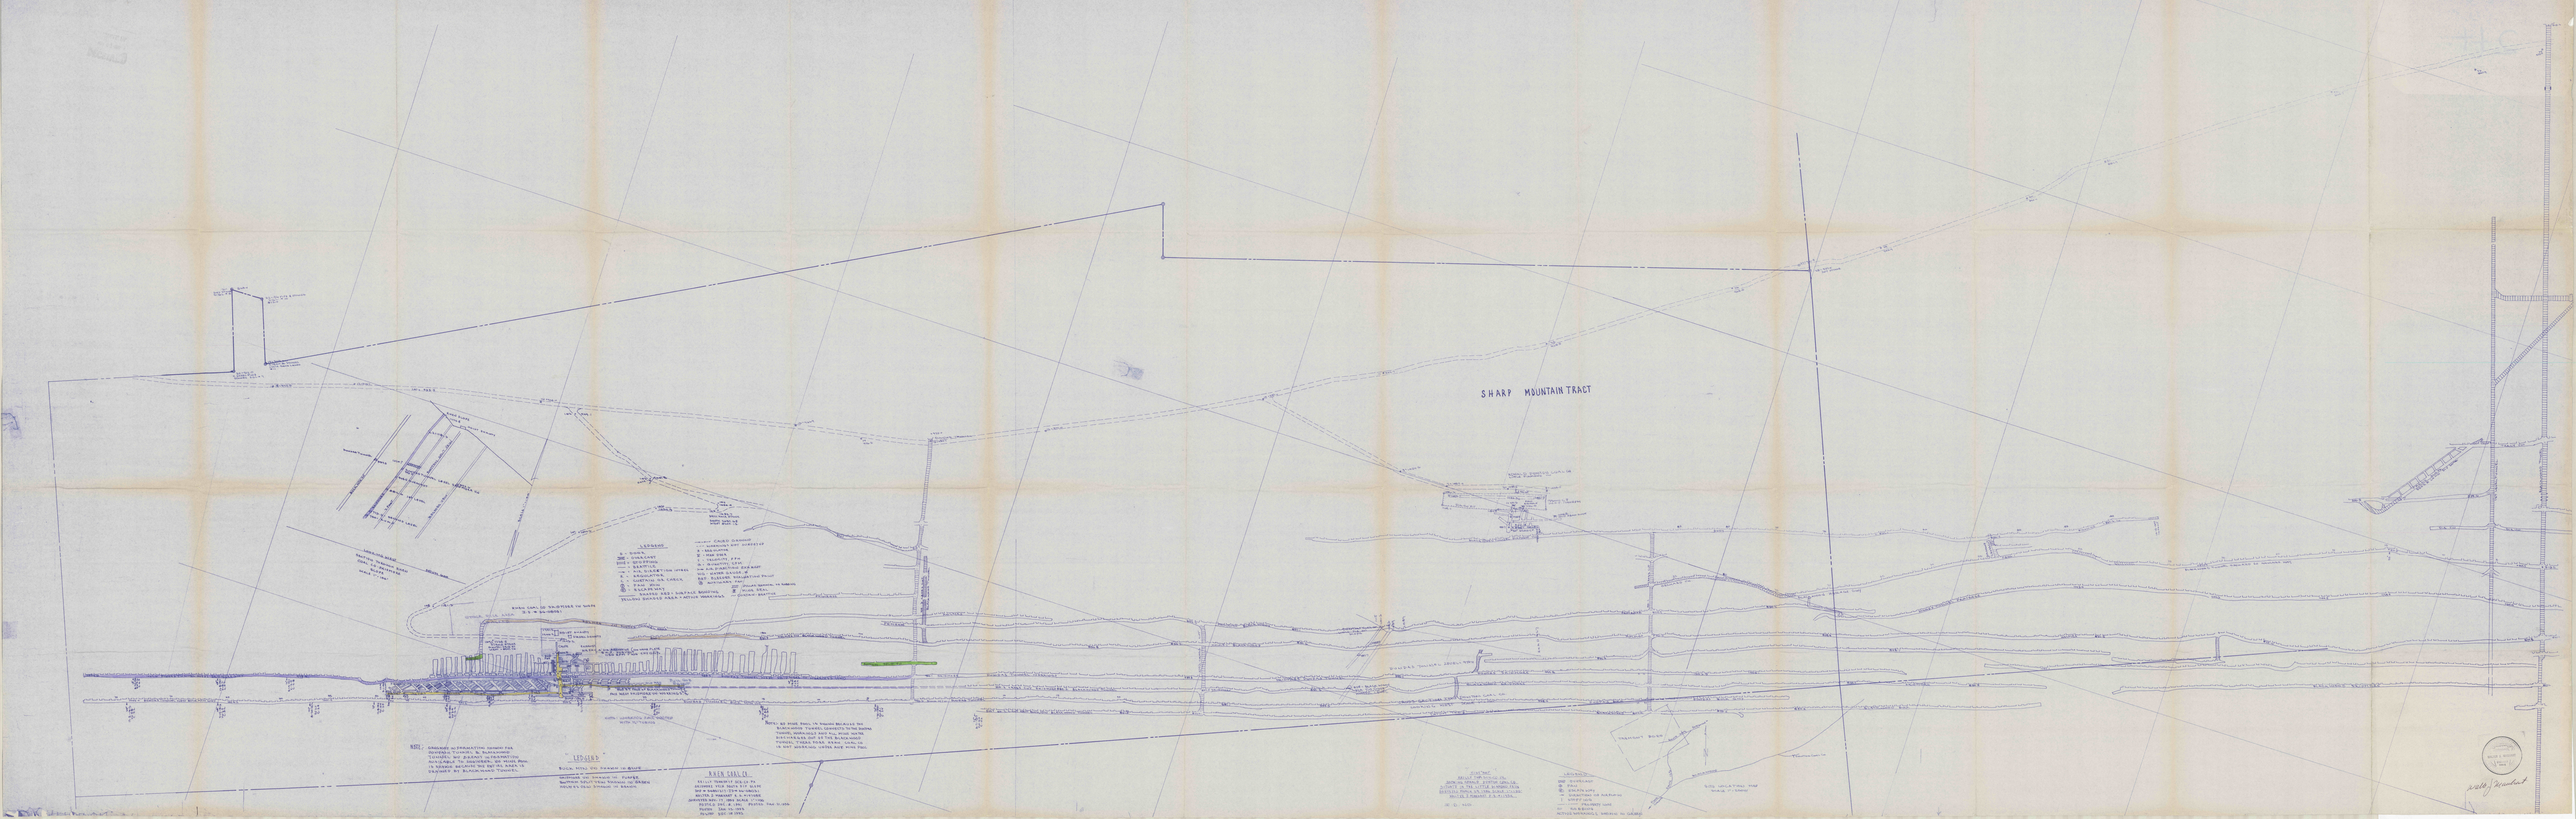
SHARP MOUNTAIN TRACT