

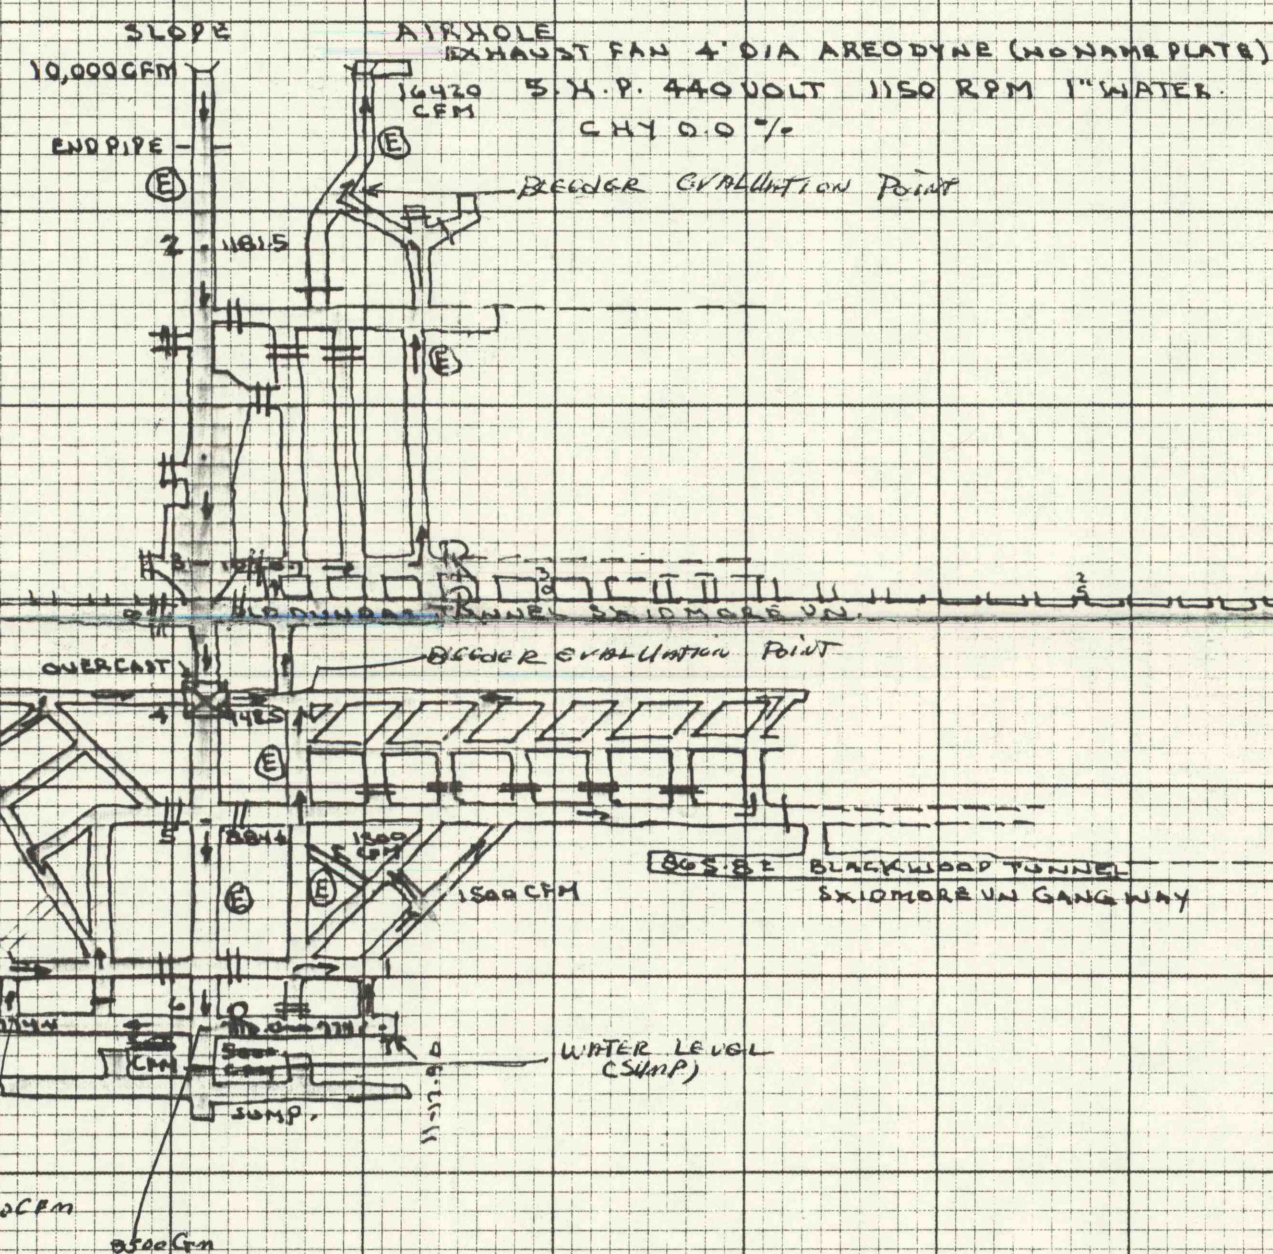


REHN COAL CO. SKIDMORE V.N. SLOPE
I.D. # 36-08031

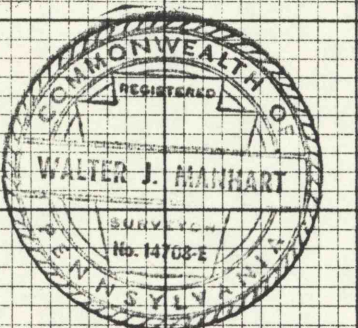

NOTE: NO MINE ROAD IS SHOWN BECAUSE THE BLACKWOOD TUNNEL CONNECTS TO THE DUNDAS TUNNEL WORKINGS AND ALL MINE WATER DISCHARGES OUT OF THE BLACKWOOD TUNNEL.

BLACKWOOD TUNNEL LEVEL

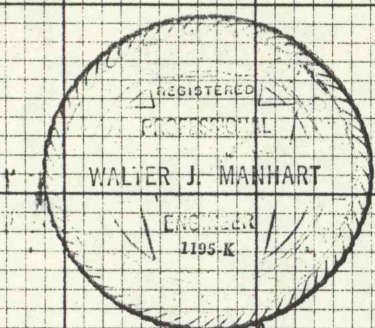

Walter J. Manhart
LEGEND

- AIR FLOW
- || = PERMANENT STOPPING
- | = TEMPORARY STOPPING
- ⊙ = ESCAPE WAY
- ⊕ = SURFACE FAN
- ⊞ = OVERCAST
- R = REGULATOR
- C = CURTAIN OR CHECK
- D = DOOR
- AREA SHADED YELLOW = ACTIVE WORKINGS

SECTIONAL VIEW

REHN COAL CO.

REILLY TOWNSHIP SCH. CO. PA.
SKIDMORE V.N. SOUTH DIP SLOPE
SMP-54851517-I.D. # 36-08031
WALTER J. MANHART R.S. # 14702
SURVEYED NOV. 17, 1930 SCALE 1"=100'

DATUM

1538