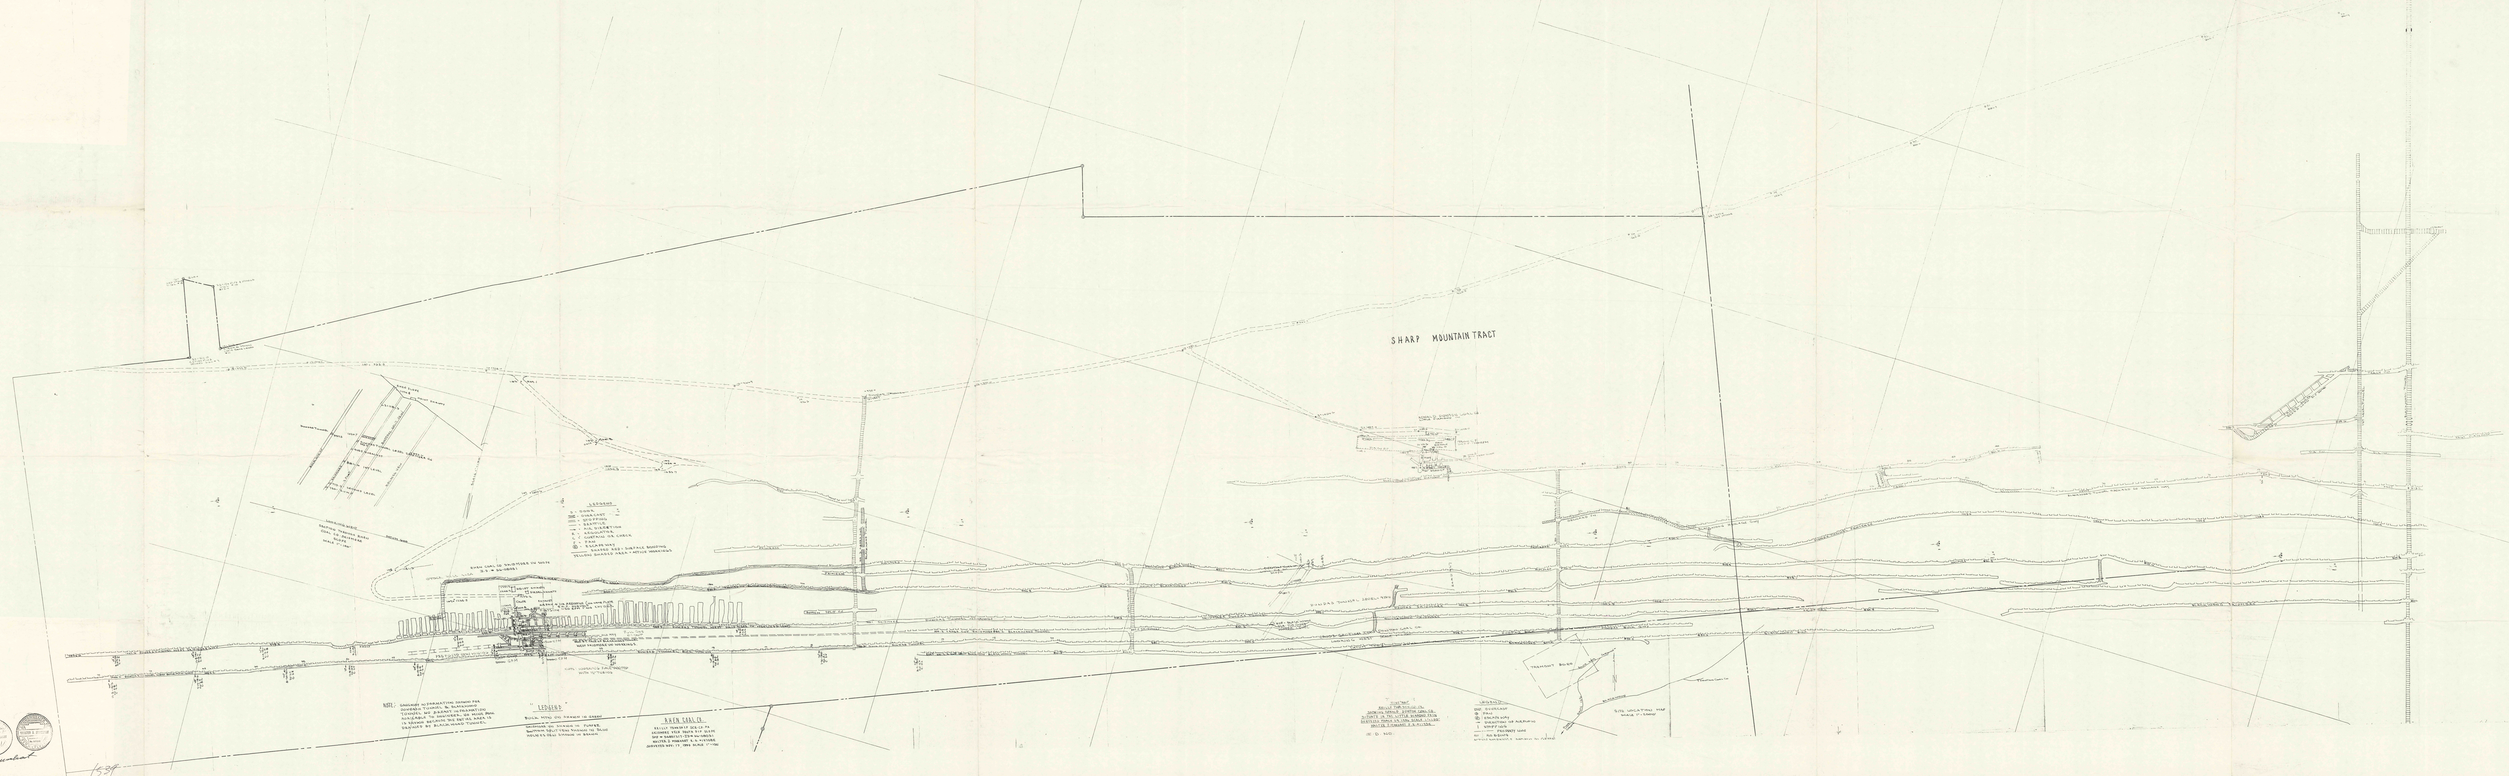
SHARP MOUNTAIN TRACT
LEGEND
NOTE:
LEGEND
NORTH SEAL CO.
LEGEND
SITE LOCATION MAP