



RENN COAL CO. SKIDMORE V.N. SLOPE
I.D. # 36-08031

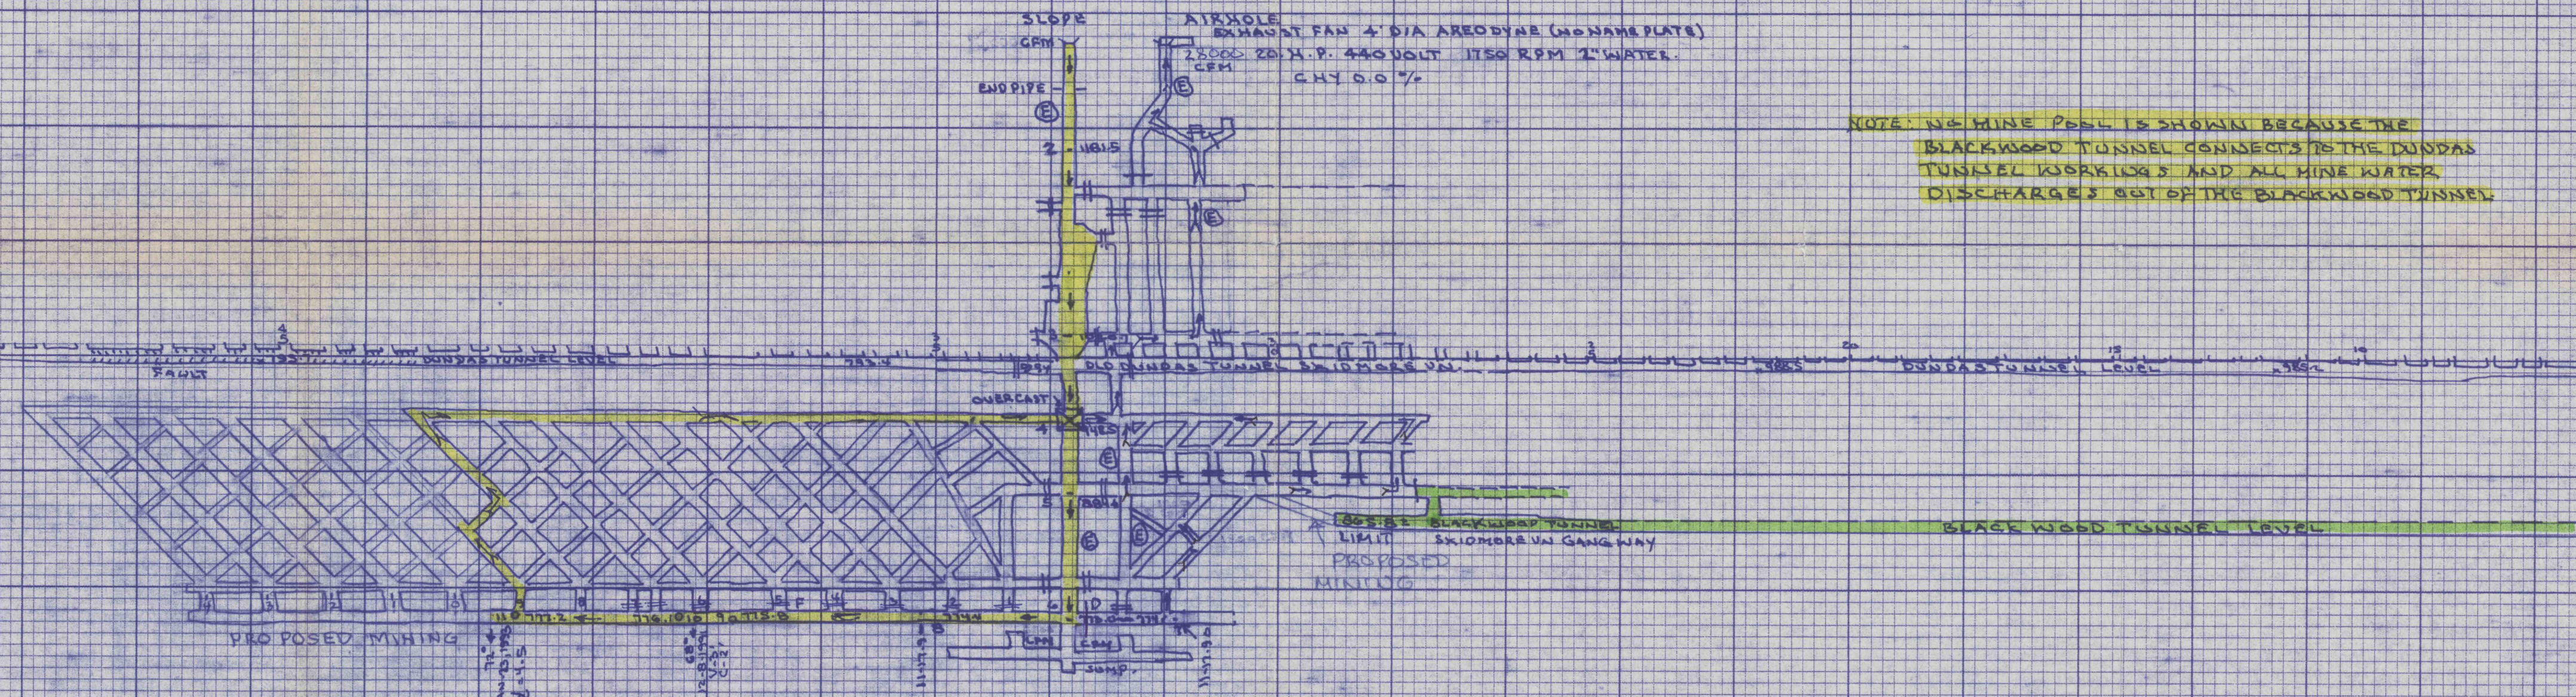

NOTE: NO MINE POOL IS SHOWN BECAUSE THE BLACKWOOD TUNNEL CONNECTS TO THE DUNDAS TUNNEL WORKINGS AND ALL MINE WATER DISCHARGES OUT OF THE BLACKWOOD TUNNEL.

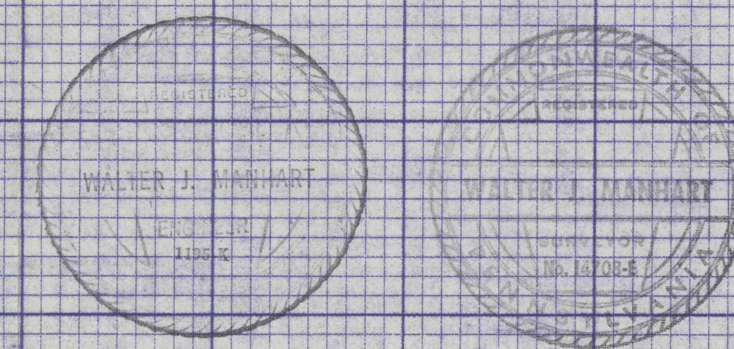

Walter J. Manhart

VENTILATION MAP
SECTIONAL VIEW
RENN COAL CO.

RENN TOWNSHIP SCH. CO. PA
SKIDMORE V.N. SOUTH DIP SLOPE
SMP# 5485517-I.D. # 36-08031
WALTER J. MANHART R.S. # 10785
SURVEYED NOV. 14, 1985 SCALE 1"=100'
POSTED DEC. 9, 1985
POSTED JAN. 25, 1986

- LEGEND**
- ↔ AIR FLOW RETURN
 - ↔ AIR FLOW INTAKE
 - II = PERMANENT STOPPING
 - I = TEMPORARY STOPPING
 - ⊕ = ESCAPE WAY
 - ⊙ = SURFACE FAN
 - ⊞ = OVERCAST
 - R = REGULATOR
 - C = CURTAIN OR CHECK
 - D = DOOR
 - AREA SHADED YELLOW = ACTIVE WORKINGS
 - ⊙ = AUXILIARY FAN
 - ⊞ = MAN DOOR
 - ✓ VELOCITY FPM
 - ⊞ = GUARD FAN
 - WG = WATER GAUGE IN
 - BP = BLEEDER EVALUATION POINT
 - ⊞ = PILLAR REMOVAL OR ROBBING
 - ⊞ = MINE SEAL
 - ⊞ = DATUM
 - ACTIVE WORKINGS
 - WORKINGS NOT SURVEYED
 - x-x- CAVED GROUND