


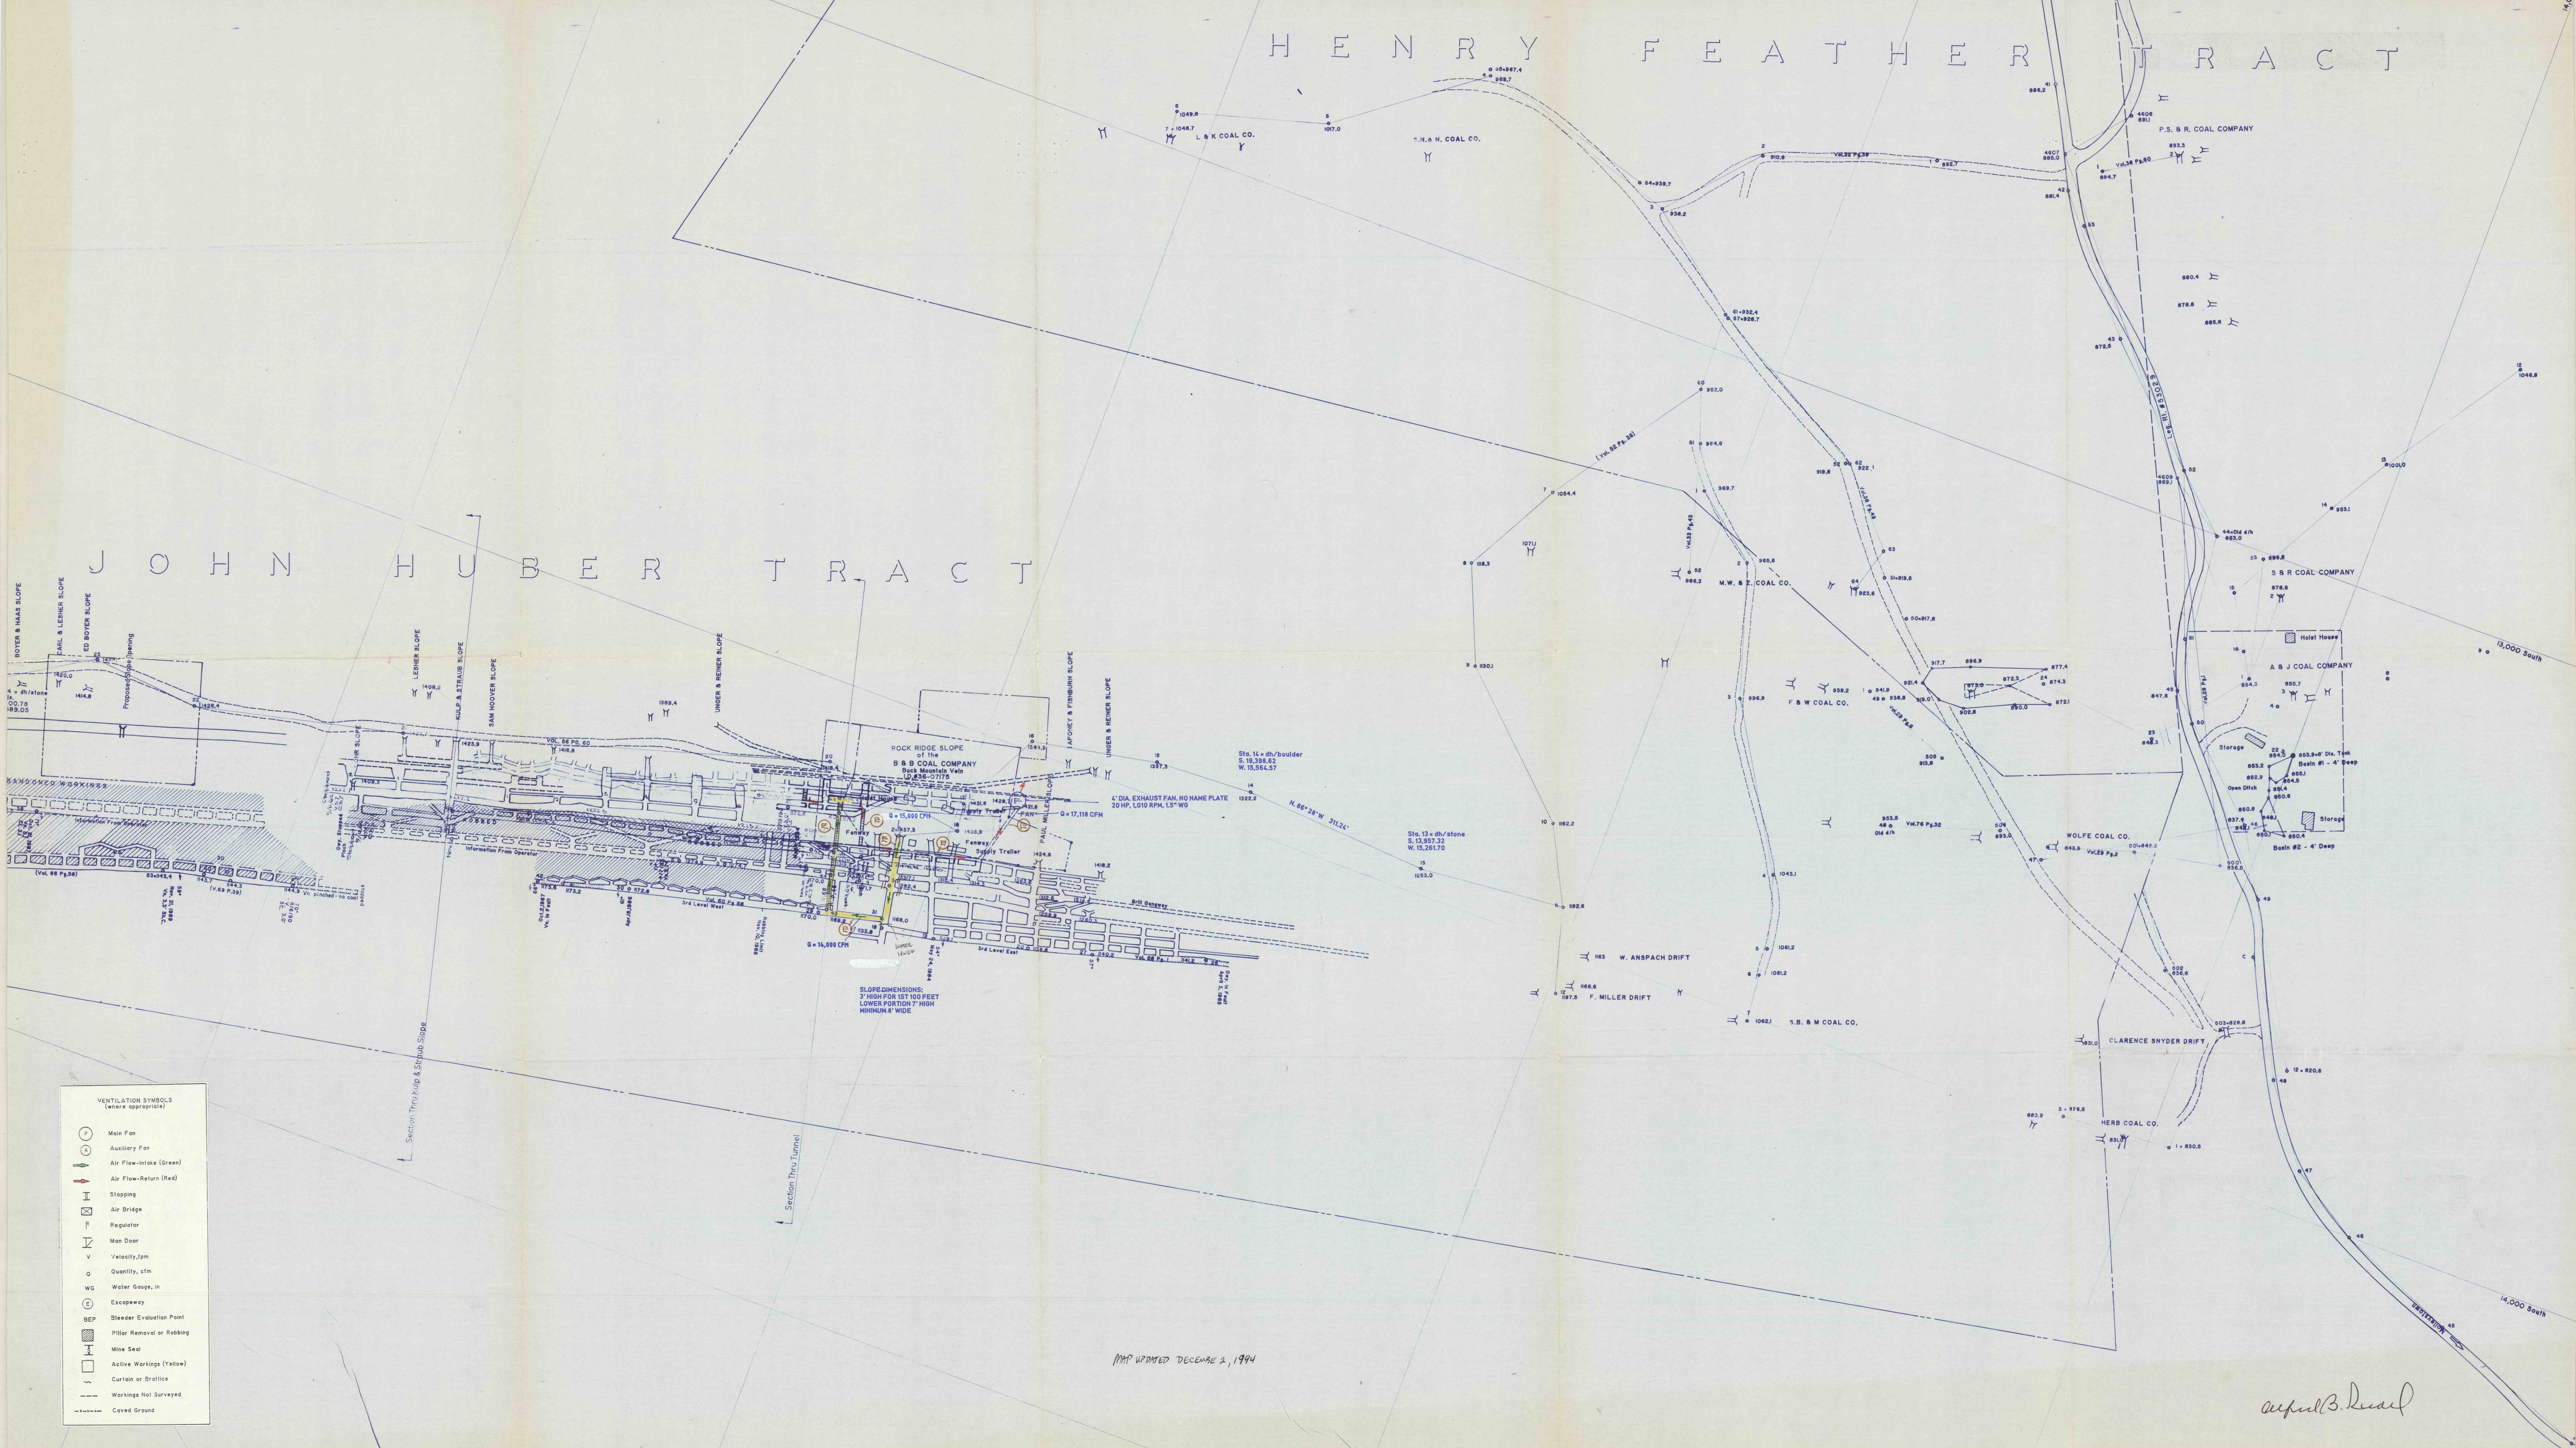

- VENTILATION SYMBOLS
(where appropriate)
- Main Fan
 - Auxiliary Fan
 - Air Flow-Intake (Green)
 - Air Flow-Return (Red)
 - Stopping
 - Air Bridge
 - Regulator
 - Man Door
 - Velocity, fpm
 - Quantity, cfm
 - Water Gauge, in
 - Escapeway
 - BEP
 - Pillar Removal or Robbing
 - Mine Seal
 - Active Workings (Yellow)
 - Curtain or Brattice
 - Workings Not Surveyed
 - Caved Ground

MAP UPDATED DECEMBER 2, 1994

as per B. Deal