

DECKERT WT.

PETER ECKERT

JOHN SCHALL WT.


JOHN HUBER WT.

SAMUEL HAIN WT.

WILLIAM GRAEFF WT.

VENTILATION SYMBOLS (where applicable)

|  |                           |
|--|---------------------------|
|  | Main Fan                  |
|  | Auxiliary Fan             |
|  | Air Flow-Intake (Green)   |
|  | Air Flow-Return (Red)     |
|  | Stopping                  |
|  | Air Bridge                |
|  | Regulator                 |
|  | Man Door                  |
|  | Velocity, fpm             |
|  | Quantity, cfm             |
|  | Water Gauge, in           |
|  | Escapeway                 |
|  | Bleeder Evaluation Point  |
|  | Pillar Removal or Robbing |
|  | Mine Seal                 |
|  | Active Workings (Yellow)  |
|  | Curtain or Brattice       |
|  | Workings Not Surveyed     |
|  | Caved Ground              |

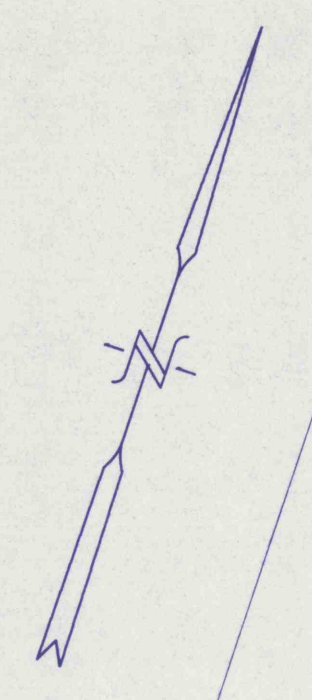

Scale 1" = 100'

**MINE MAP**  
 Showing the location and extent of development of the H L & W Coal Company slope mine. Situate on the south dip (inverted) Seven Foot vein, Tremont Township, Schuylkill County.  
 A. B. Riedel, P. E. Nov. 4, 1992  
 Scale 1" = 100'

*A. B. Riedel*

