


VENTILATION SYMBOLS
(where appropriate)

- (F) Main Fan
- (A) Auxiliary Fan
- Air Flow-Intake (Green)
- ← Air Flow-Return (Red)
- ⊥ Stopping
- ⊠ Air Bridge
- ⊞ Regulator
- ⊞ Water Gauge
- V Velocity, fpm
- Q Quantity, cfm
- WG Water Gauge, in
- (E) Escapeway
- BEP Bleeder Evaluation Point
- ▨ Pillar Removal or Robbing
- ⊞ Mine Seal
- ⊞ Active Workings (Yellow)
- ⊞ Curtain or Brattice
- Workings Not Surveyed
- ⊞ Caved Ground

LONGITUDINAL SECTION
thru
Mine Workings
of the
Jeff Coal Company

100 50 0 100
Scale 1 inch = 100 feet

Arthur B. Lusk

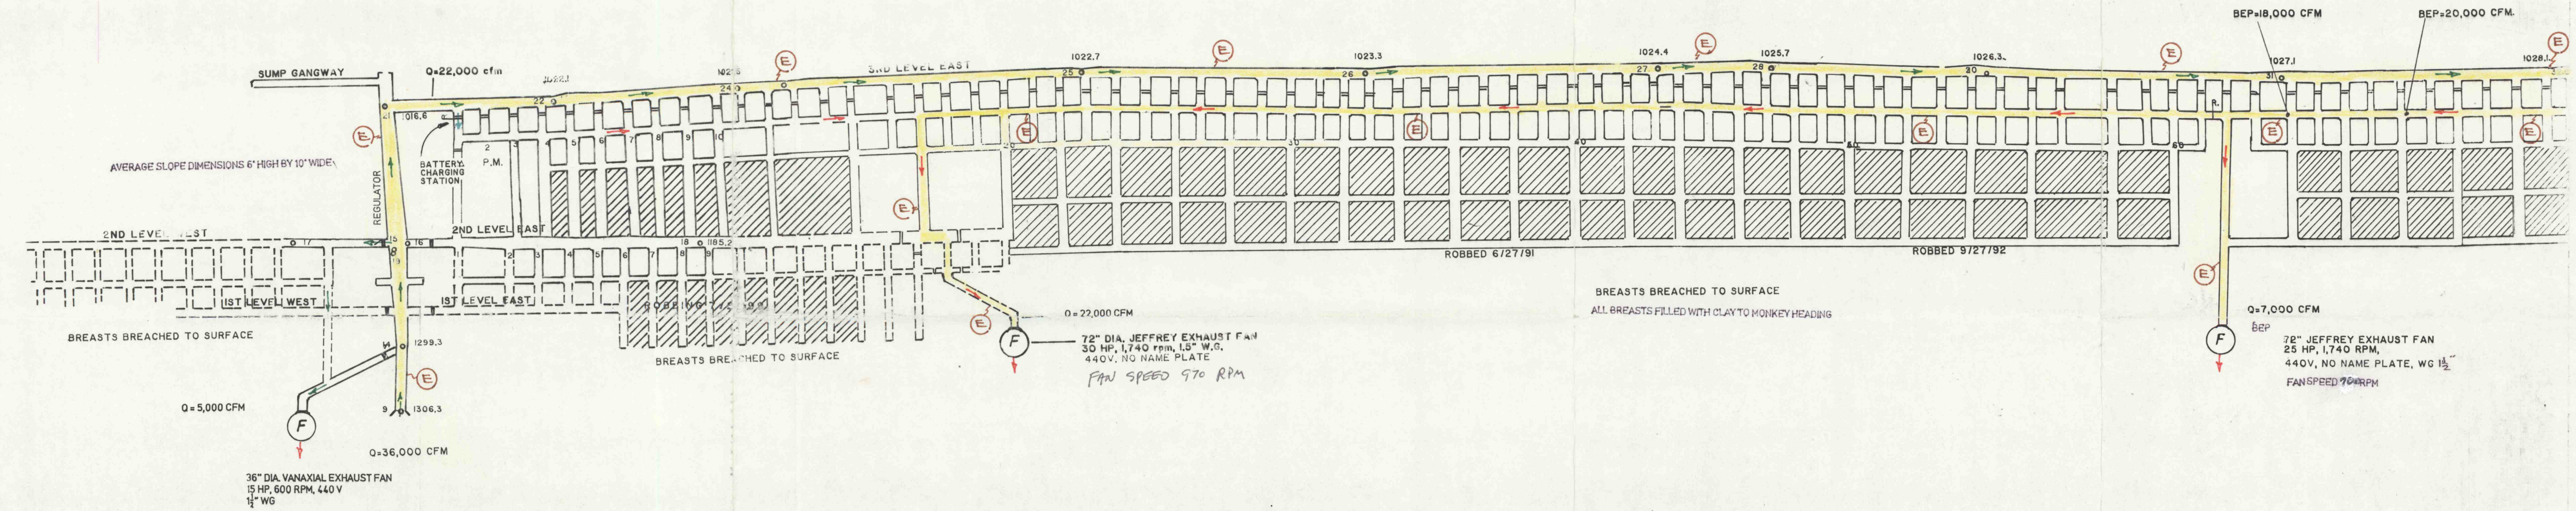

MATCH LINE SHEET No. 2