



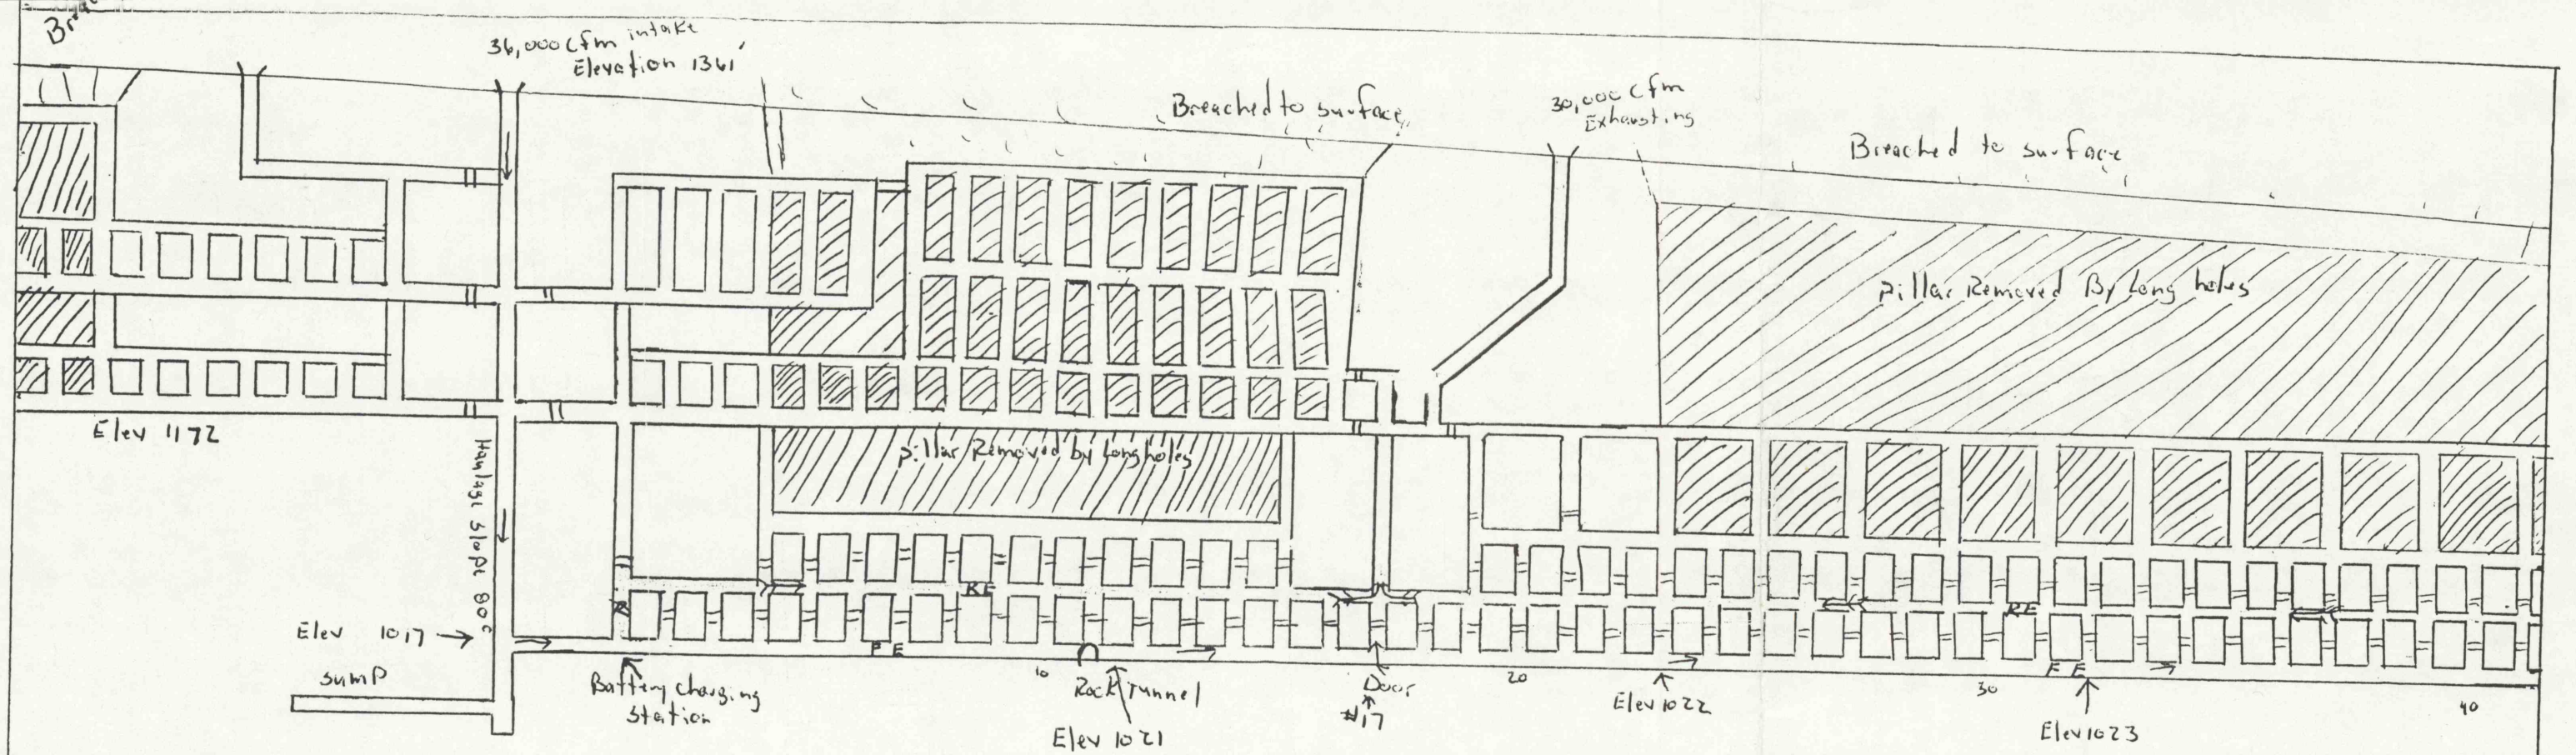

- Legend
- || Permanent stopping
 - | Temporary stopping
 - △ Rock Tunnel @ #11
 - R Regulator

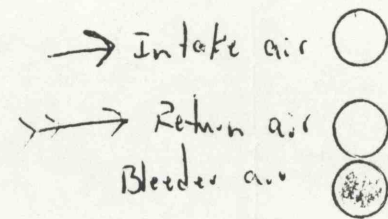

RE Return Escapeway
 FE Fresh Air Escapeway

RECEIVED

NOV 20 1992

U.S. DEPT. OF LABOR
 MSHA
 WILKES-BARRE, PA

RECEIVED

OCT 30 1992

ANTISVILLE, PA

Jeff Coal Company
 Tracey vein slope mine
 ID# 36-07328
 "In Vein View" mine
 Ventilation & Projections

scale 1" = 100' 9/28/92

1603