



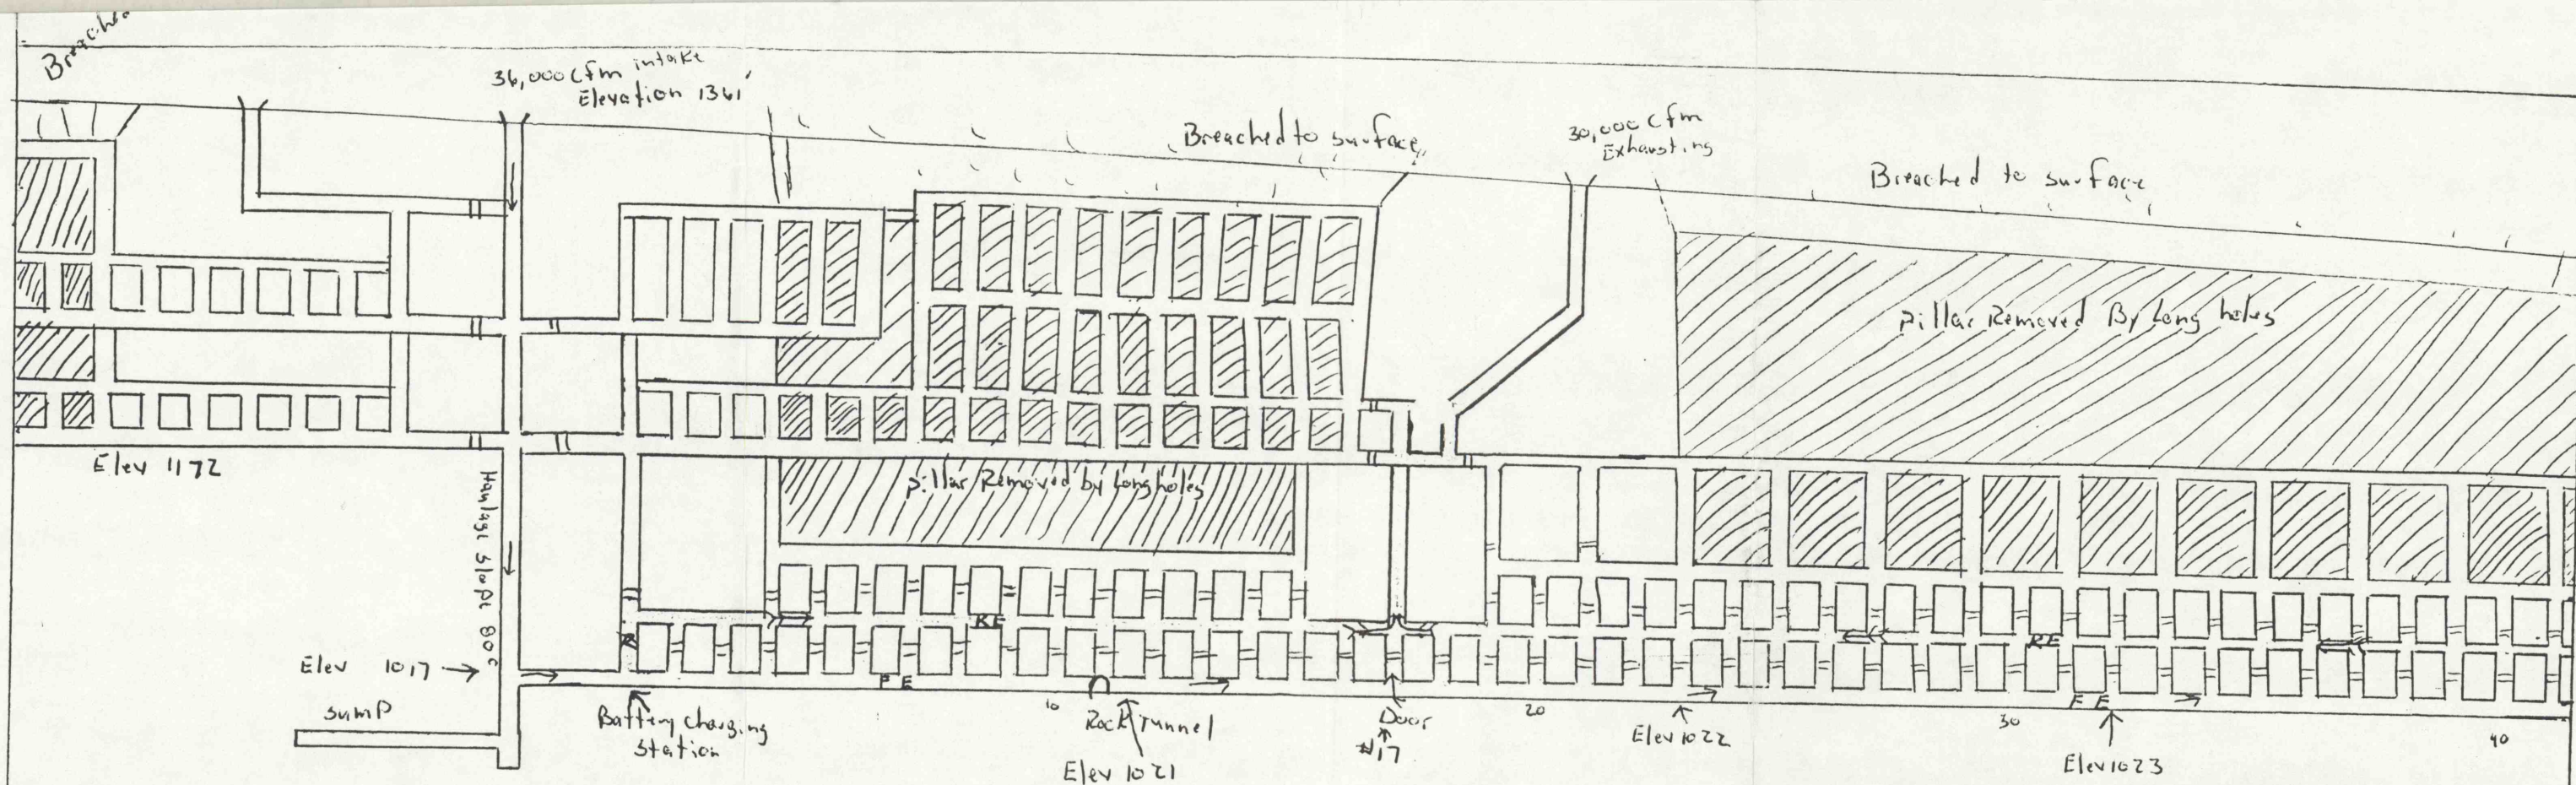

- Legend
- 11 Permanent stoppings
 - 1 Temporary stoppings
 - △ Rock Tunnel @ #11
 - R Regulator

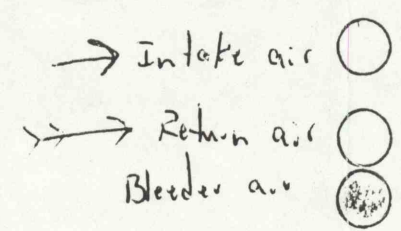

RE Return Escapeway
FE Fresh Air Escapeway

RECEIVED

NOV 20 1992

U.S. DEPT. OF LABOR
MSHA
WILKES-BARRE, PA.

RECEIVED

OCT 9 1992

JOHNSVILLE, PA.

Jeff Coal Company
Tracey Vein slope mine
ID# 36-07328
"In Vein View" mine
Ventilation & Projections
scale 1" = 100' 9/28/92