


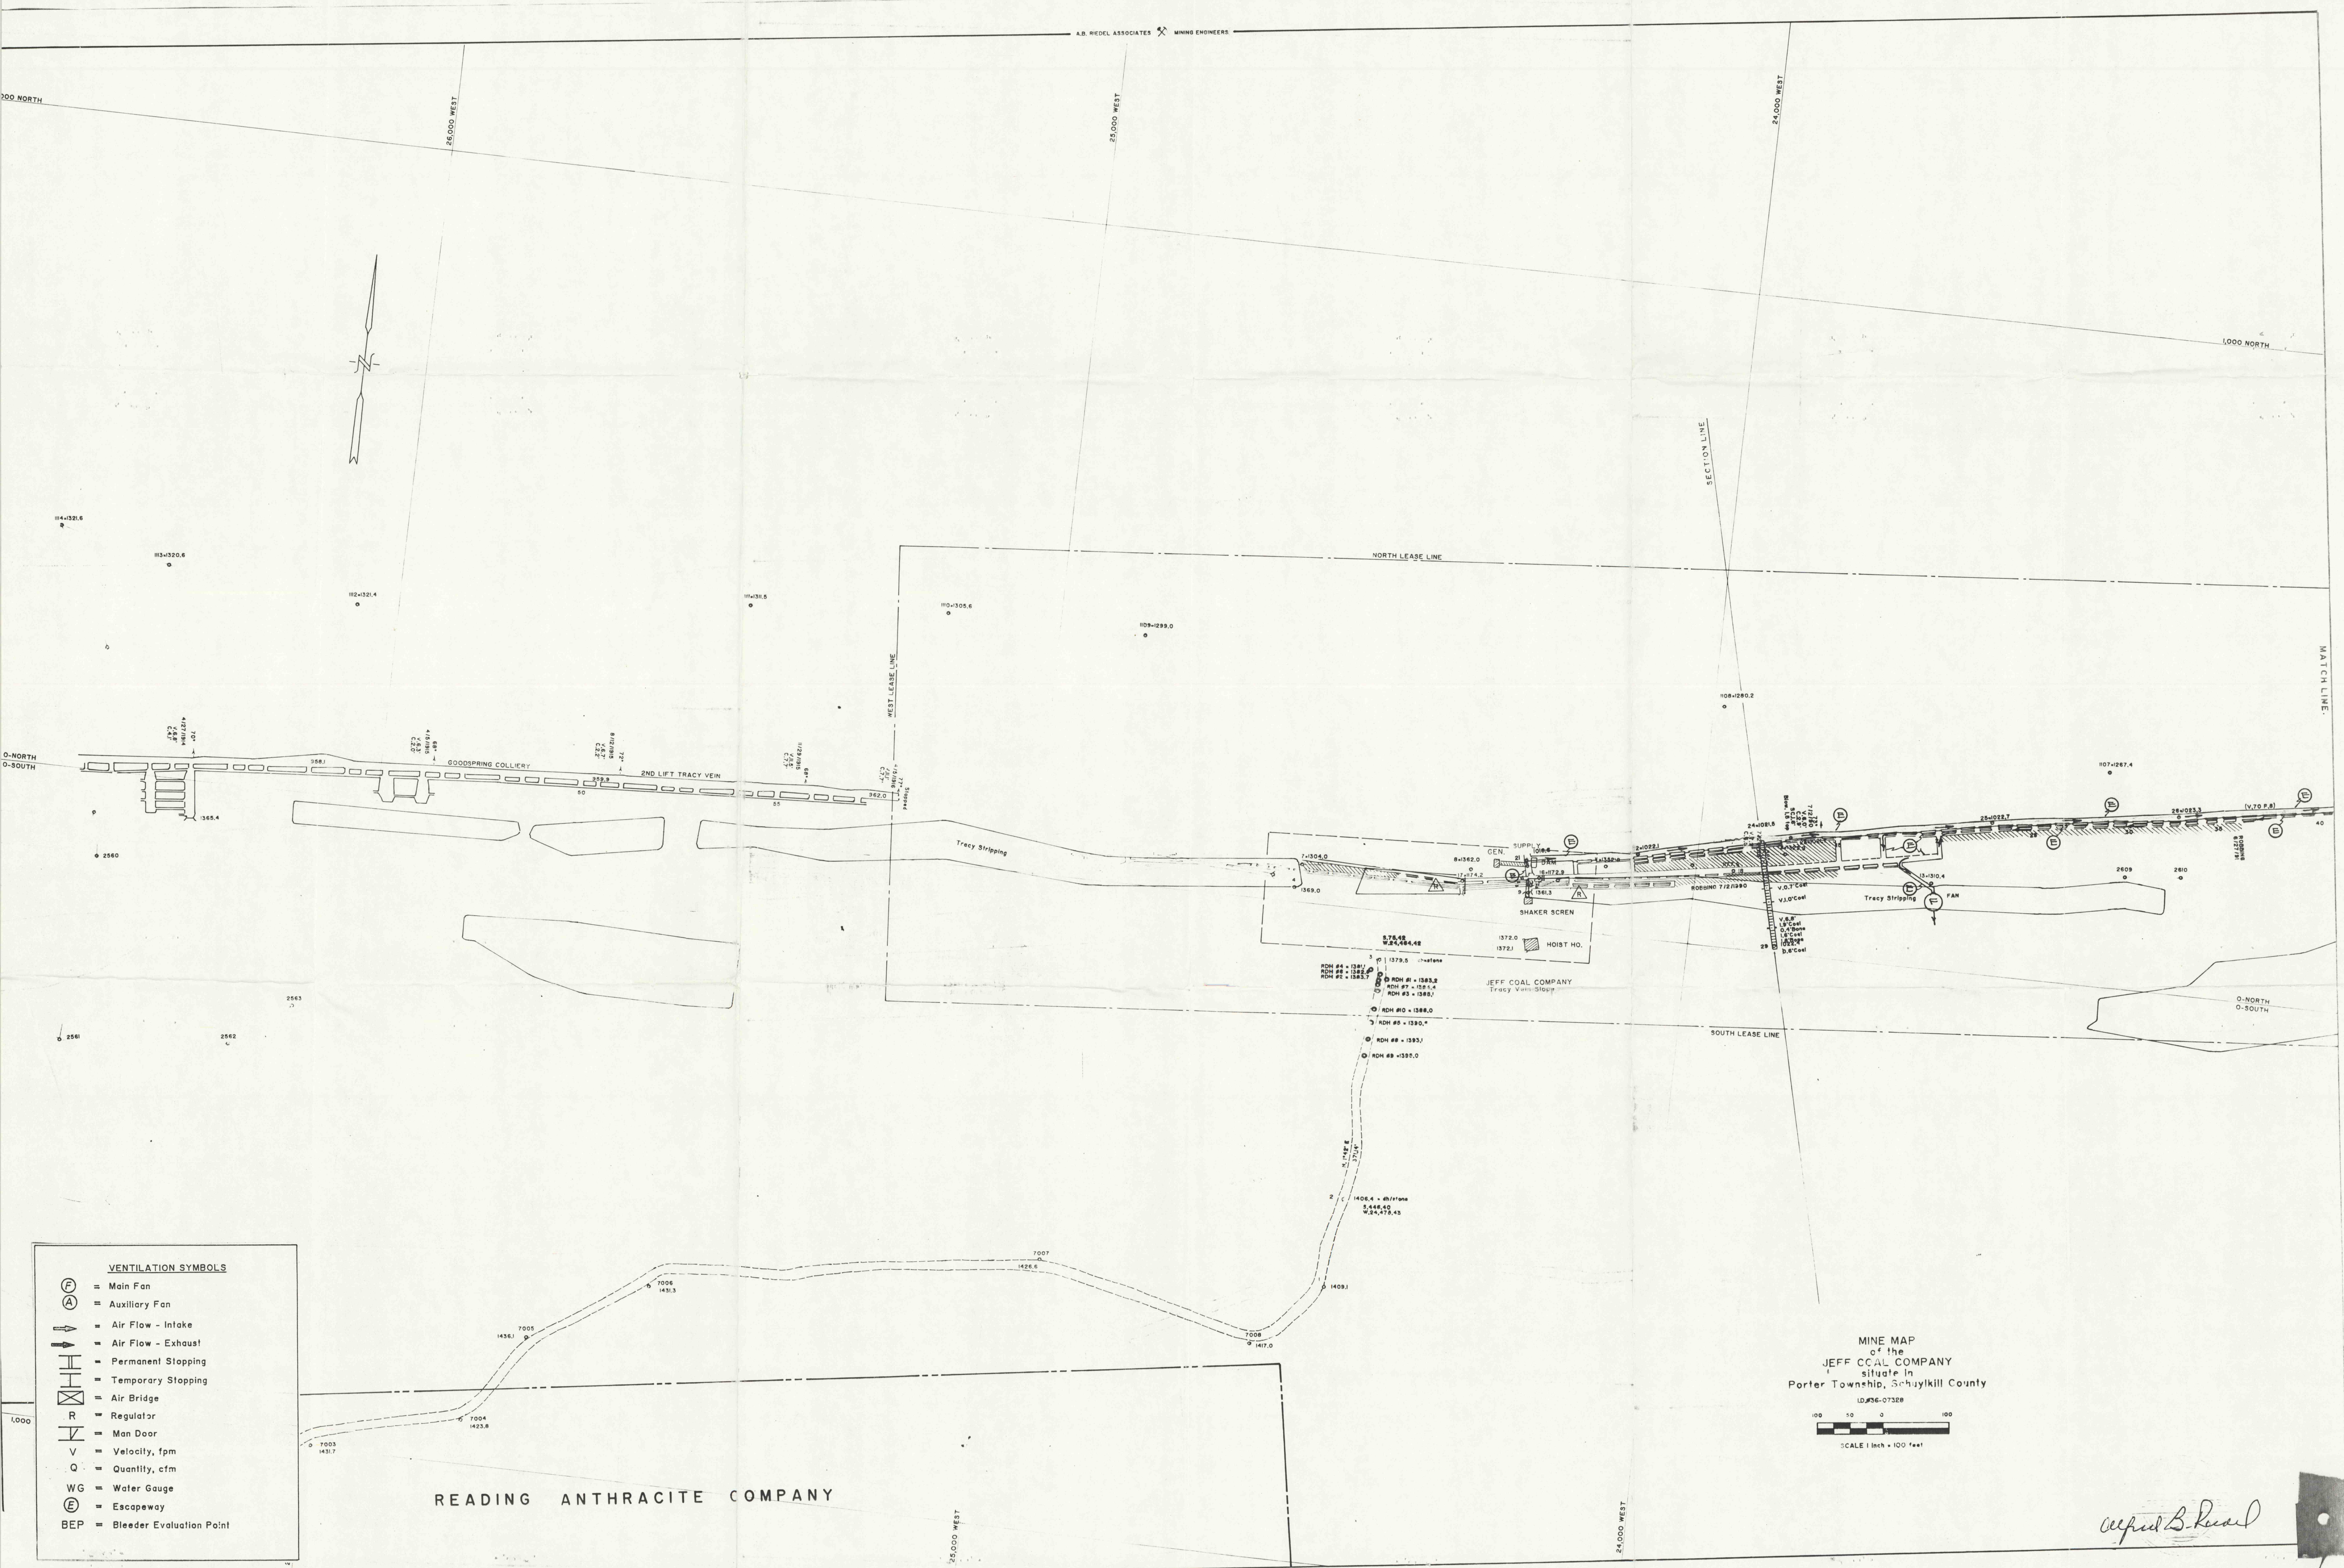

- VENTILATION SYMBOLS**
- ⊙ = Main Fan
 - ⊙ = Auxiliary Fan
 - = Air Flow - Intake
 - = Air Flow - Exhaust
 - = Permanent Stopping
 - = Temporary Stopping
 - ⊗ = Air Bridge
 - R = Regulator
 - = Man Door
 - V = Velocity, fpm
 - Q = Quantity, cfm
 - WG = Water Gauge
 - ⊕ = Escapeway
 - BEP = Bleeder Evaluation Point

READING ANTHRACITE COMPANY

MINE MAP
of the
JEFF COAL COMPANY
situate in
Porter Township, Schuylkill County
ID.#36-07328
SCALE 1 inch = 100 feet

Arthur B. Reed